



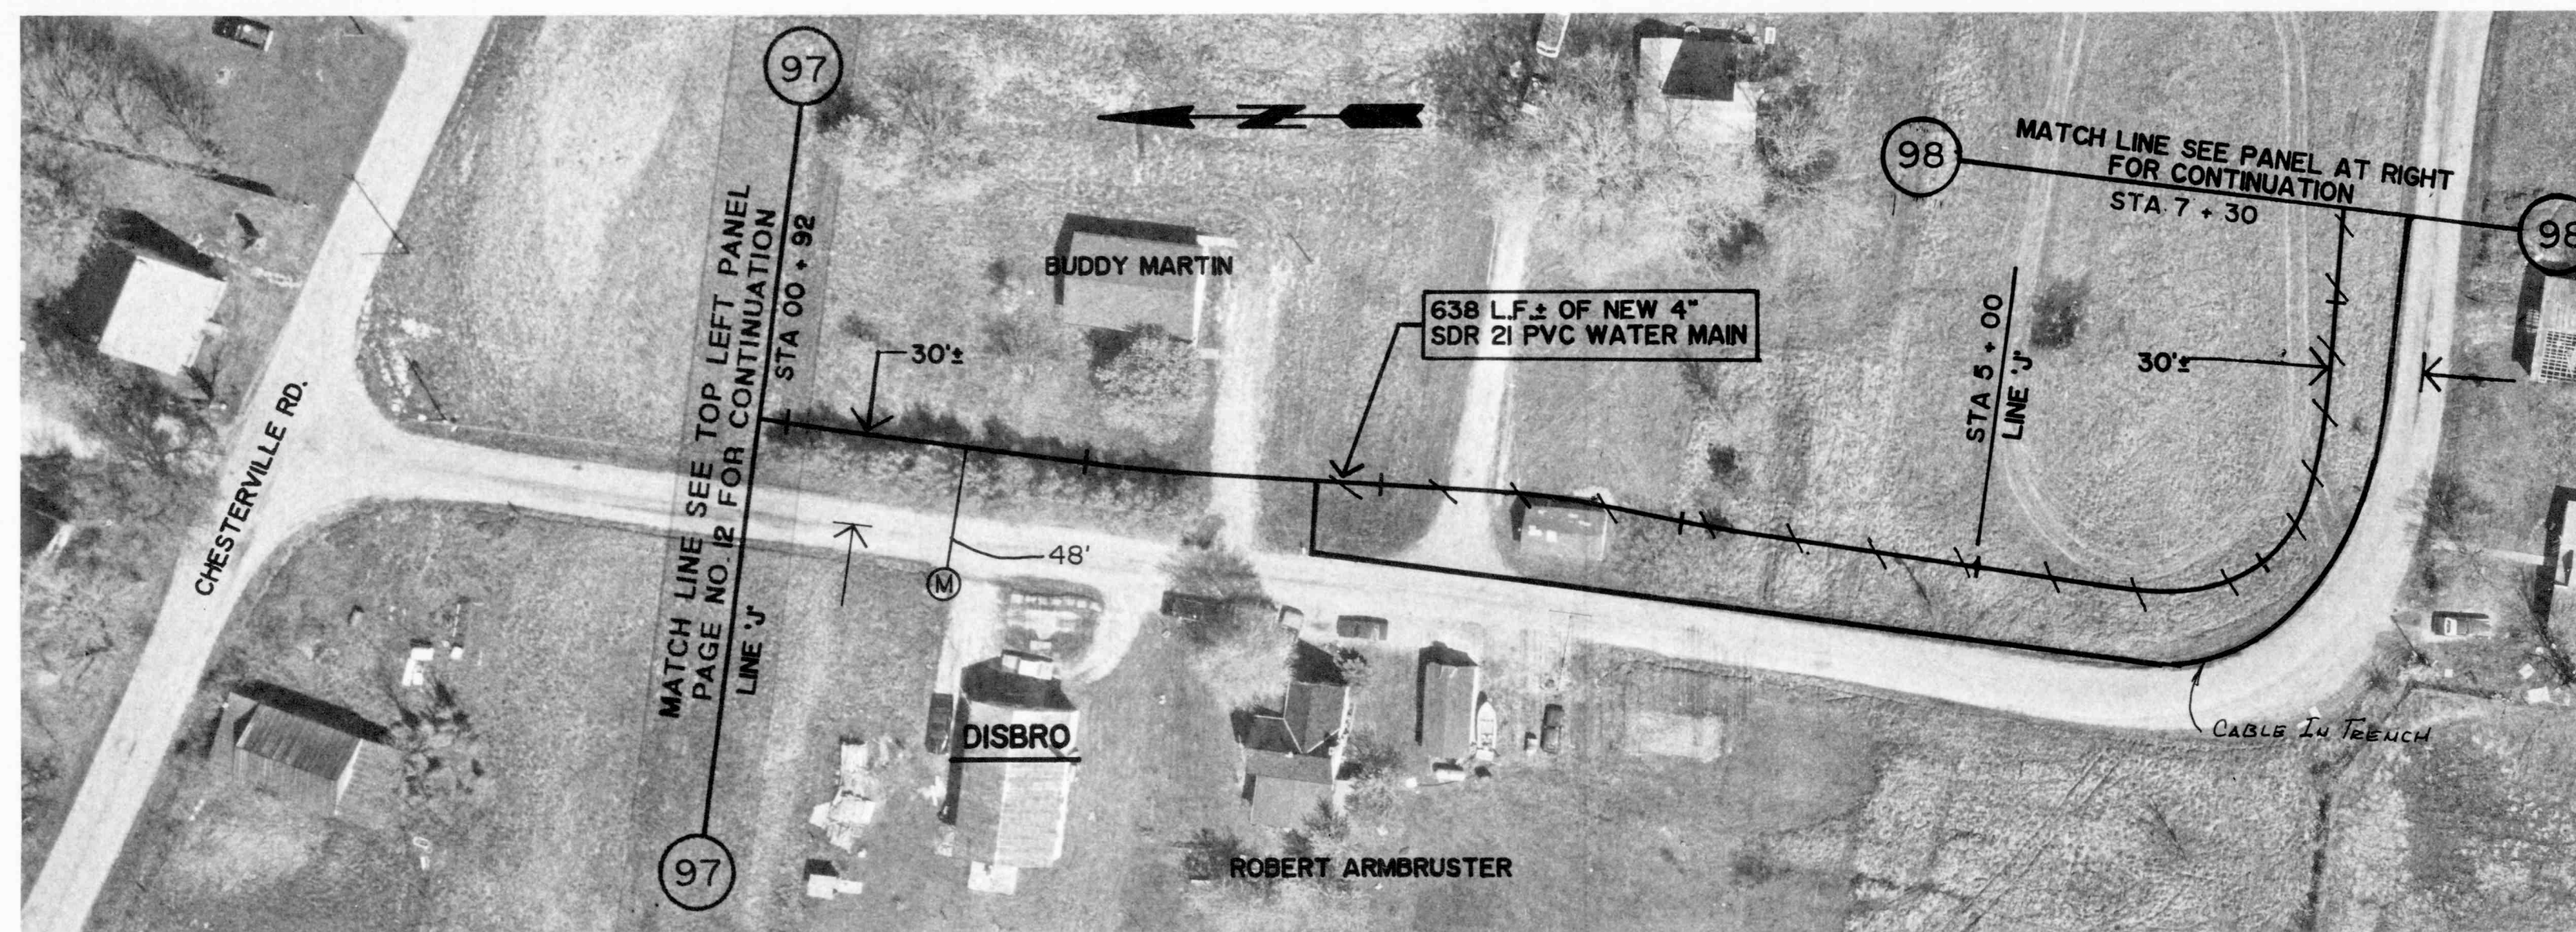

GROUND ELEV. = 878.0 ±
MAX. STATIC PRESS. = 122.1 PSI ±
REDUCED PRESS. 62.1 PSI ±

LONG BRANCH ROAD


GROUND ELEV. = 880.0 ±
MAX. STATIC PRESS. = 121.2 PSI ±
REDUCED PRESS. 61.2 PSI ±

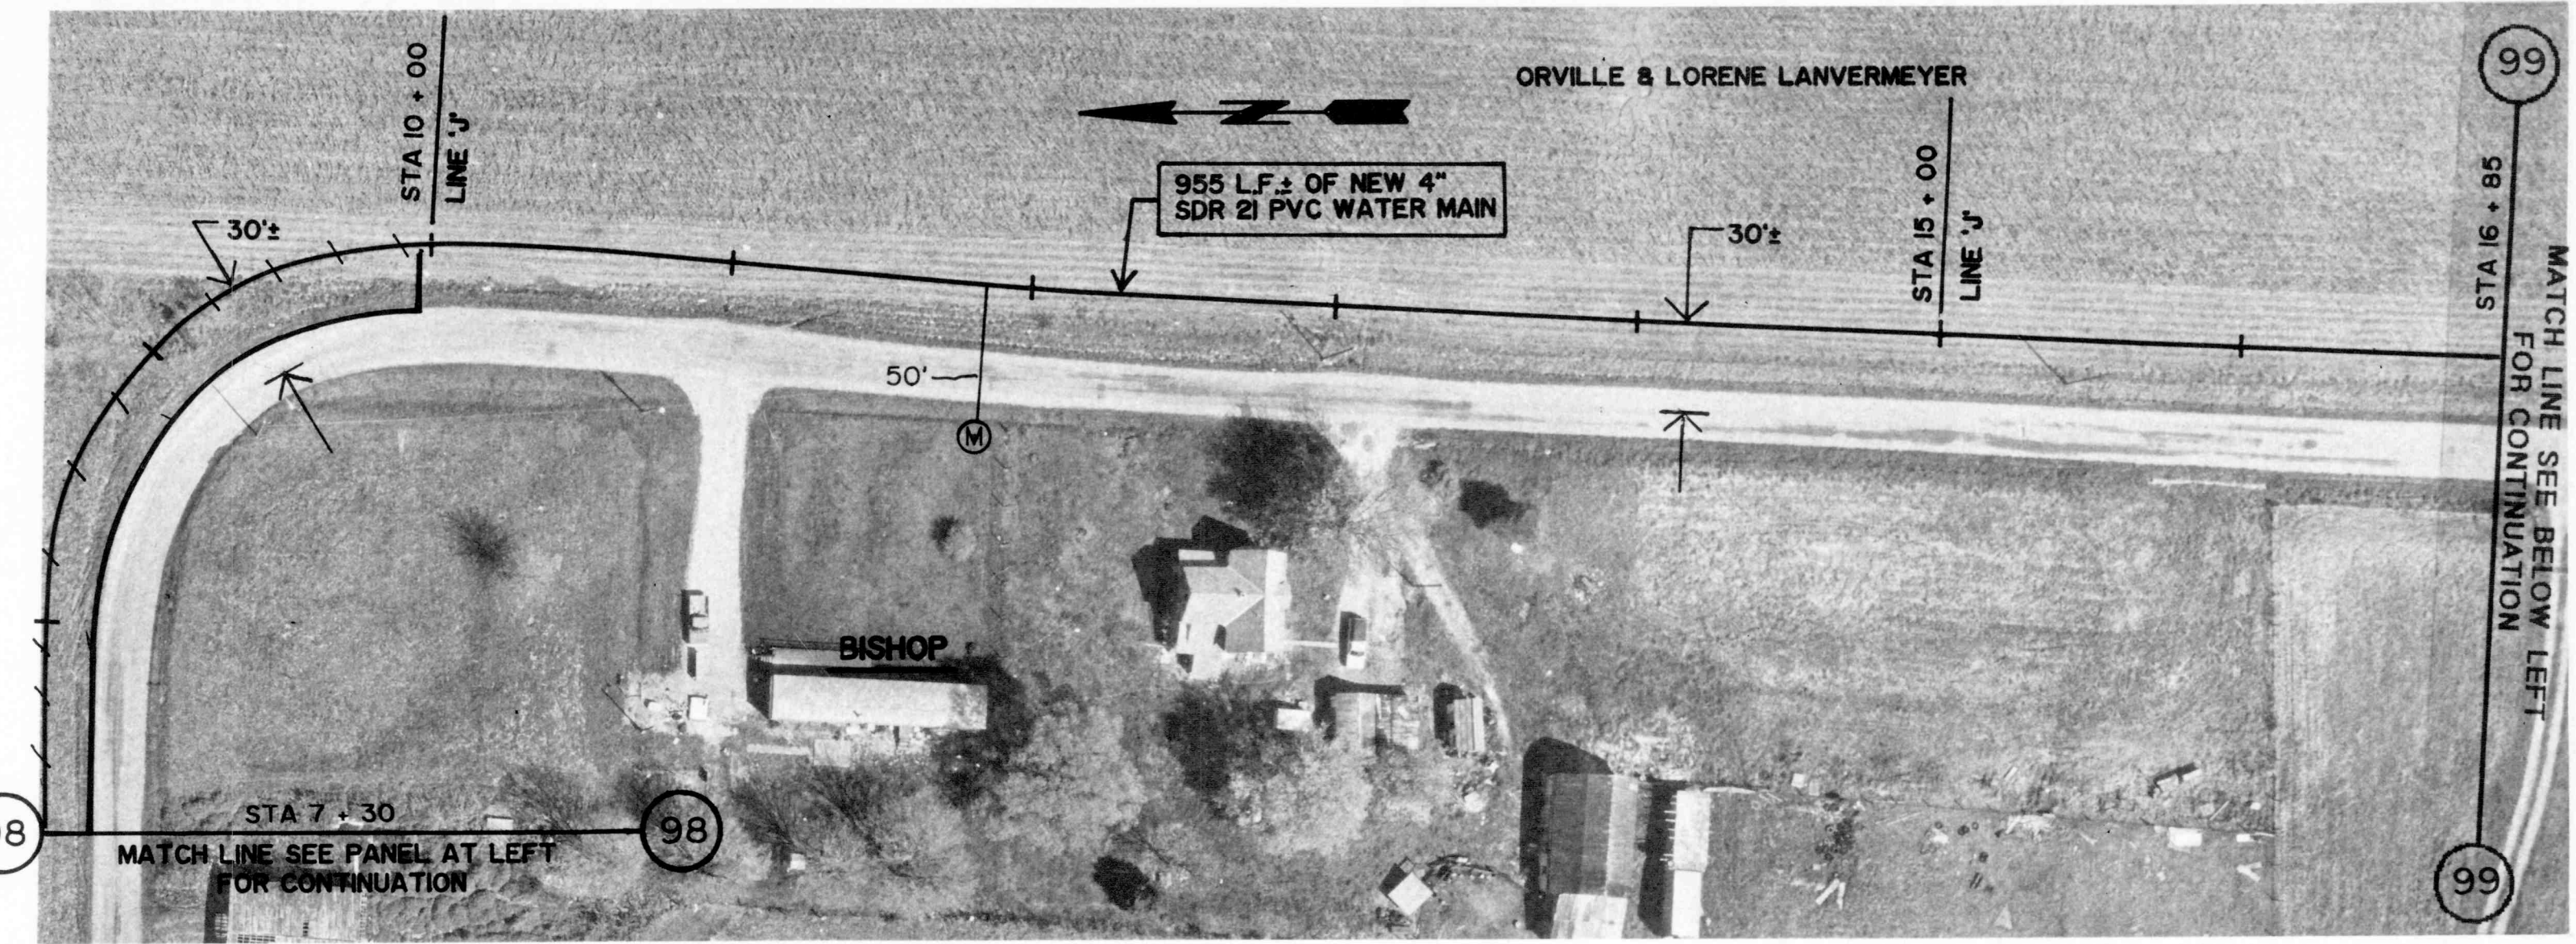

GROUND ELEV. = 880.0 ±
MAX. STATIC PRESS. = 121.2 PSI ±
REDUCED PRESS. 61.2 PSI ±

LONG BRANCH ROAD


GROUND ELEV. = 874.0 ±
MAX. STATIC PRESS. = 123.8 PSI ±
REDUCED PRESS. 63.8 PSI ±

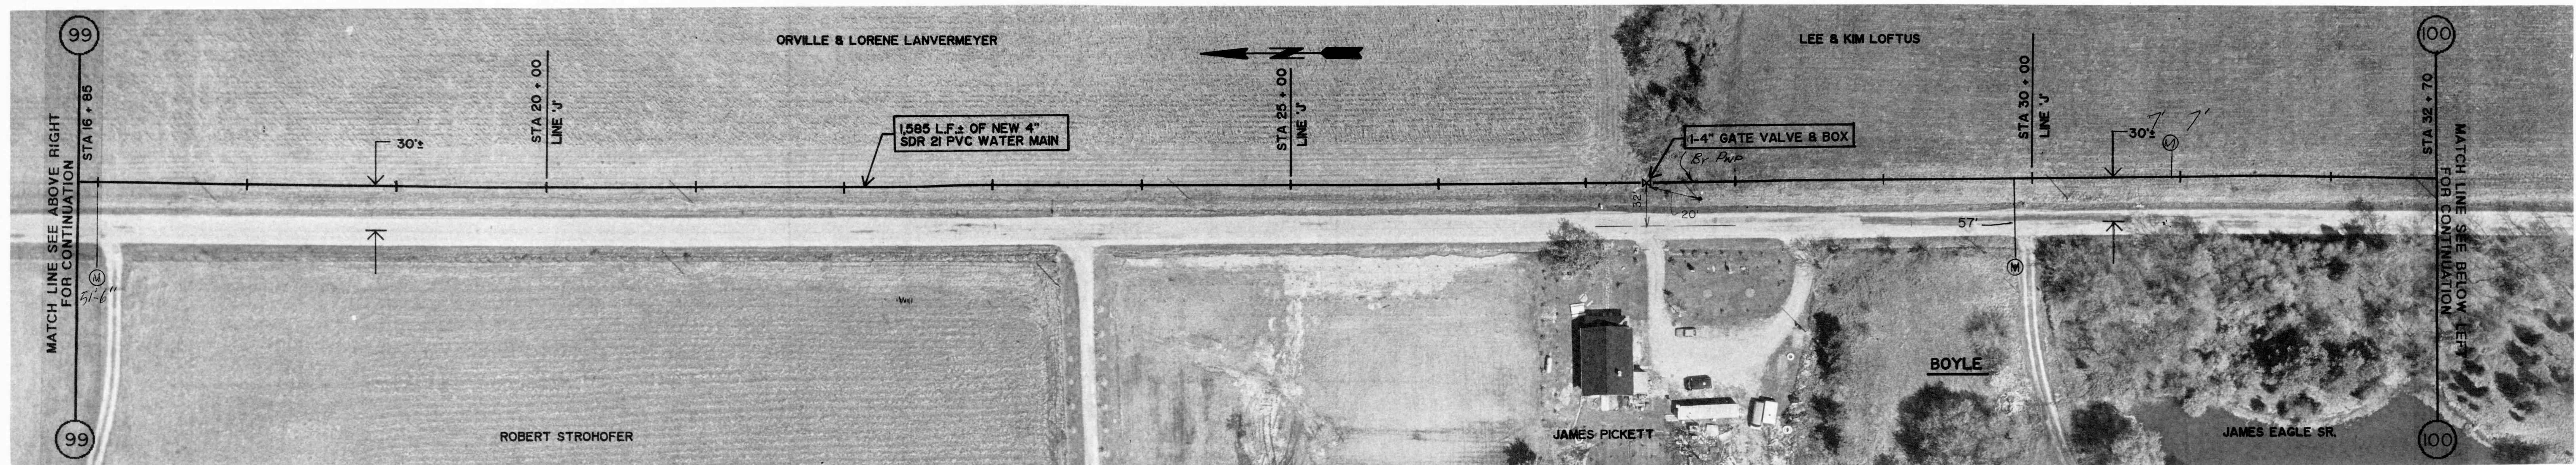

GROUND ELEV. = 874.0 ±
MAX. STATIC PRESS. = 123.8 PSI ±
REDUCED PRESS. 63.8 PSI ±

LONG BRANCH ROAD

GROUND ELEV. = 860.0 ±
MAX. STATIC PRESS. = 129.9 PSI ±
REDUCED PRESS. 50.1 PSI ±

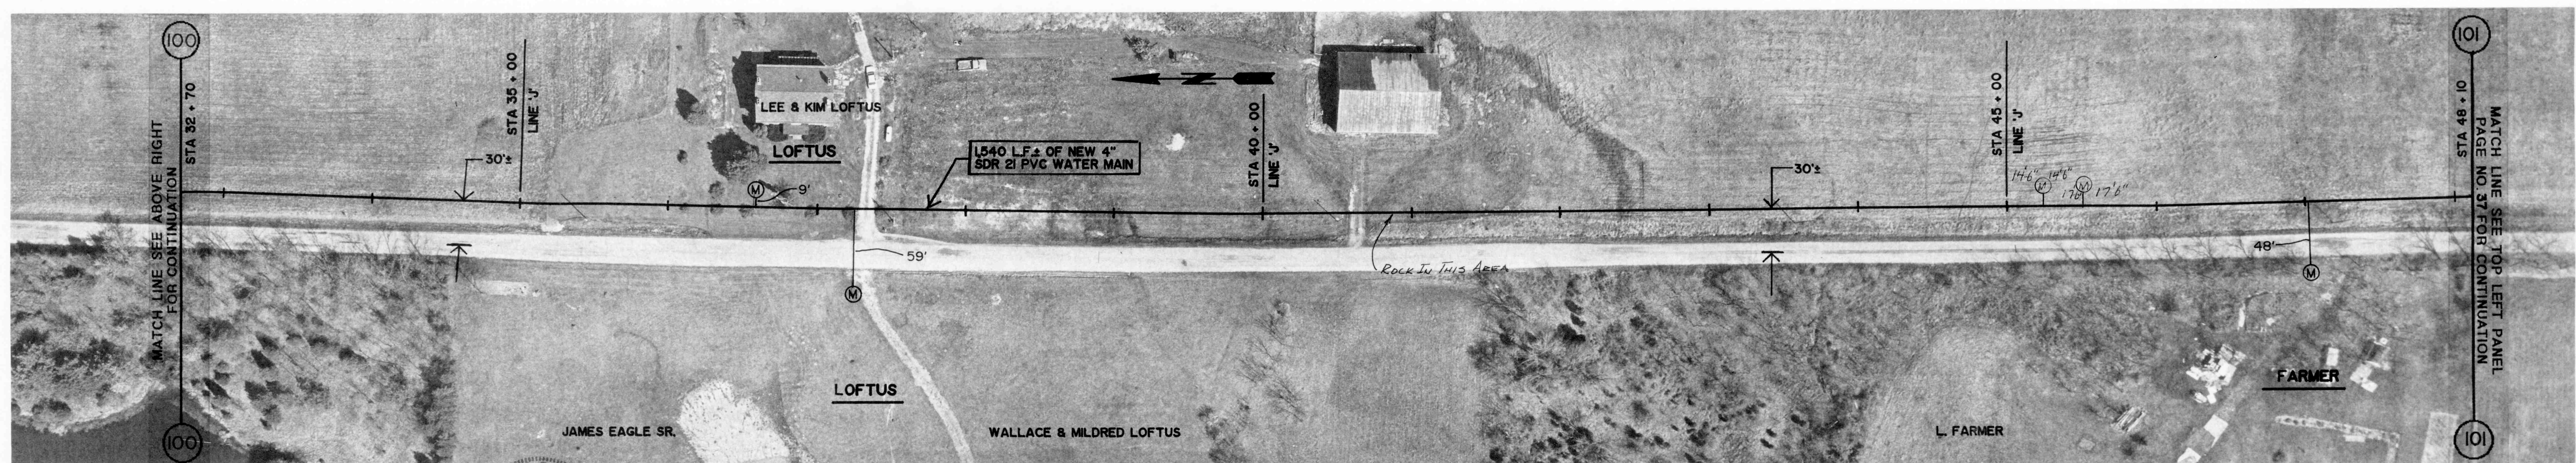

GROUND ELEV. = 860.0 ±
MAX. STATIC PRESS. = 129.9 PSI ±
REDUCED PRESS. 50.1 PSI ±

LONG BRANCH ROAD

GROUND ELEV. = 860.0 ±
MAX. STATIC PRESS. = 129.9 PSI ±
REDUCED PRESS. 50.1 PSI ±

REVISIONS

DRAWN BY	EL
DATE	10/1/91
CERTIFIED BY	REC
DATE	10/1/91

ROBERT E. CURRY & ASSOCIATES, INC.
CONSULTING ENGINEERS

ELROD WATER COMPANY INC.
DIVISION "D" DISTRIBUTION SYSTEM EXTENSIONS

4" PVC WATER MAIN
EXTENSION ALONG
LONG BRANCH ROAD

JOB NO.	SHT.
SCALE 1" = 50'	OF 43