


GROUND ELEV. = 970.0 ±
MAX. STATIC PRESS. = 82.3 PSI ±

GROUND ELEV. = 971.0 ±
MAX. STATIC PRESS. = 81.8 PSI ±

COUNTY ROAD 200 NORTH

NOTE: D.N.R. PERMIT REQUIRED TO CROSS STREAM. OWNER TO OBTAIN PERMIT. STREAM CROSSING PER STANDARD STREAM CROSSING DETAIL.


GROUND ELEV. = 930.0 ±
MAX. STATIC PRESS. = 99.6 PSI ±

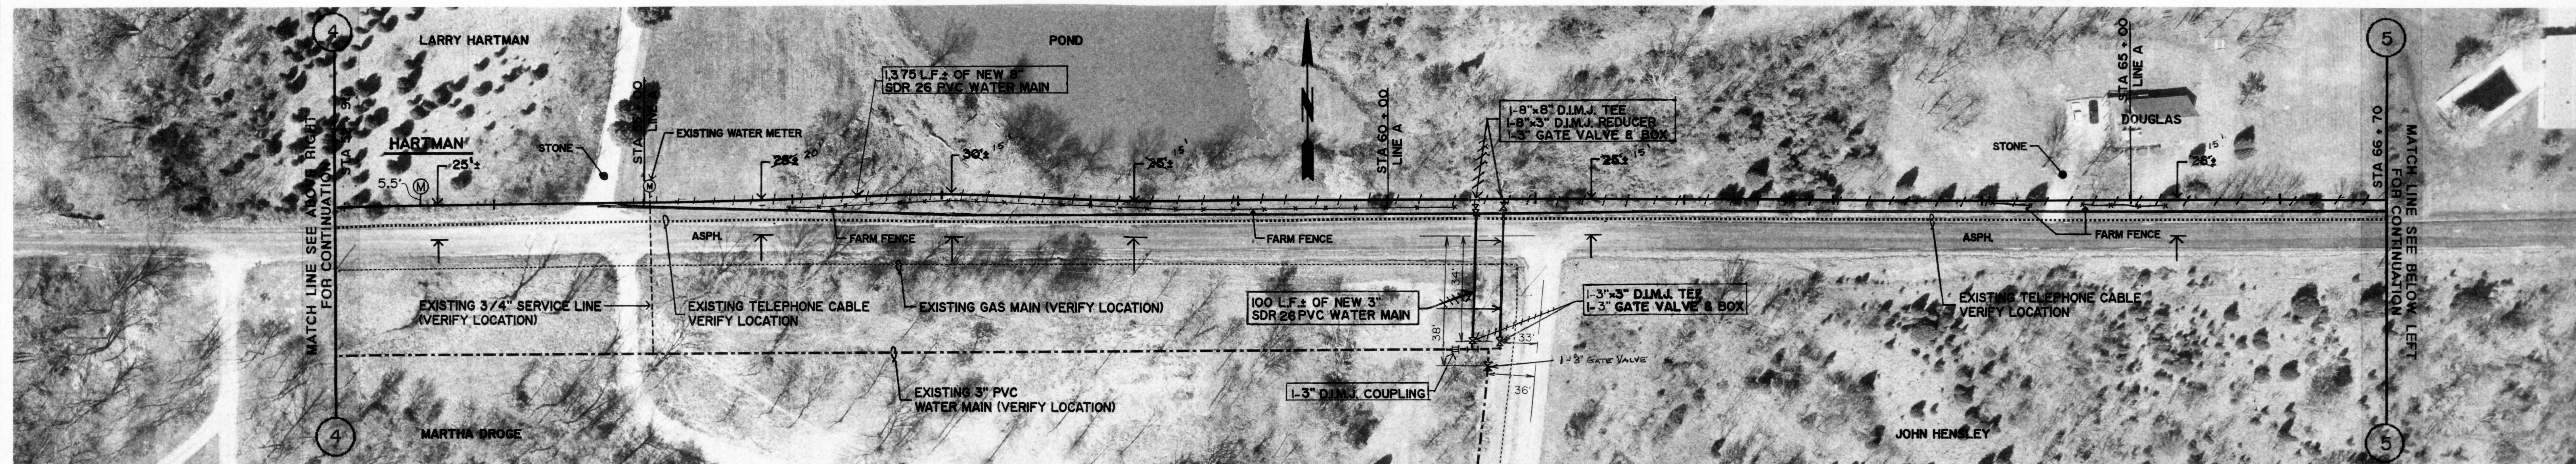

GROUND ELEV. = 930.0 ±
MAX. STATIC PRESS. = 99.6 PSI ±

COUNTY ROAD 200 NORTH

GROUND ELEV. = 980.0 ±
MAX. STATIC PRESS. = 77.9 PSI ±

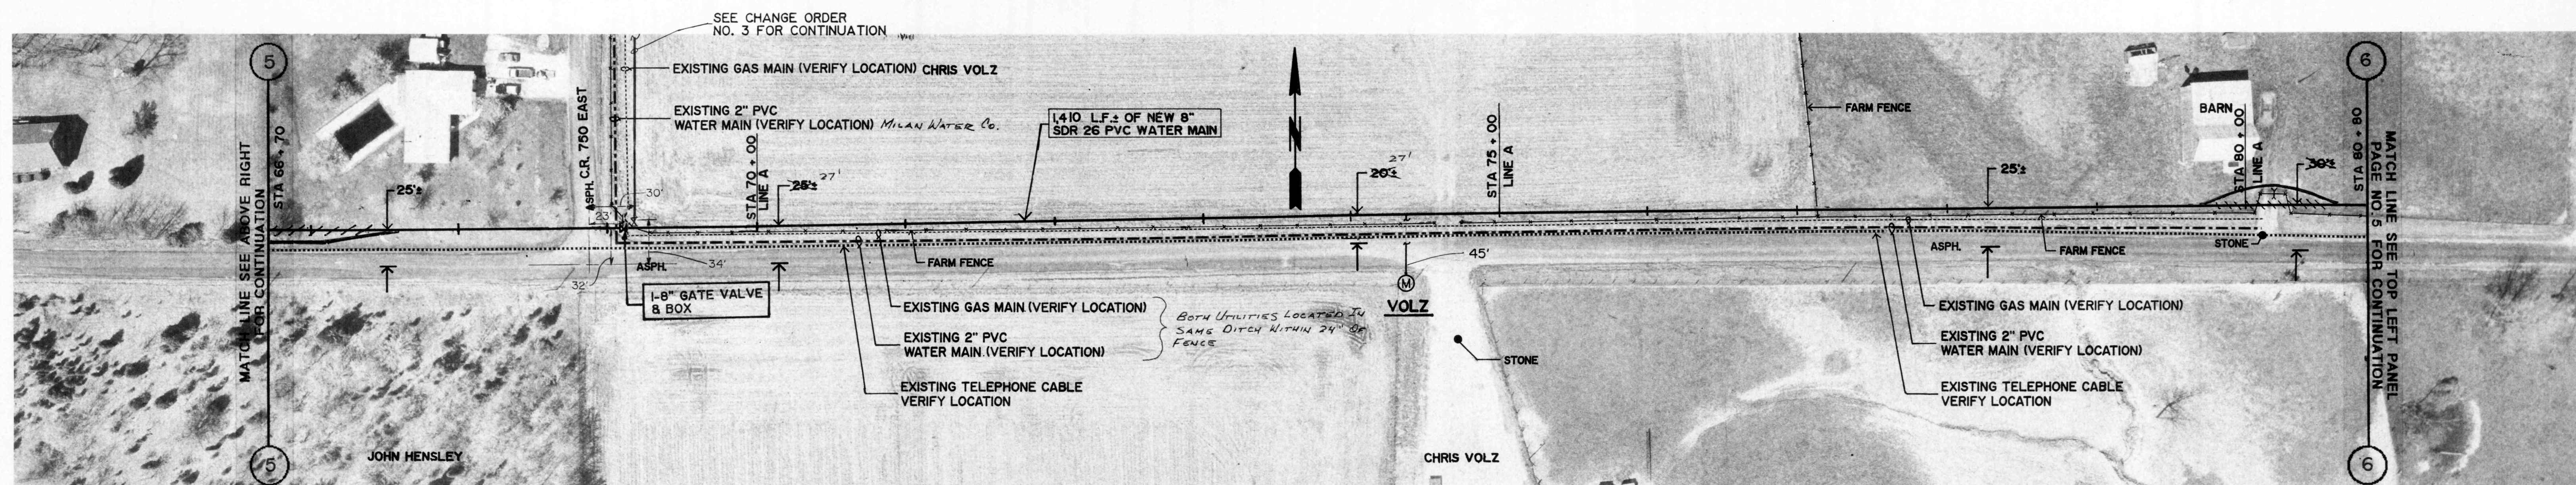

GROUND ELEV. = 980.0 ±
MAX. STATIC PRESS. = 77.9 PSI ±

GROUND ELEV. = 982.0 ±
MAX. STATIC PRESS. = 77.1 PSI ±

COUNTY ROAD 200 NORTH

GROUND ELEV. = 971.0 ±
MAX. STATIC PRESS. = 81.8 PSI ±

REVISIONS

DRAWN BY	Robert E. Curry
DATE	10/1/11
CERTIFIED BY	REC
DATE	12/1/11

ROBERT E. CURRY & ASSOCIATES, INC.
CONSULTING ENGINEERS

ELROD WATER COMPANY INC.
DIVISION "D" DISTRIBUTION SYSTEM EXTENSIONS

8" PVC WATER MAIN
EXTENSION ALONG
COUNTY ROAD 200 NORTH

JOB NO.	SHT.
SCALE	OF
1" = 50'	43