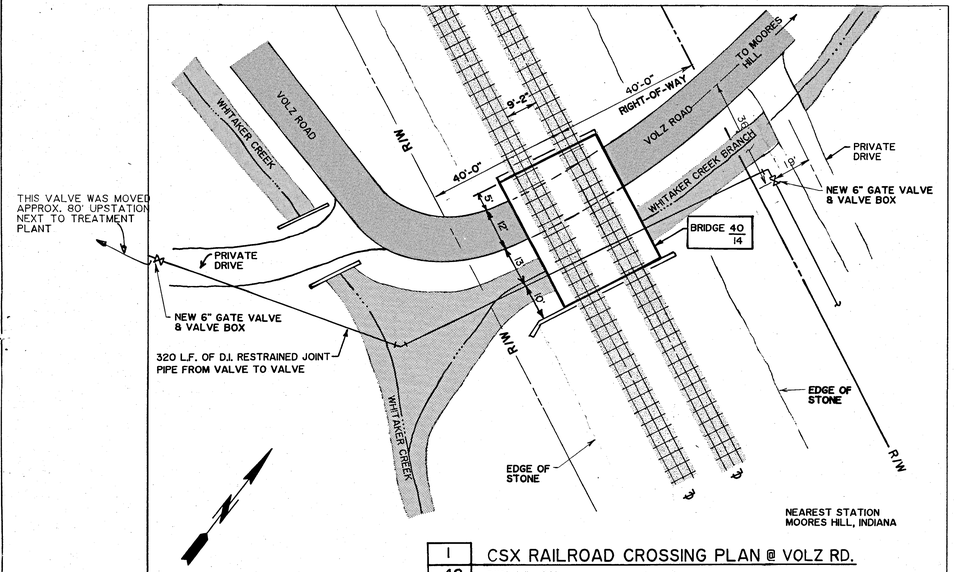

1 / 42 CSX RAILROAD CROSSING PLAN @ VOLZ RD.
SCALE 1" = 20'

VAL 149.1/11

PROPOSAL ITEM No. 9C

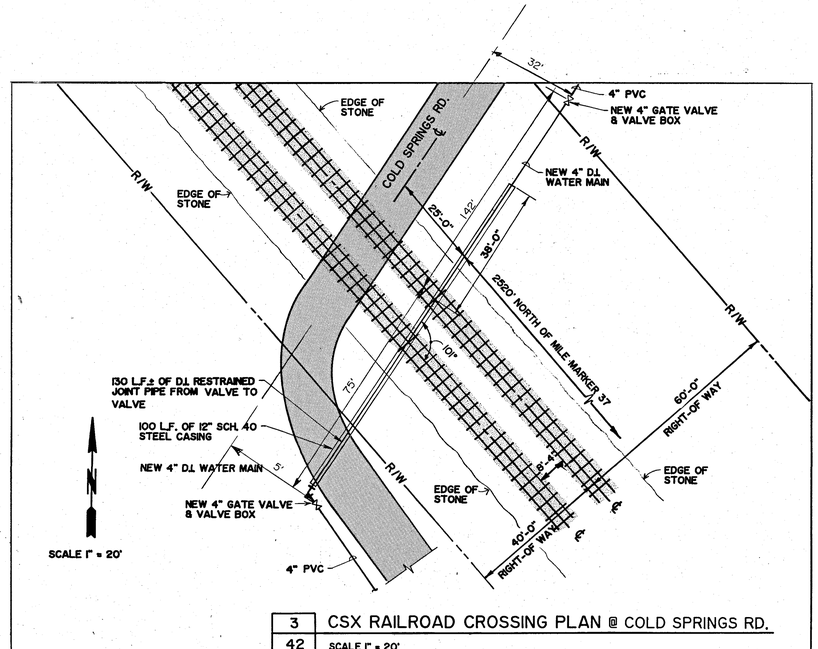

3 / 42 CSX RAILROAD CROSSING PLAN @ COLD SPRINGS RD.
SCALE 1" = 20'

VAL 149.9/9

PROPOSAL ITEM No. 9C

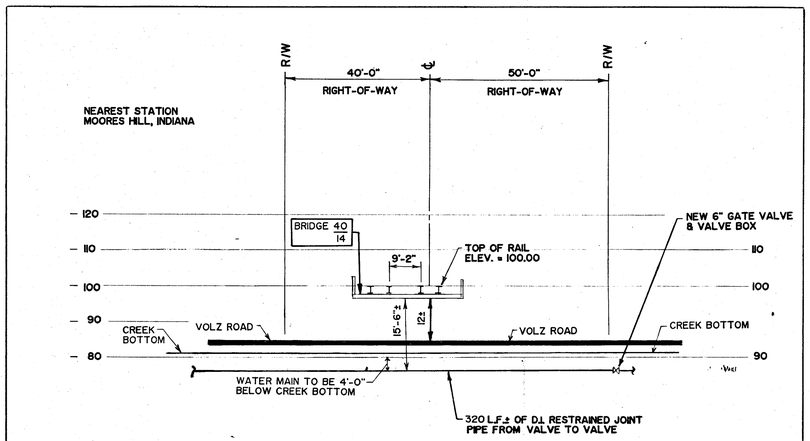

2 / 42 CSX RAILROAD CROSSING PROFILE @ VOLZ RD.
SCALE 1" = 20'

VAL 149.1/11

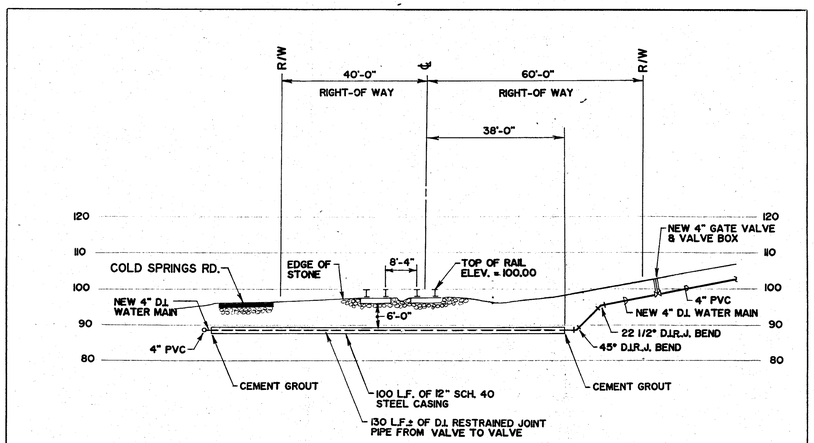

4 / 42 CSX RAILROAD CROSSING PROFILE @ COLD SPRINGS RD.
SCALE 1" = 20'

VAL 149.9/9

Robert E. Curry & Associates, Inc.
Engineers and Architects
3346 Avon Road, Plainfield, IN 46168
(317)-272-3050

ROBERT E. CURRY REGISTERED No. 15078 STATE OF INDIANA PROFESSIONAL ENGINEER

ELROD WATER COMPANY, INC.

DIV. "D" DISTRIBUTION SYSTEM EXTENSIONS

DRAWN BY

REVISED

RAILROAD CROSSING PLAN & PROFILES

DATE	APPROVED BY	DRAWING NUMBER
10/1/91	Robert E. Curry	42 OF 43