

ELROD WATER COMPANY, INC. MILAN, INDIANA

DIVISION "E" WATERWORKS SYSTEM IMPROVEMENTS

CONTRACT "A" WATER MAINS

PLAN SHEET INDEX

<u>SHEET DESCRIPTION</u>	<u>SHEET NO.</u>
TITLE SHEET	1
LOCATION PLAN	2
LINE A	3 to 11
LINES A & A-1	12
LINE A	13 & 14
LINE A-1	15 to 18
LINE B	19 to 30
LINE B-1	31
LINES B-1, B-2, & B-2A	32
LINE B-3	33
LINES B-3A & B-4	34
LINES B-5 & B-5A	35
LINES B, C, & C-1	36
LINES C & C-2	37
LINES C, C-2, C-3 & C-4	38
LINE C-5	39
LINE C-1	40
LINES C-1 & C-6	41
LINES C-1, C-6, C-7 & C-8	42
LINE C-8	43
ALTITUDE VALVE/PRV VAULT DETAILS	44
DETAILS	45

BOARD OF DIRECTORS



JOYCE HUFFMAN, PRESIDENT	NELSON ELLIOT, MEMBER
HENRY WESTERMAN, TREASURER	ROBERT HUMMEL, MEMBER
ALREENA NICKULIS, SECRETARY	JEFFERY LAUB, MEMBER
ED ALLGEIER, MEMBER	FRANK MARTIN, MEMBER
MARY ENGEL, OFFICE MANAGER	DANIEL SCHMALTZ, MEMBER
JEFF MEINDERS, SUPERINTENDENT	

M.D. **WESSLER and ASSOCIATES** CONSULTING ENGINEERS

6219 South East Street, Suite A
Indianapolis, Indiana 46227-2148

OCTOBER 14, 1993
REVISED MARCH 4, 1994

CERTIFIED BY:

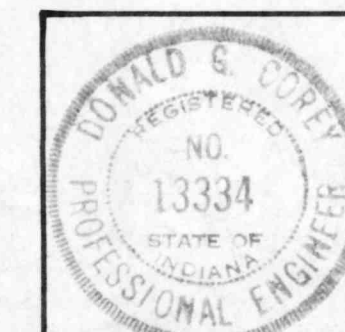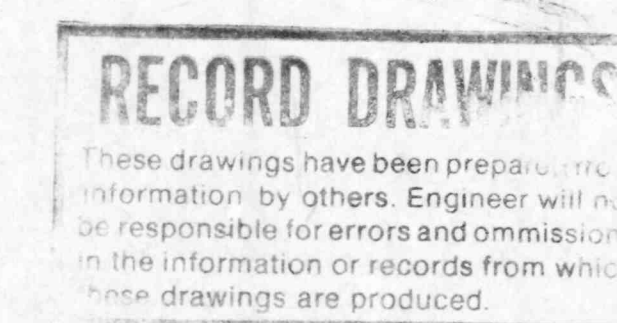

Donald G. Corey
DONALD G. COREY
REGISTERED ENGINEER STATE OF INDIANA NO. 13334



Martin A. Wessler
MARTIN A. WESSLER
REGISTERED ENGINEER STATE OF INDIANA NO. 9300188