



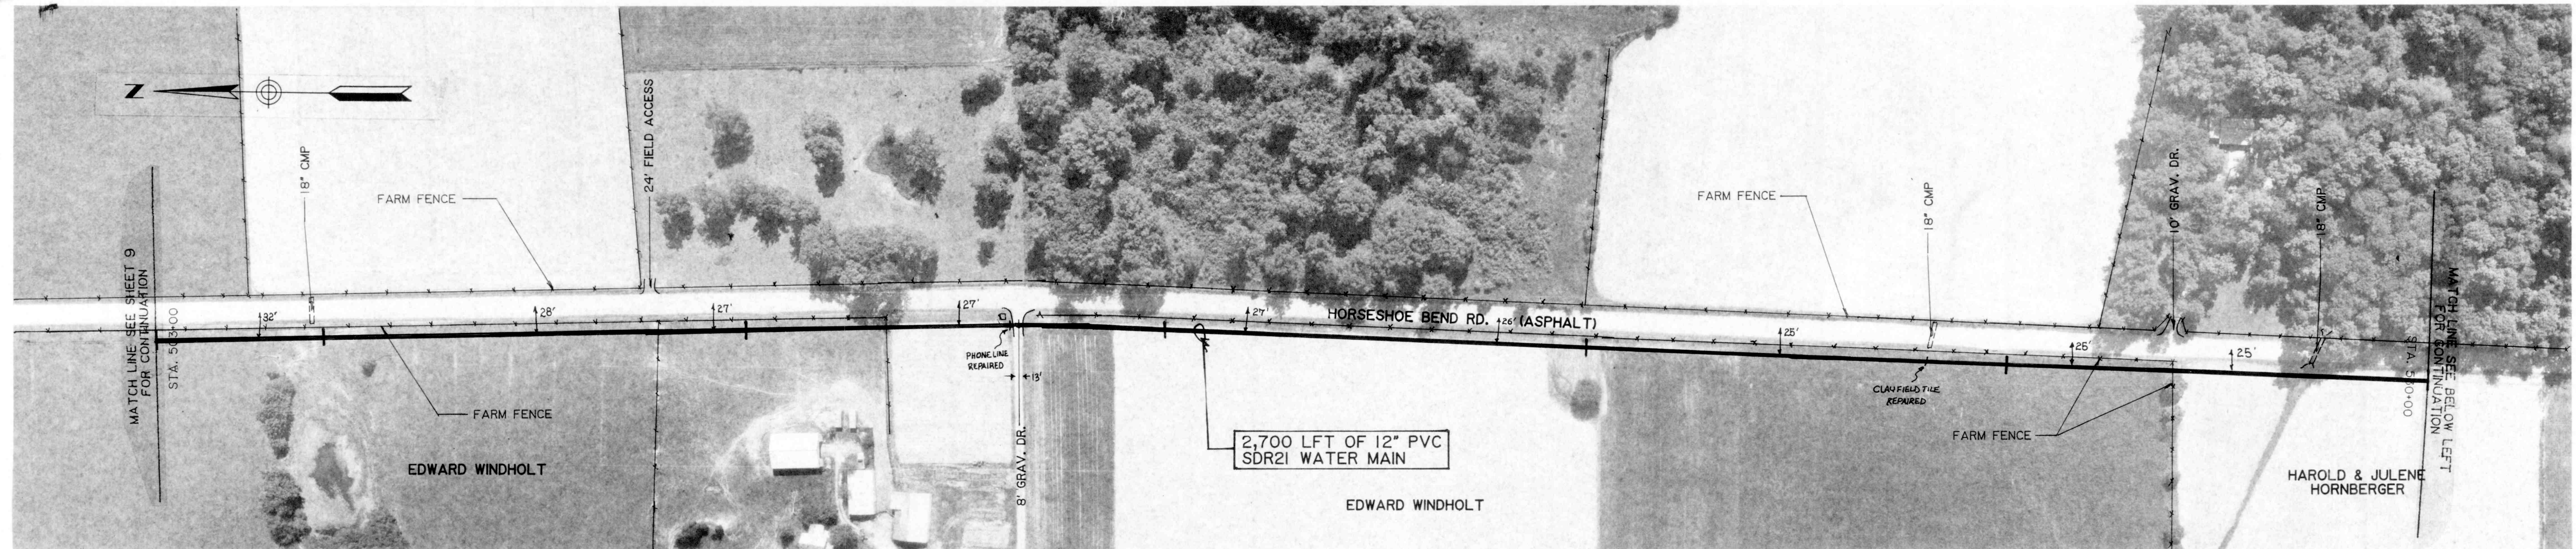

GROUND ELEV. = 980.0 ±
MAX. STATIC PRESS. = 77.9 PSI ±

GROUND ELEV. = 985.0 ±
MAX. STATIC PRESS. = 75.7 PSI ±


LINE A HORSESHOE BEND RD.

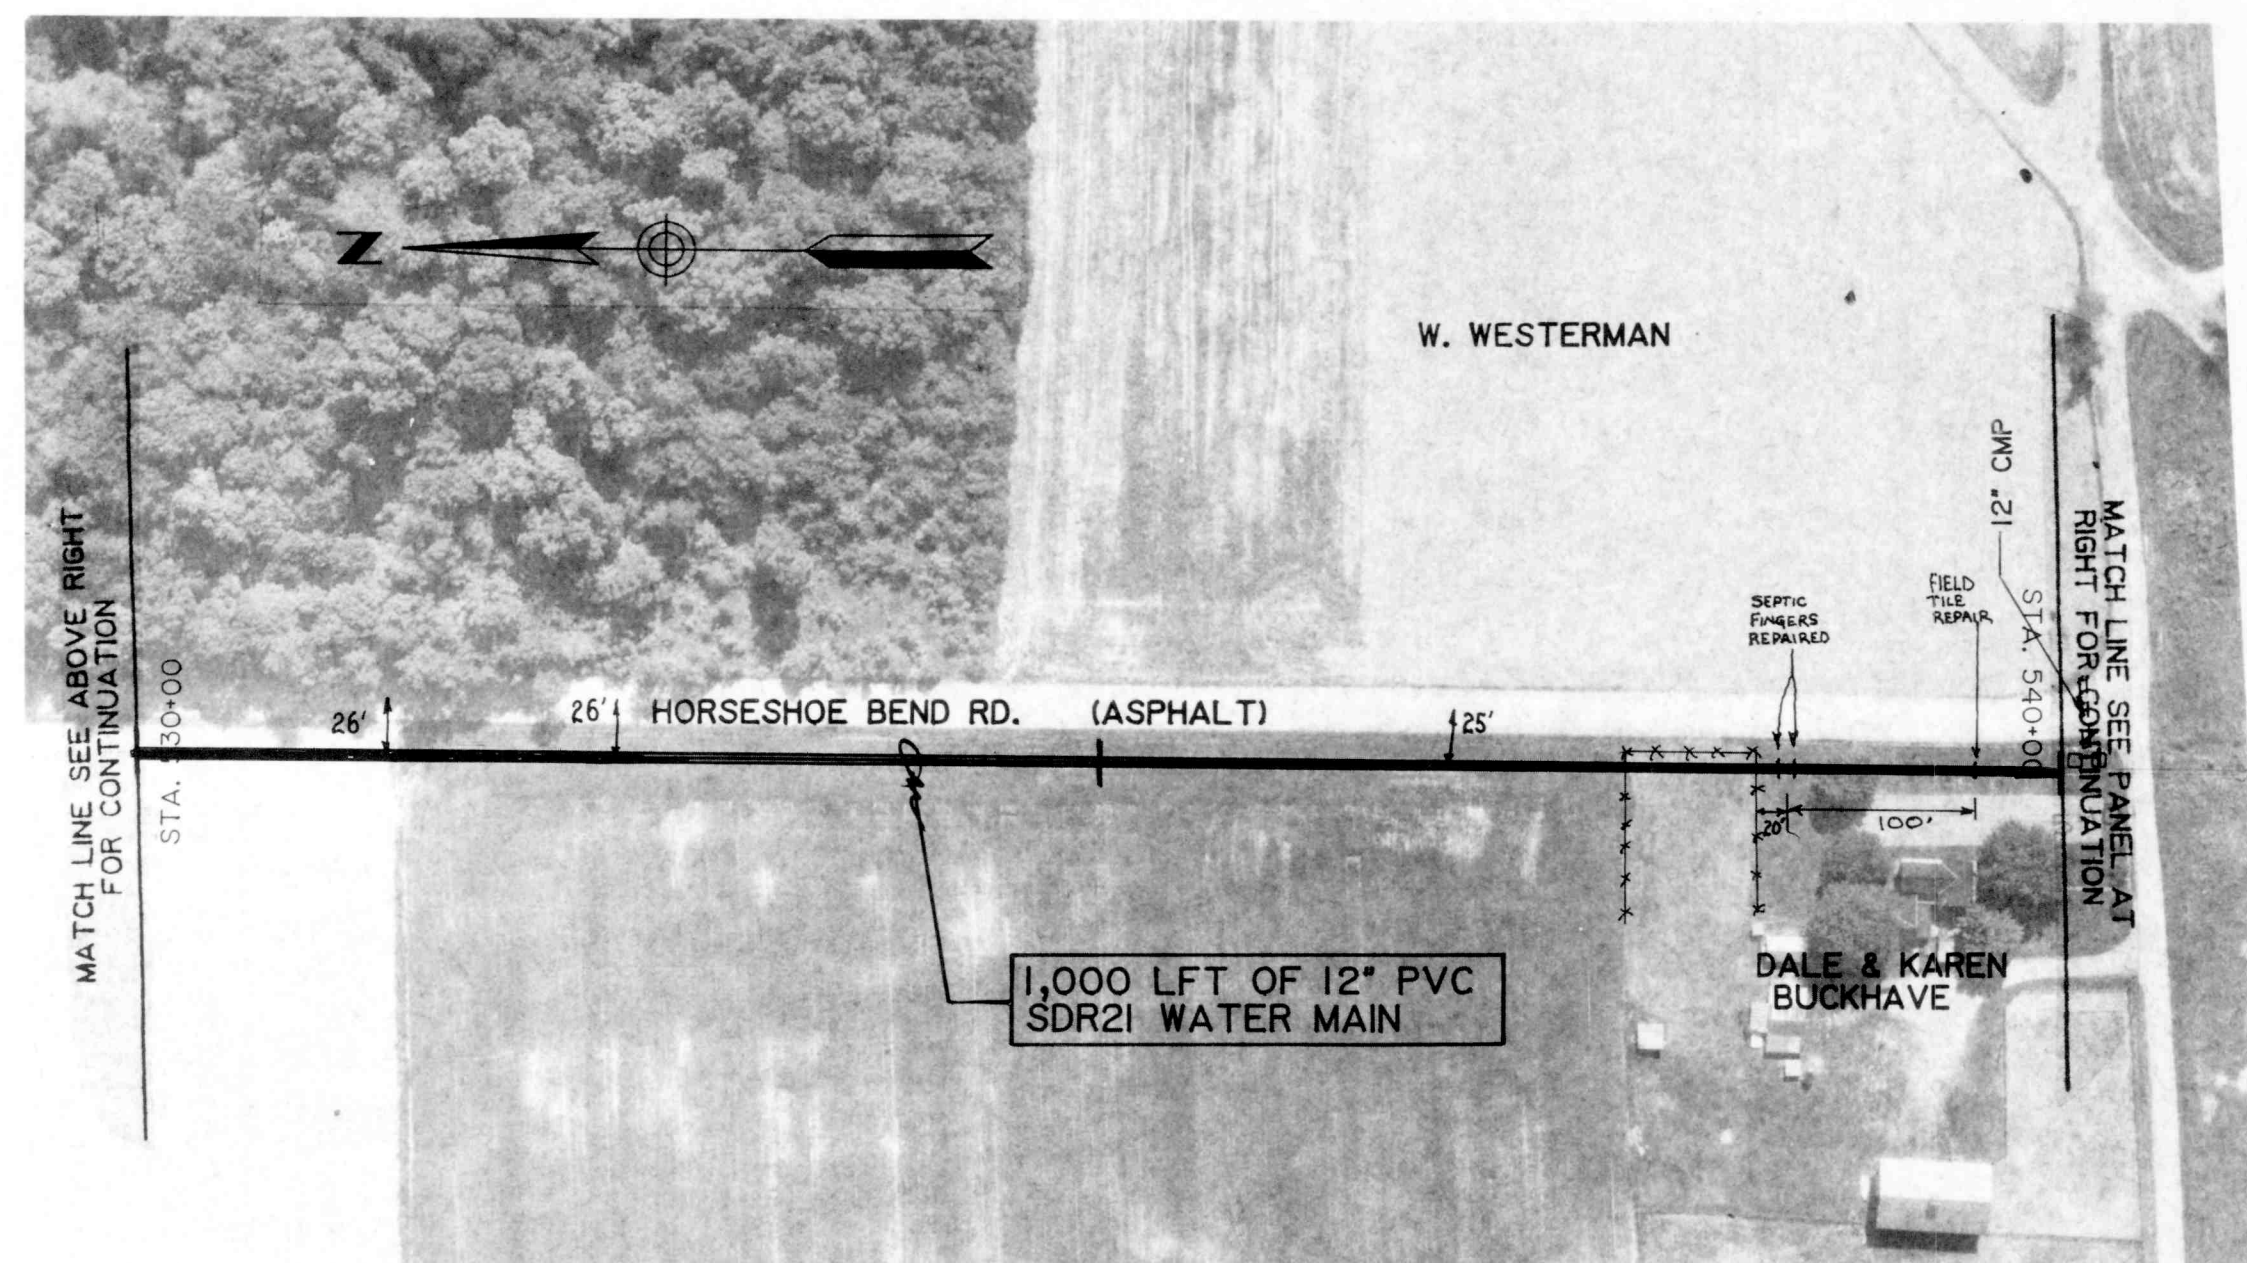

GROUND ELEV. = 985.0 ±
MAX. STATIC PRESS. = 75.7 PSI ±

GROUND ELEV. = 984.0 ±
MAX. STATIC PRESS. = 76.2 PSI ±


LINE A HORSESHOE BEND RD.

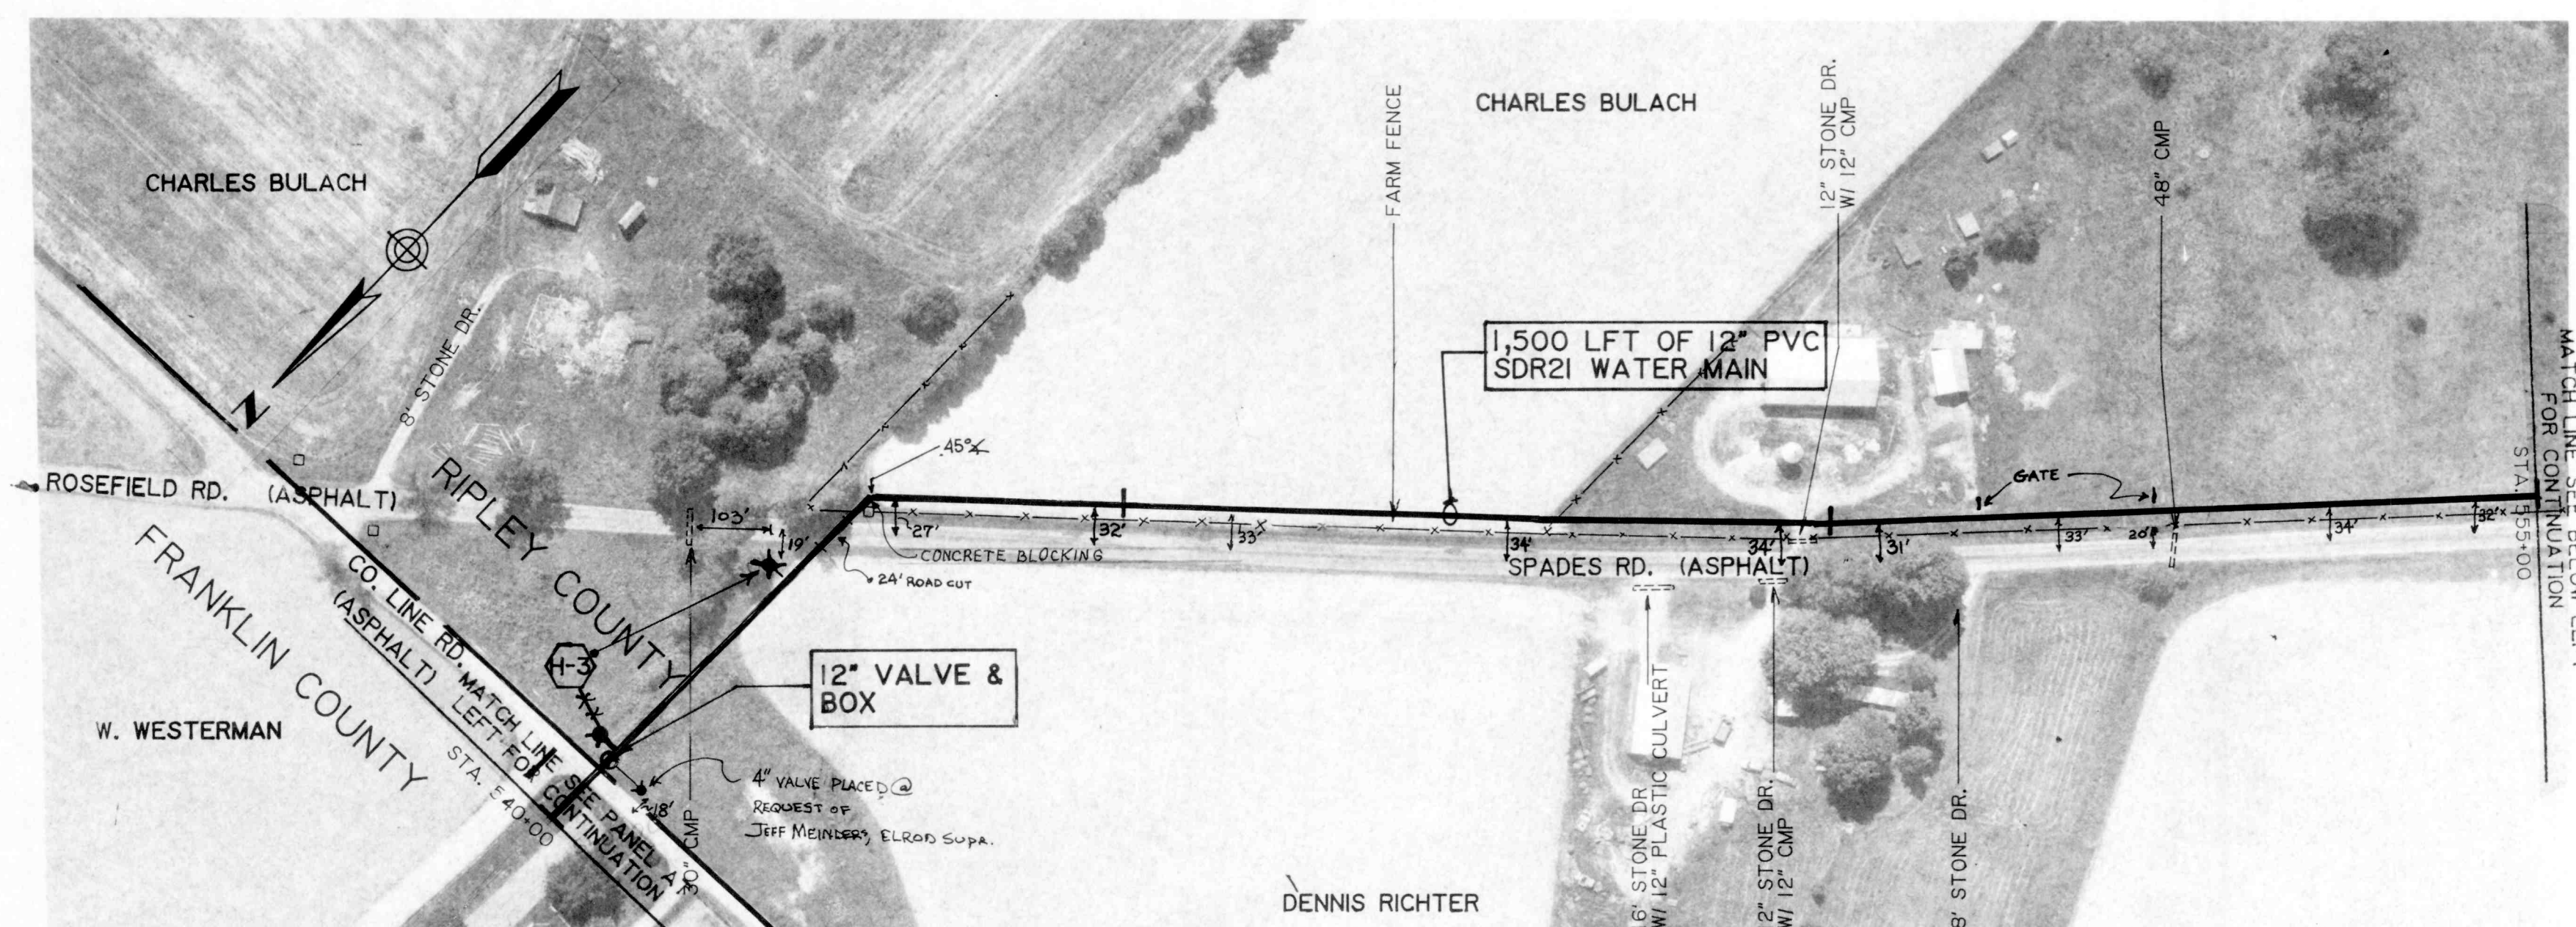

GROUND ELEV. = 984.0 ±
MAX. STATIC PRESS. = 76.2 PSI ±

GROUND ELEV. = 970.0 ±
MAX. STATIC PRESS. = 82.3 PSI ±

LINE A SPADES RD. ROSEFELD RD.

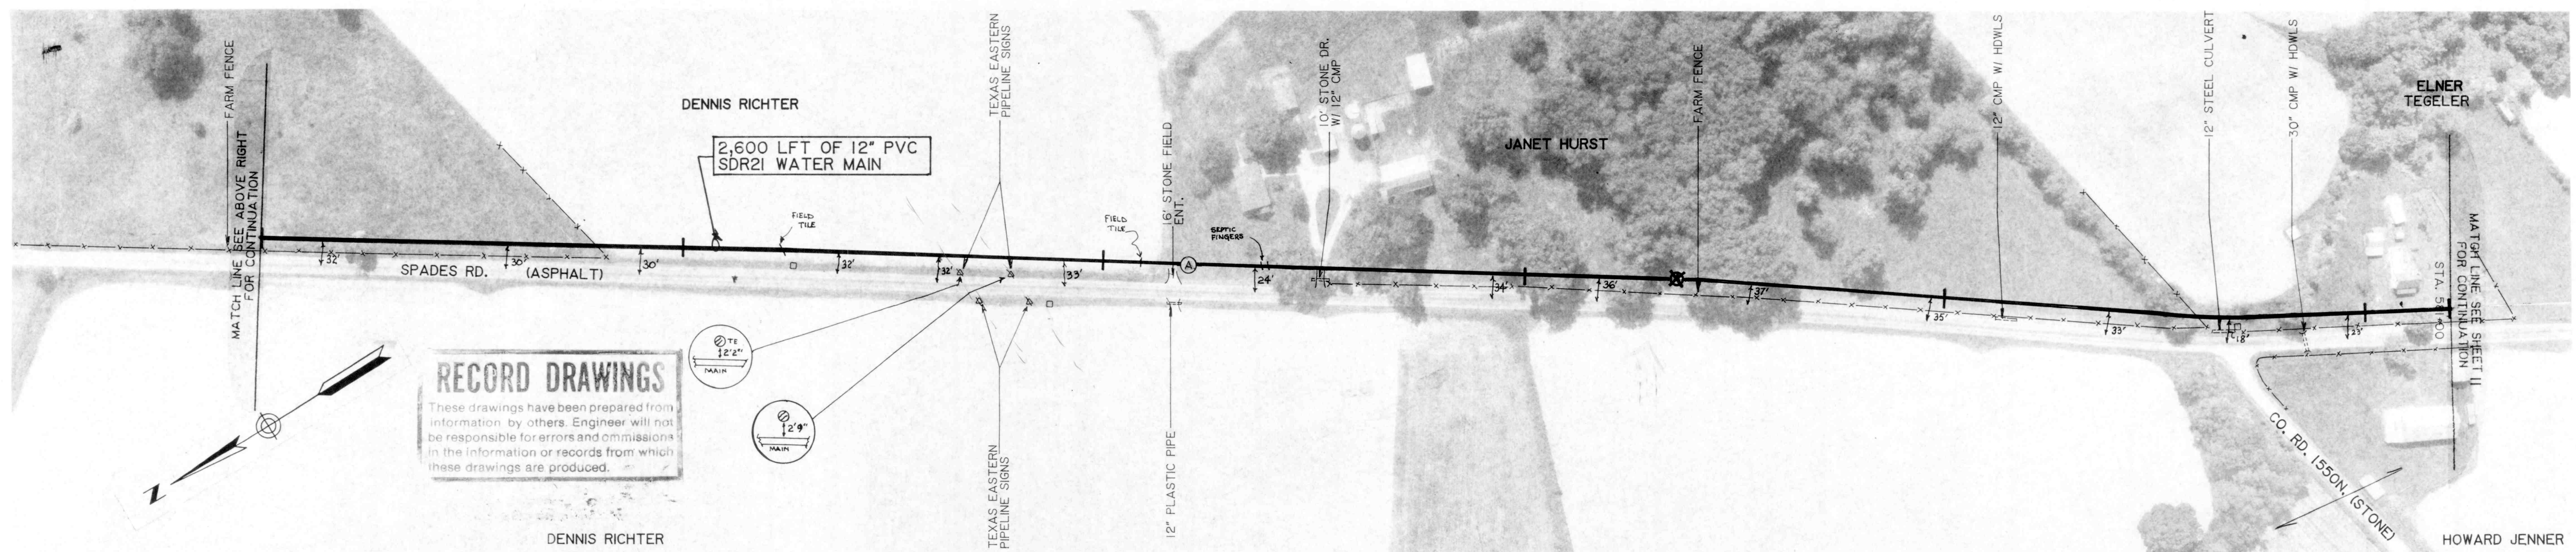

GROUND ELEV. = 970.0 ±
MAX. STATIC PRESS. = 82.3 PSI ±

GROUND ELEV. = 985.0 ±
MAX. STATIC PRESS. = 75.7 PSI ±


LINE A SPADES RD. ROSEFELD RD.

CONTRACT "A"
WATER MAINS
LINE "A"
ELROD WATER COMPANY, INC.
DIVISION "E"
WATERWORKS SYSTEM IMPROVEMENTS

M.D. WESSLER and ASSOCIATES
CONSULTING ENGINEERS
6219 South East Street, Suite A
Indianapolis, Indiana 46227-2148

SCALE: 1" = 100'
DATE: OCT. 14, 1993
PROJECT NO.: 37391.04
DRAWN BY: CLG
APPROVED BY: DGC

NOT PUBLISHED
ALL RIGHTS RESERVED
EXCEPT FOR USES EXPRESSLY
PERMITTED IN WRITING, INFOR-
MATION SHOWN OR INCLUDED
IN THIS DOCUMENT IS SOLELY
THE PROPERTY OF M.D.
WESSLER & ASSOCIATES, INC.

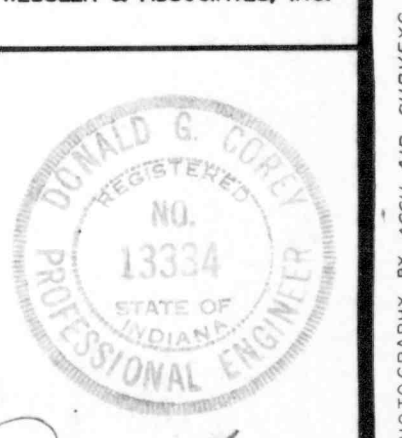

SHEET A 10
OF 45