




20 ALS

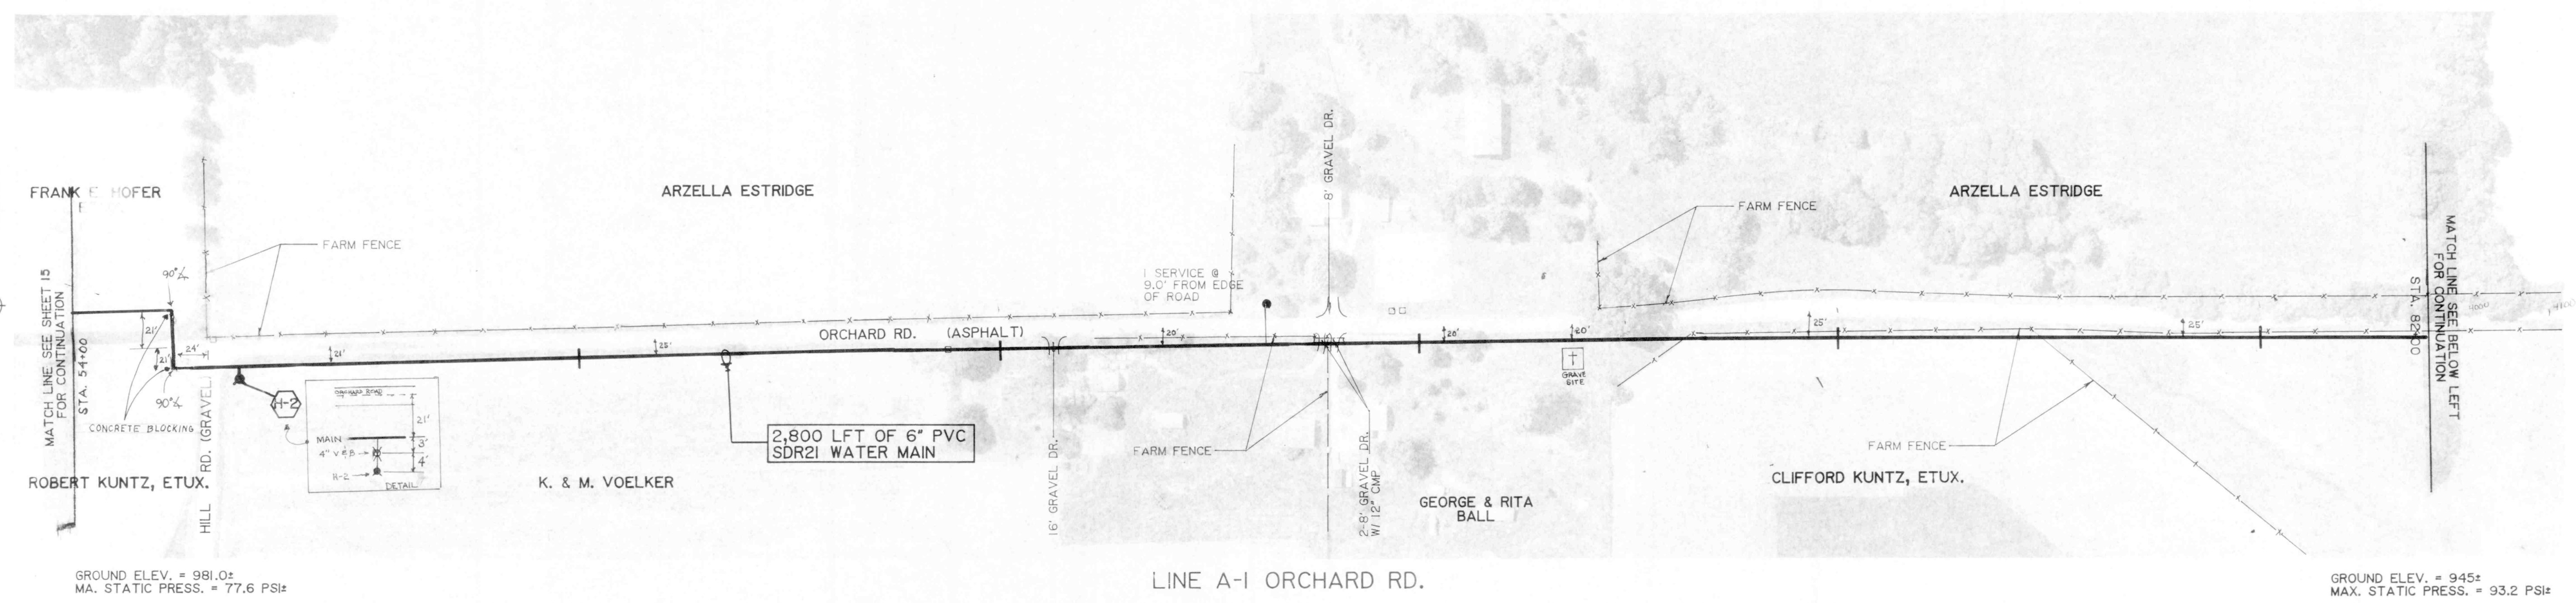

LINE A-1 ORCHARD RD.

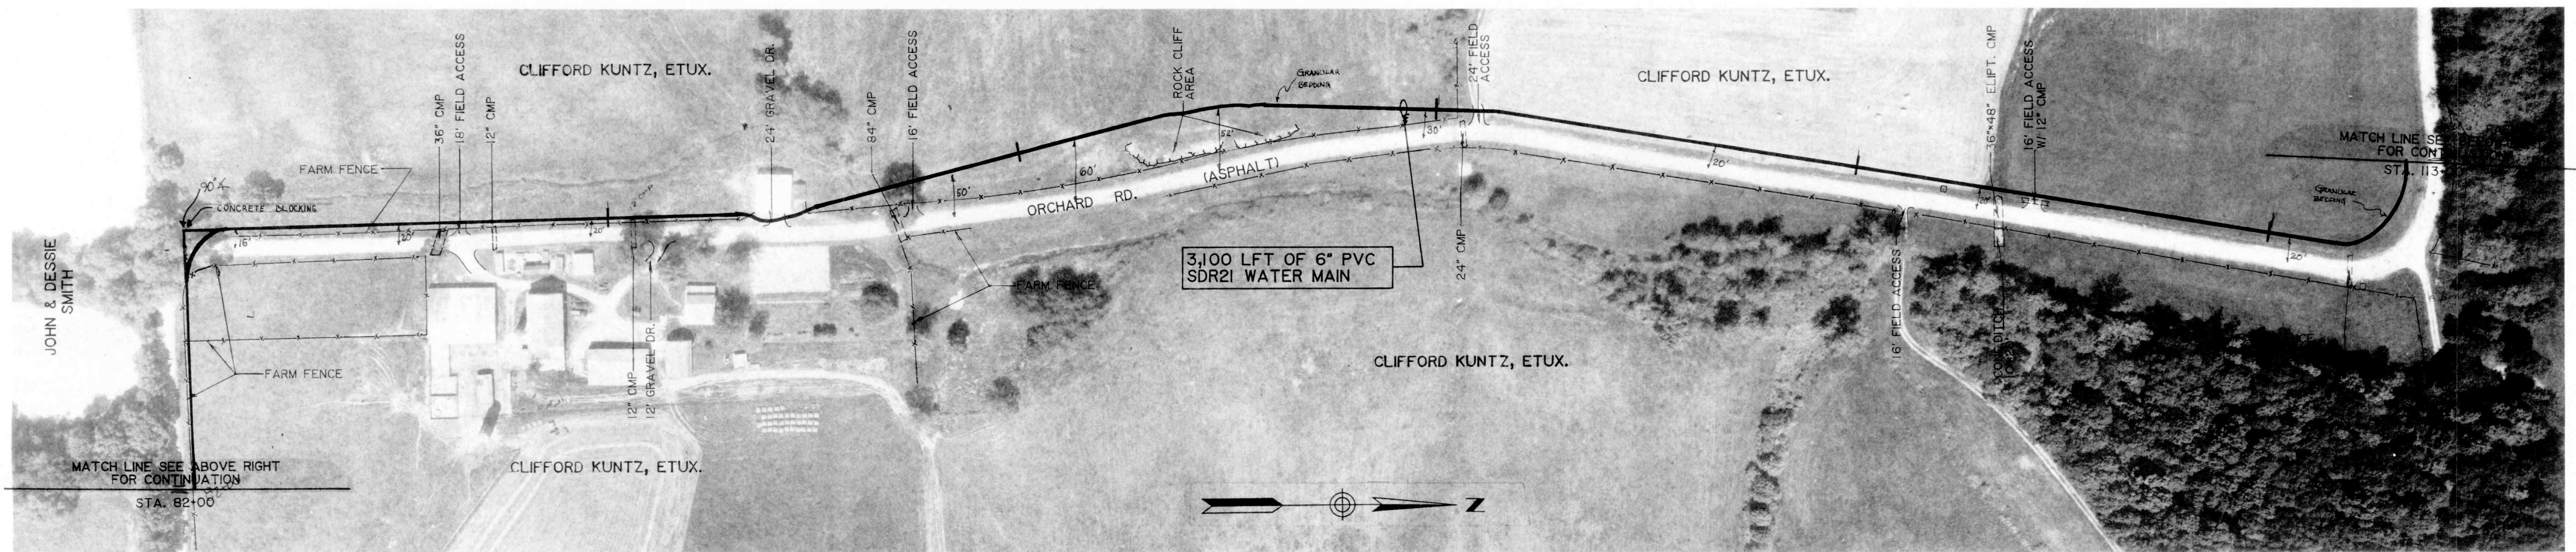

LINE A-1 ORCHARD RD.

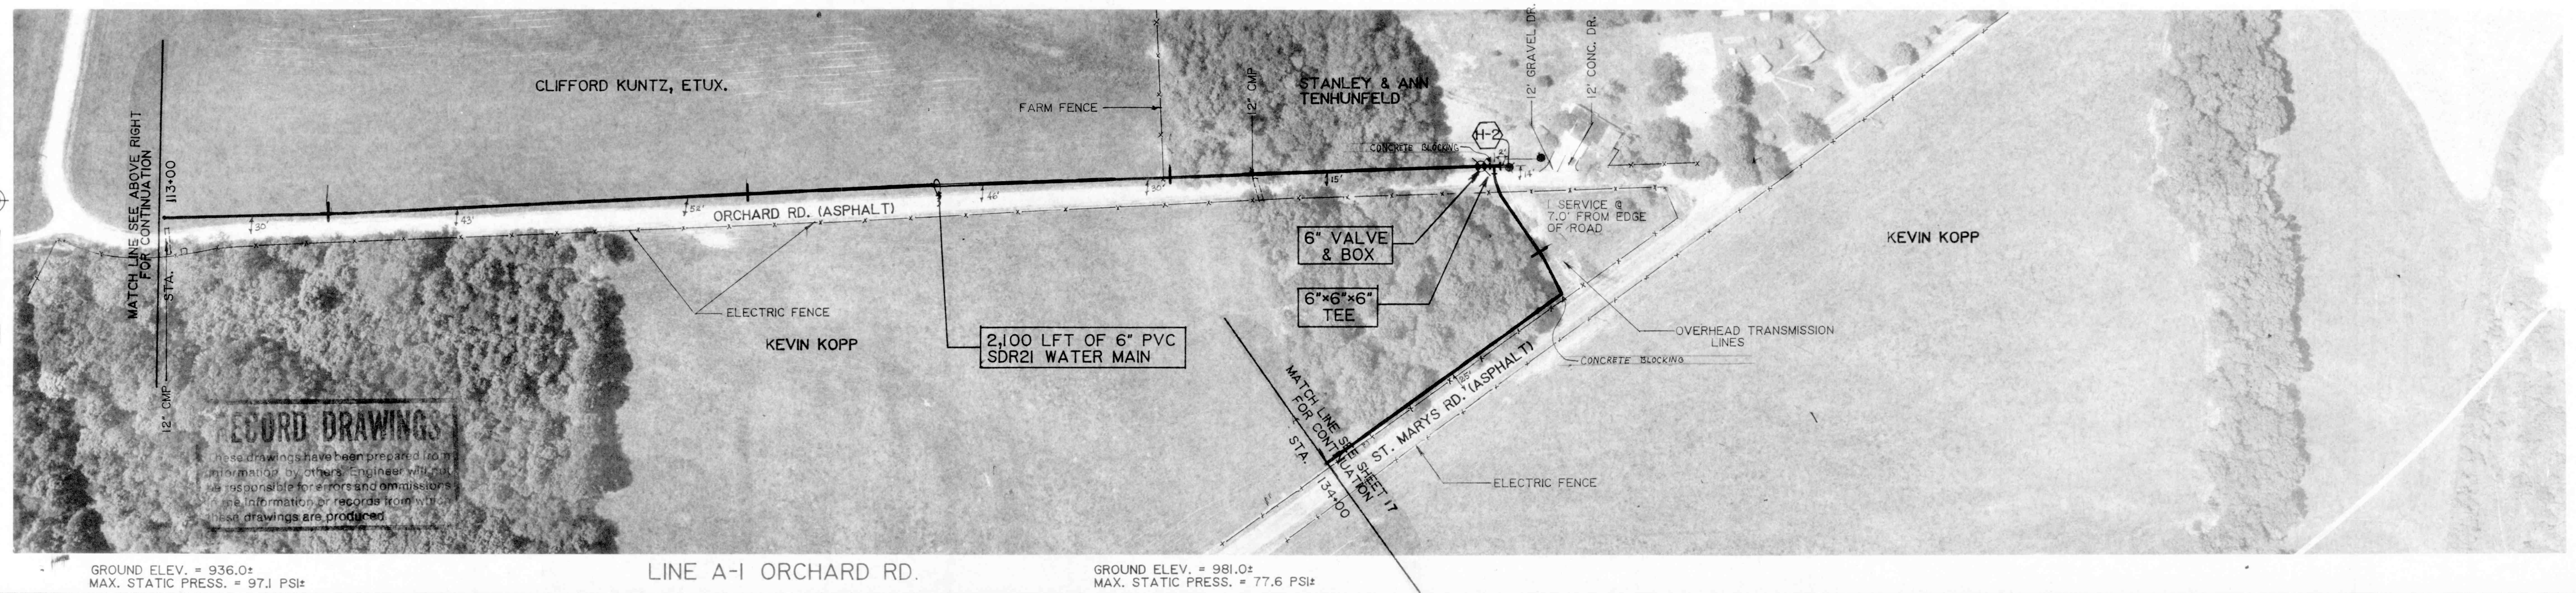

LINE A-1 ORCHARD RD.

CONTRACT "A"
WATER MAINS
LINE "A-1"
DIVISION "E"
WATERWORKS SYSTEM IMPROVEMENTS

M.D. WESSLER and ASSOCIATES
CONSULTING ENGINEERS
8219 South East Street, Suite A
Indianapolis, Indiana 46227-2148

SCALE: 1" = 100'
DATE: OCT. 14, 1993
PROJECT NO.: 37391.04
DRAWN BY: CLG
APPROVED BY: DGC

NOT PUBLISHED
ALL RIGHTS RESERVED
EXCEPT FOR USES EXPRESSLY
PERMITTED IN WRITING, INFOR-
MATION SHOWN OR INCLUDED
IN THIS DOCUMENT IS SOLELY
THE PROPERTY OF M.D.
WESSLER & ASSOCIATES, INC.

SHEET A 16
OF 45

NO.
10/3/94
DATE
BY
CLG
CORRECTED PROP. OWNERS
REVISIONS