



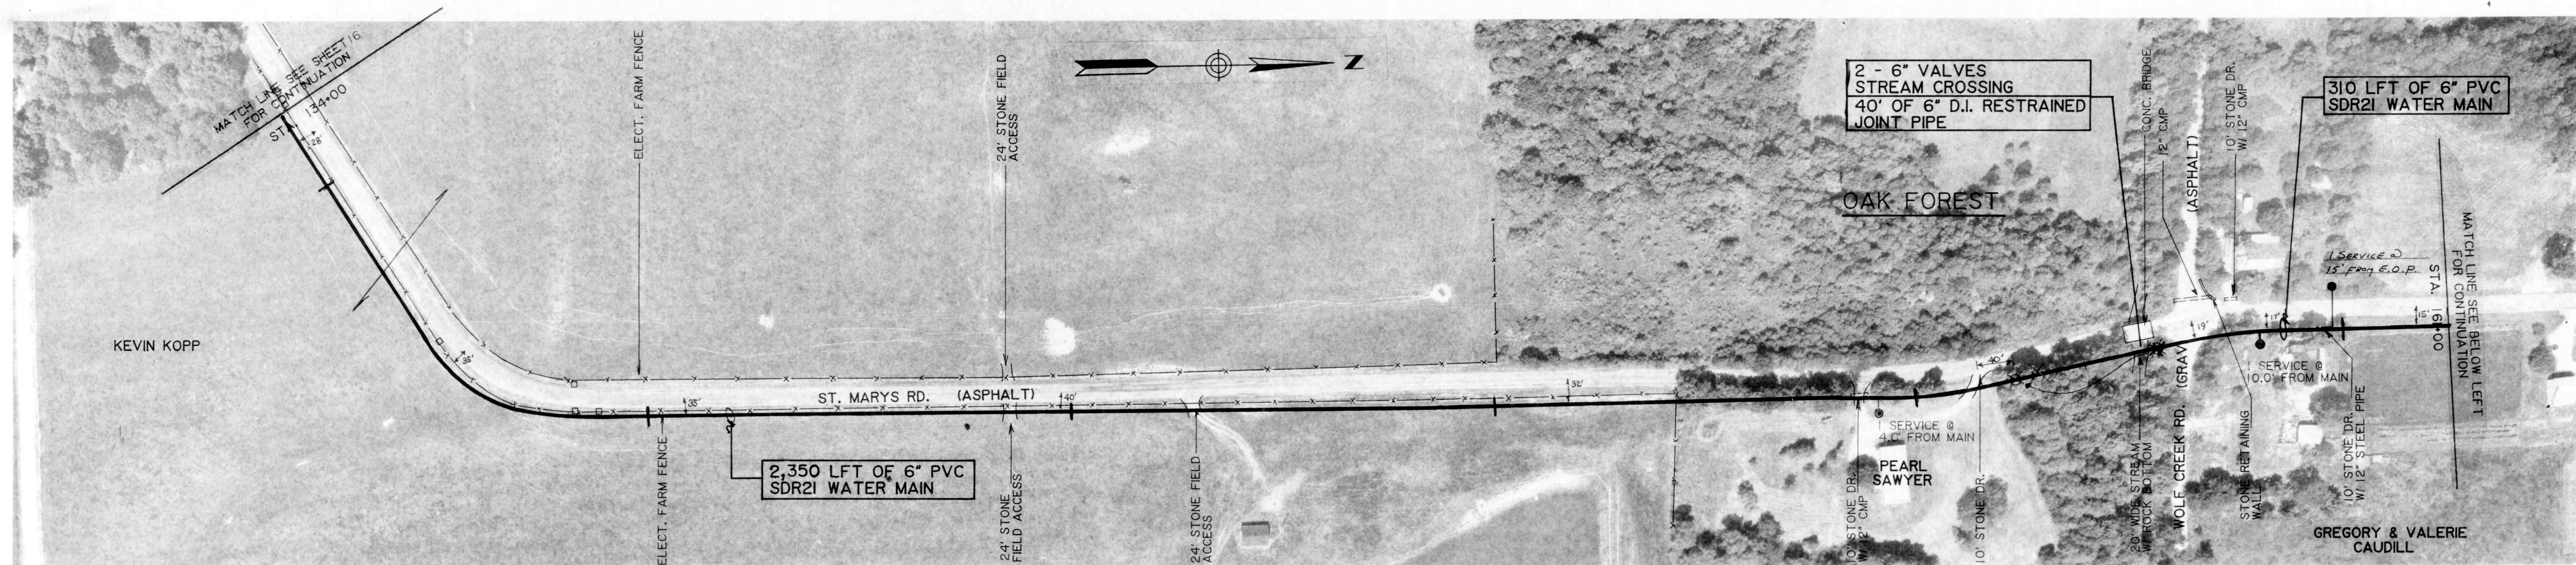

GROUND ELEV. = 981.0±
MAX. STATIC PRESS. = 77.6 PSI±

LINE A-1 ST. MARYS RD.


GROUND ELEV. = 970±
MAX. STATIC PRESS. = 82.3 PSI±

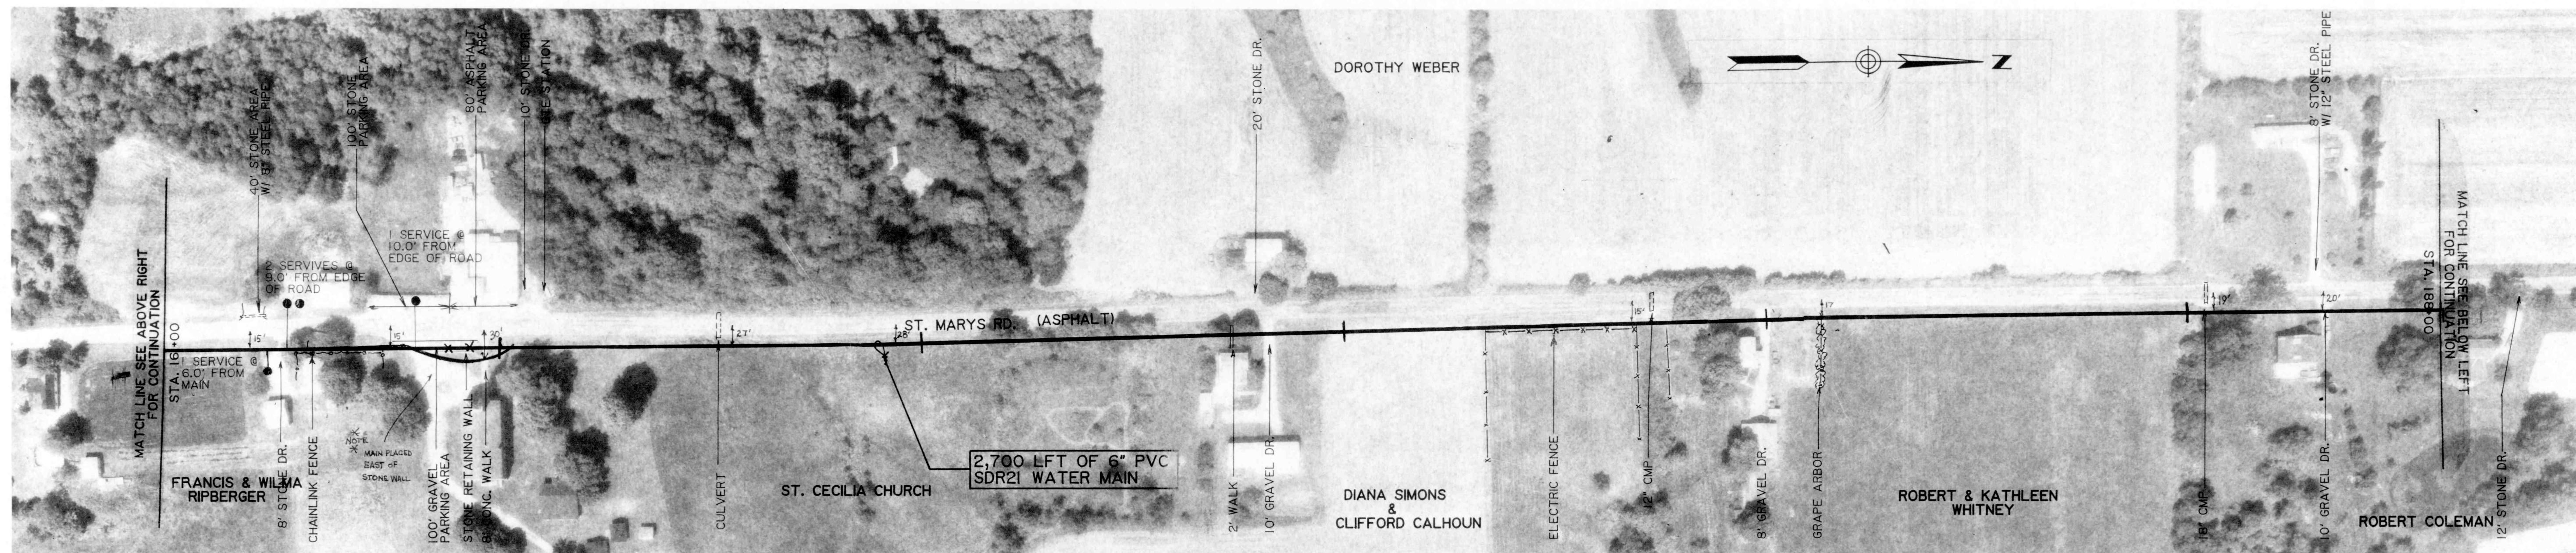

GROUND ELEV. = 970±
MAX. STATIC PRESS. = 82.3 PSI±

LINE A-1 ST. MARYS RD.

GROUND ELEV. = 975.0±
MAX. STATIC PRESS. = 80.2 PSI±

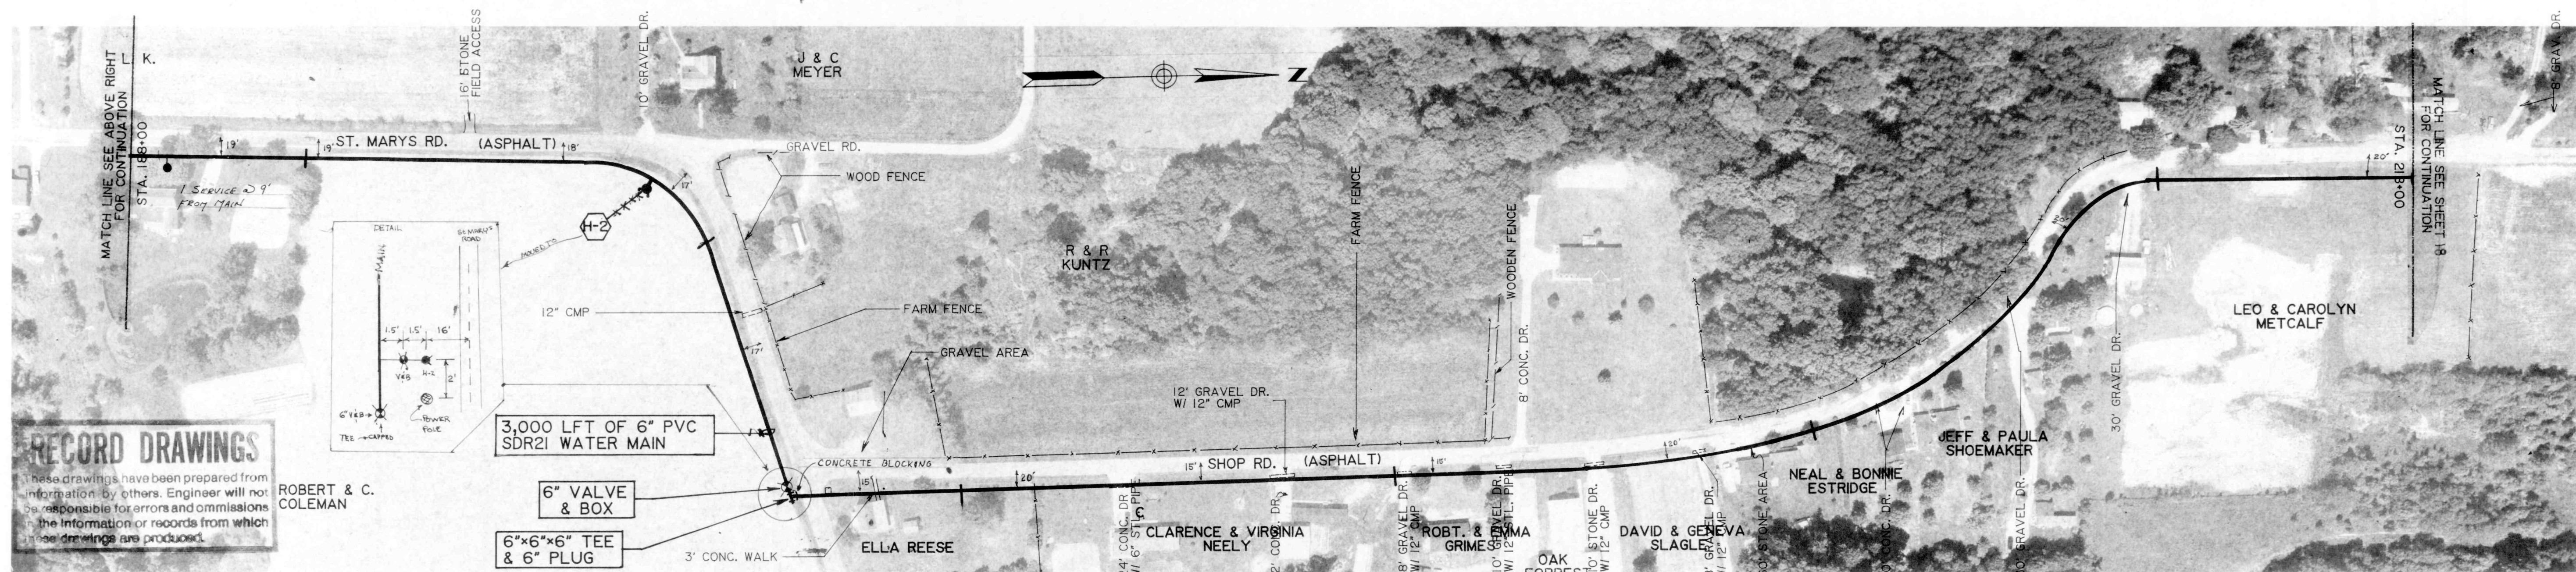

GROUND ELEV. = 975.0±
MAX. STATIC PRESS. = 80.2 PSI±

LINE A-1 ST. MARYS RD. & SHOP RD.

GROUND ELEV. = 973.0±
MAX. STATIC PRESS. = 81.0 PSI±

CONTRACT "A"
WATER MAINS
LINE "A-1"
ELROD WATER COMPANY, INC.
DIVISION "E"
WATERWORKS SYSTEM IMPROVEMENTS

M.D. WESSLER and ASSOCIATES
CONSULTING ENGINEERS
6219 South East Street, Suite A
Indianapolis, Indiana 46227-2148

SCALE: 1" = 100'
DATE: OCT. 14, 1993
PROJECT NO.: 37391.04
DRAWN BY: CLG
APPROVED BY: JGC

NOT PUBLISHED
ALL RIGHTS RESERVED
EXCEPT FOR USES EXPRESSLY
PERMITTED IN WRITING, INFOR-
MATION SHOWN OR INCLUDED
IN THIS DOCUMENT IS SOLELY
THE PROPERTY OF M.D.
WESSLER & ASSOCIATES, INC.

PROFESSIONAL ENGINEER
NO. 13334
STATE OF INDIANA

Donald S. Wessler

SHEET A 17