



2045

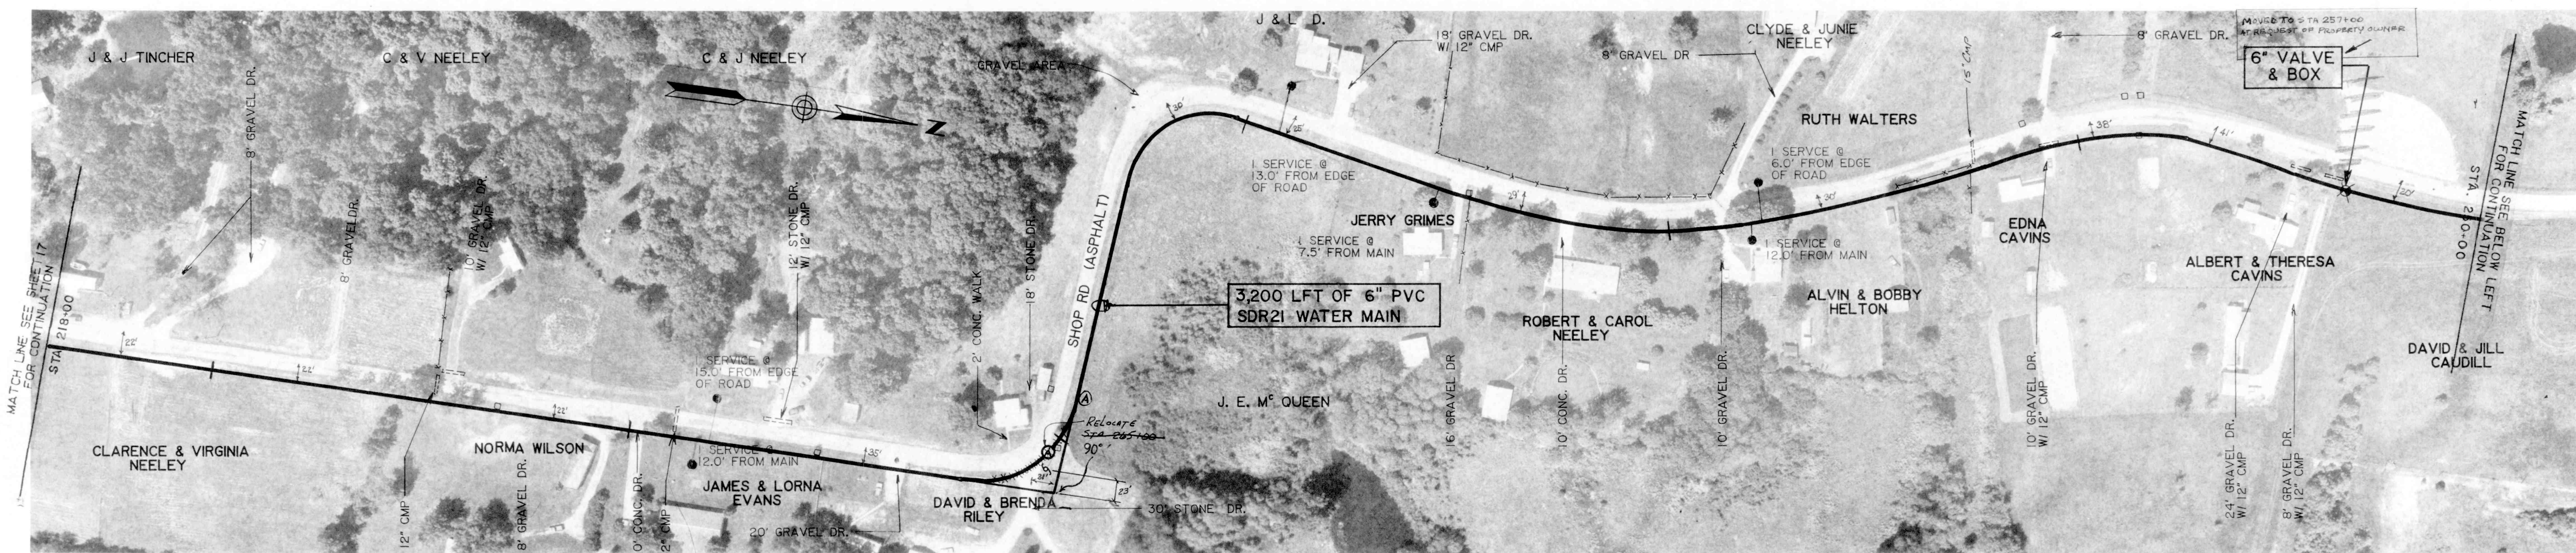

GROUND ELEV. = 973.0 ±
MAX. STATIC PRESS. = 81.0 PSI ±


LINE A-1 SHOP RD.

GROUND ELEV. = 975.0 ±
MAX. STATIC PRESS. = 81.1 PSI ±

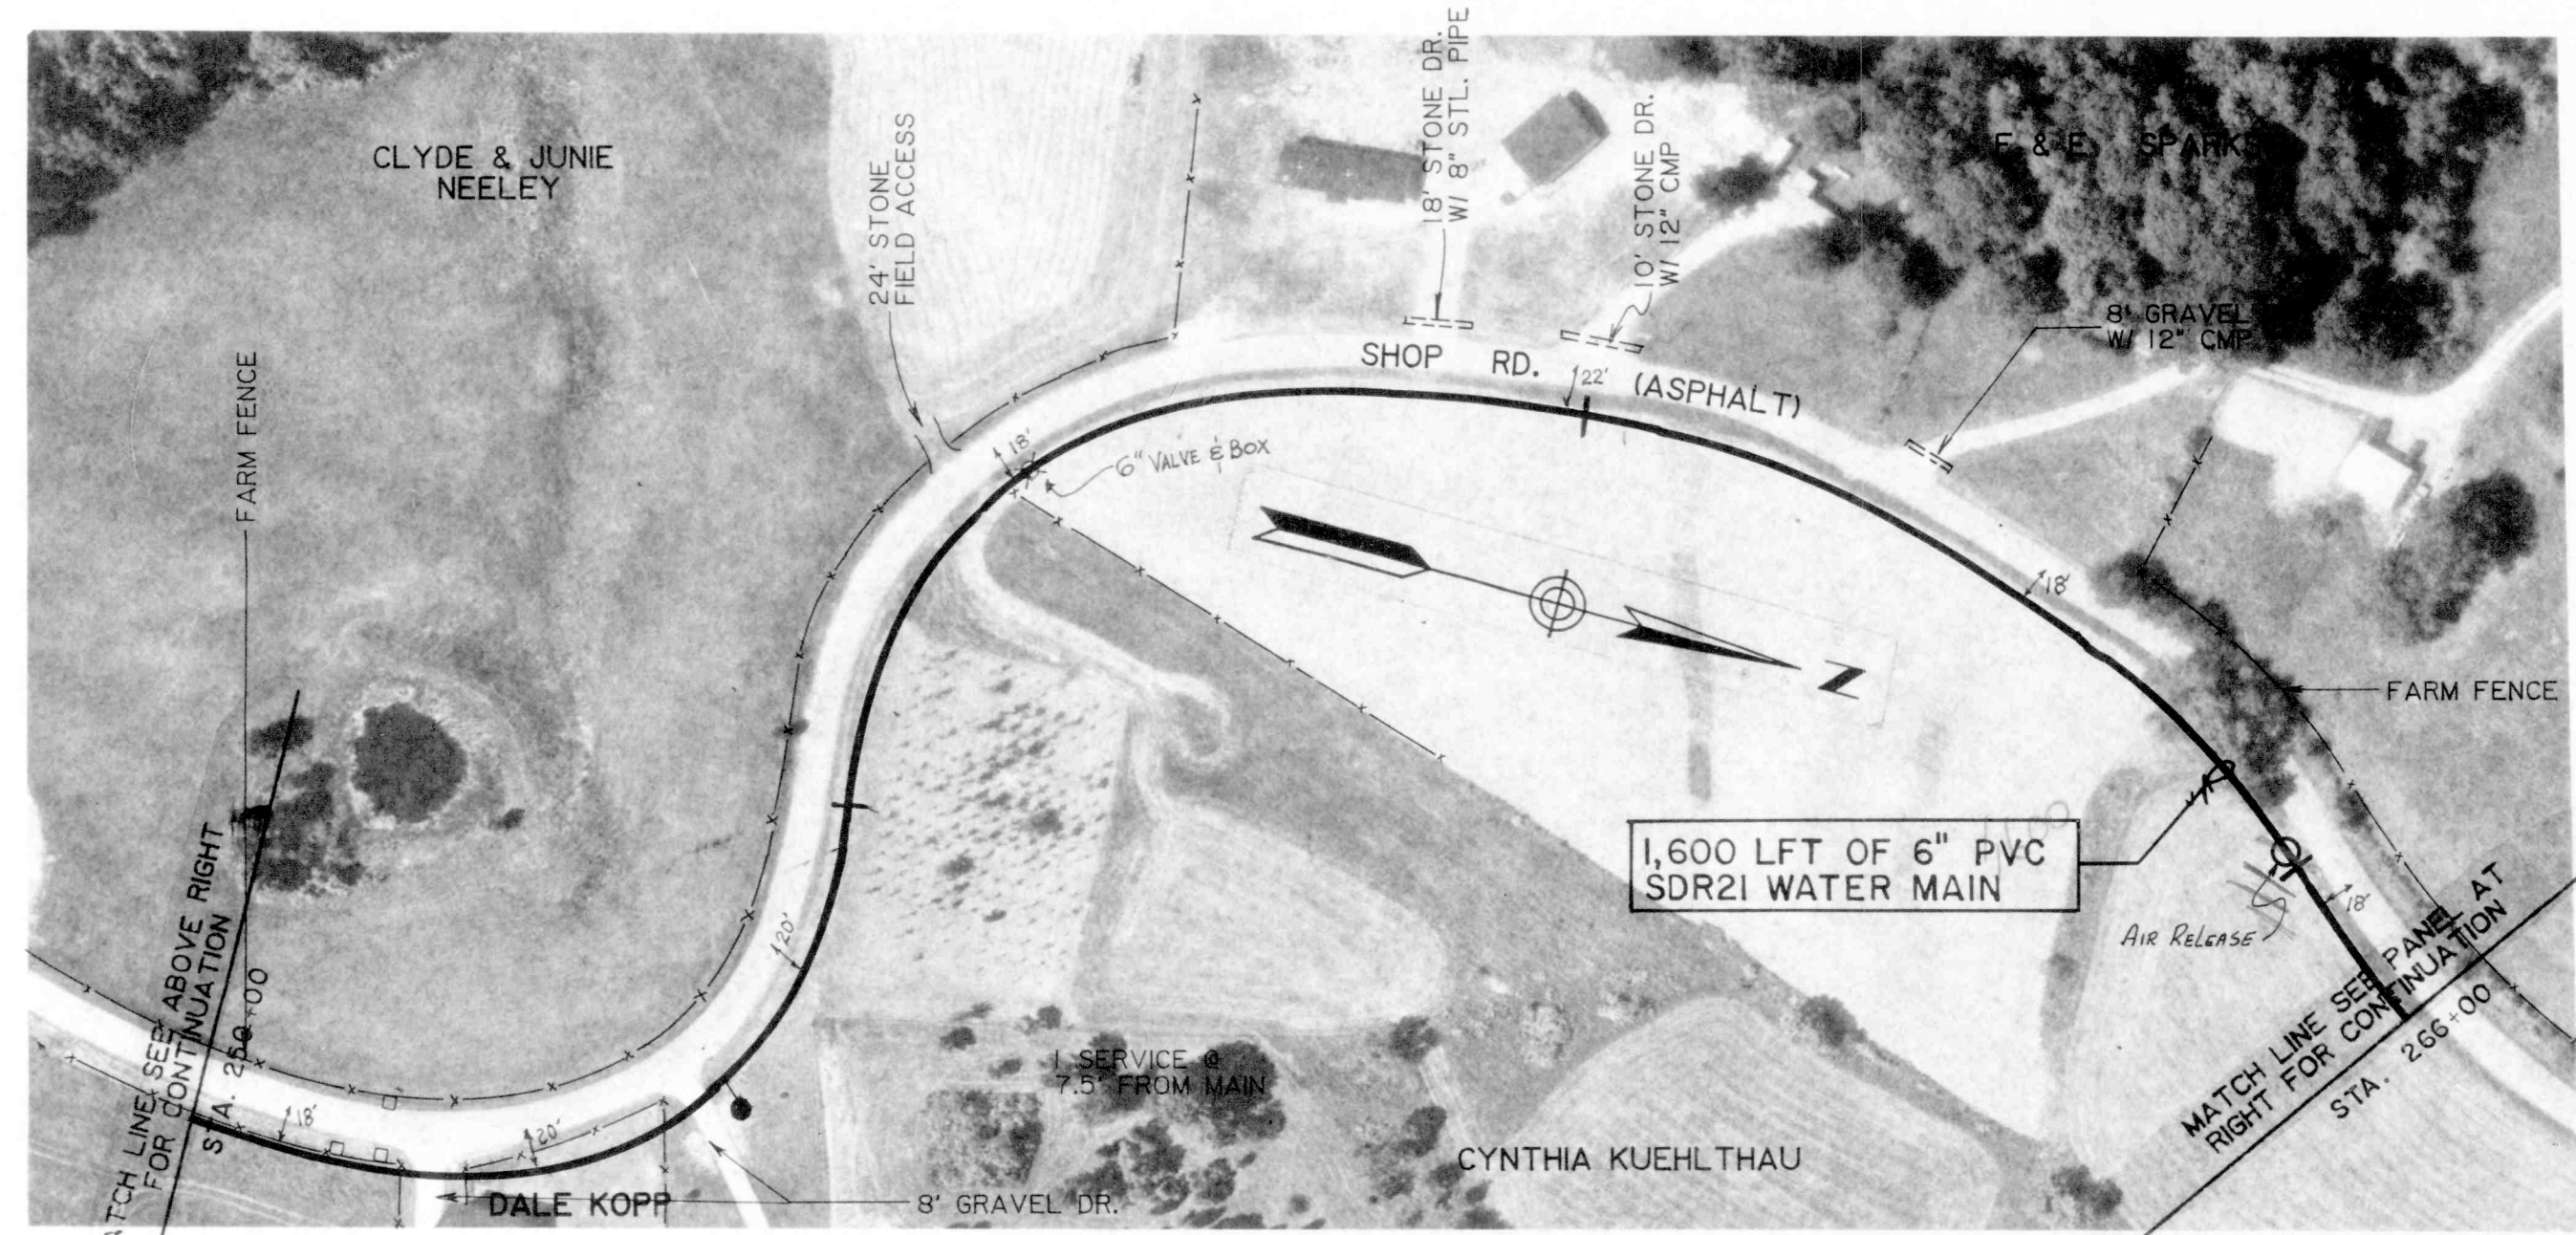

GROUND ELEV. = 975.0 ±
MAX. STATIC PRESS. = 81.1 PSI ±


LINE A-1 SHOP RD.

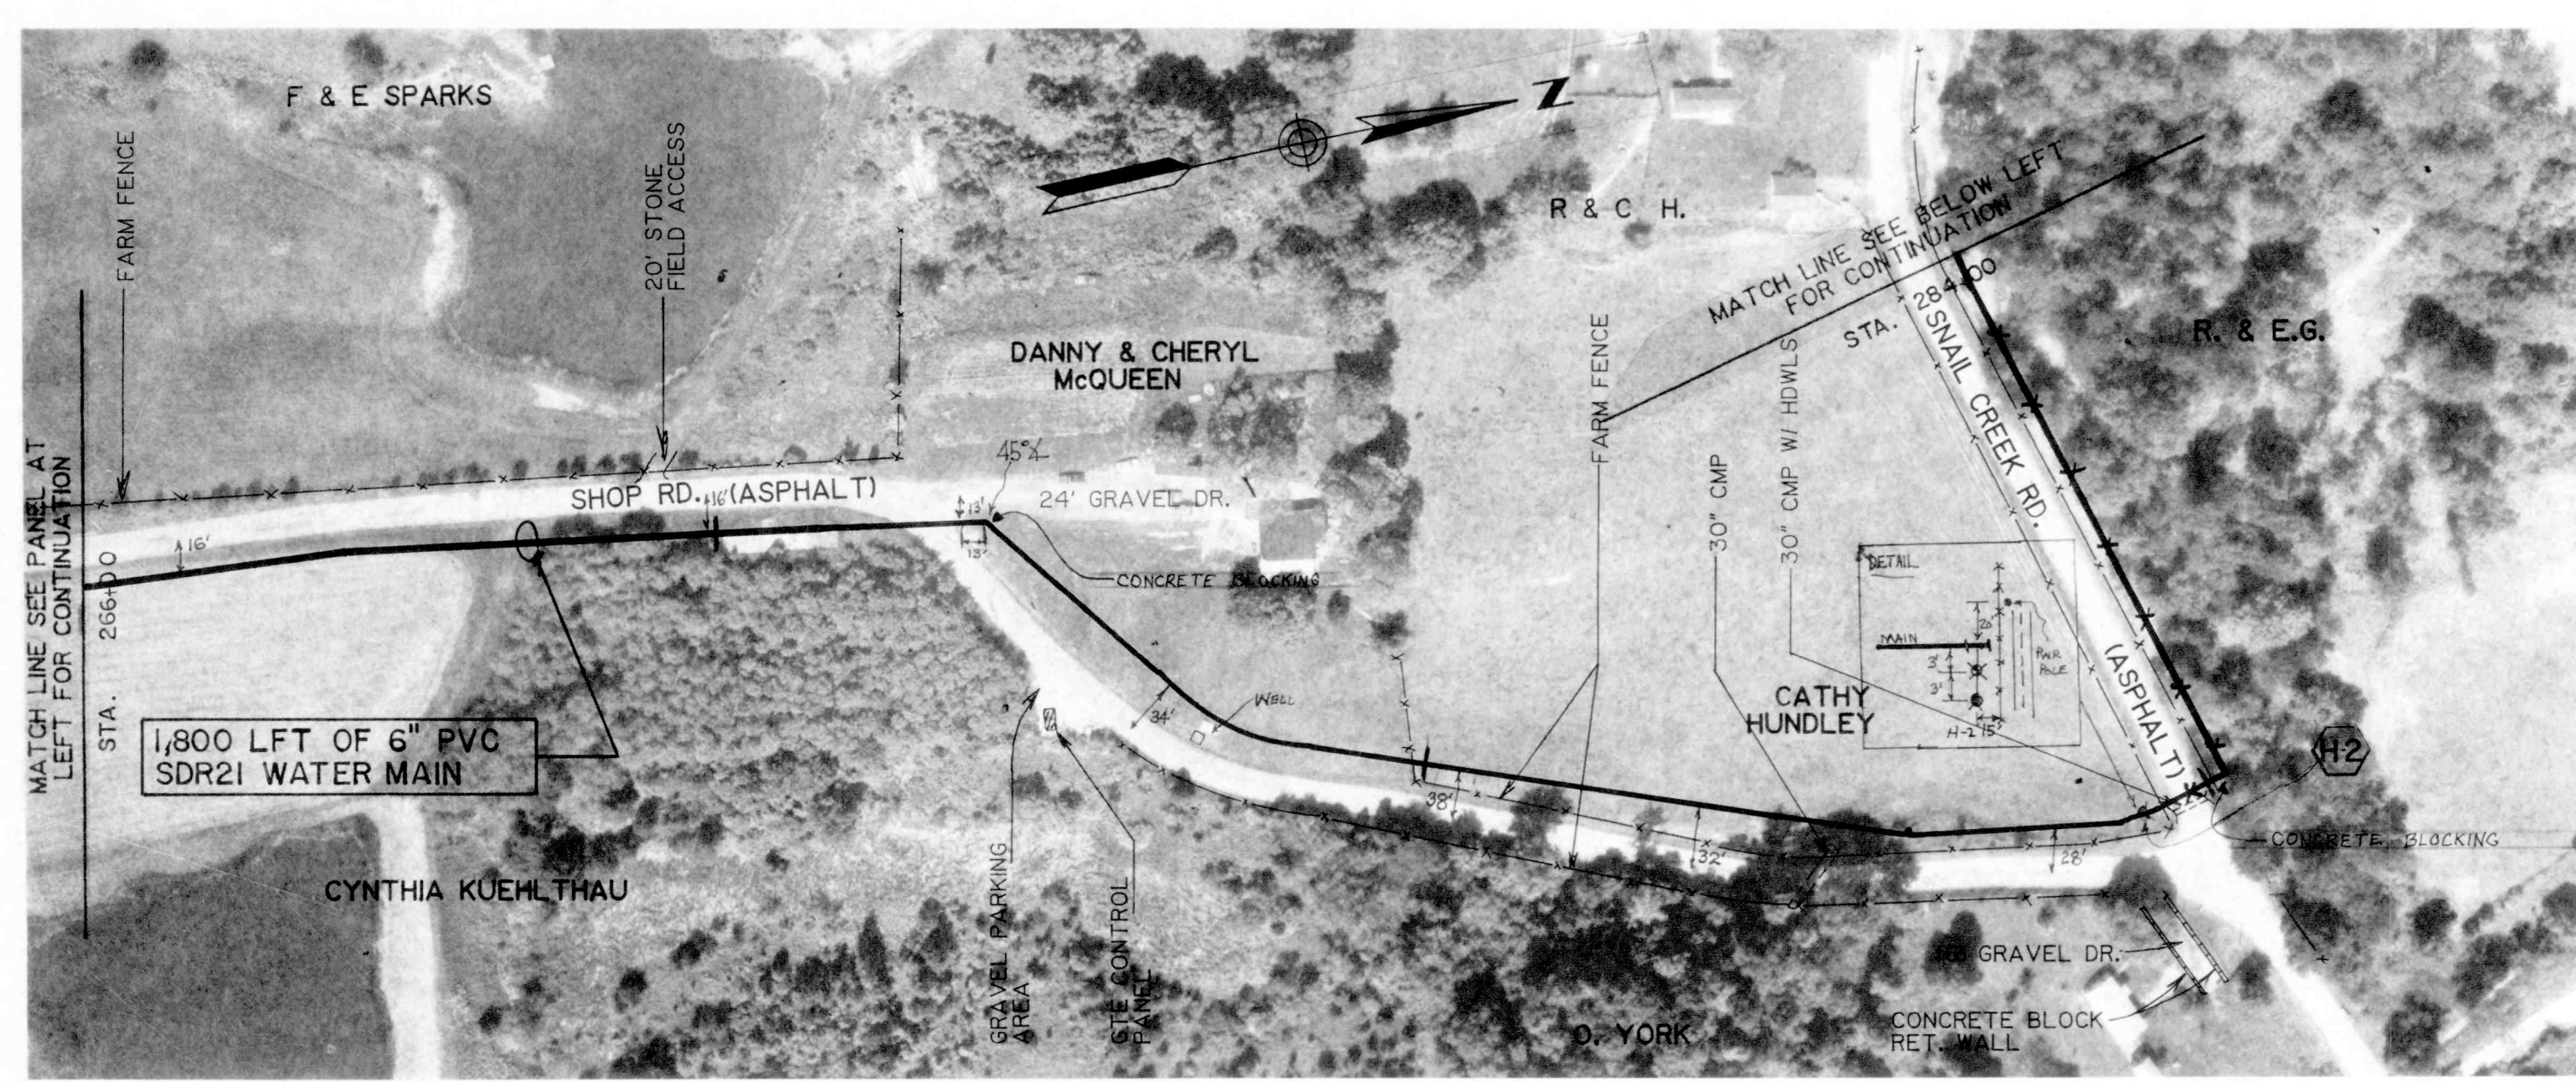

GROUND ELEV. = 932.0 ±
MAX. STATIC PRESS. = 98.7 PSI ±

LINE A-1 SHOP RD.

GROUND ELEV. = 850.0 ±
MAX. STATIC PRESS. = 134.2 PSI ±

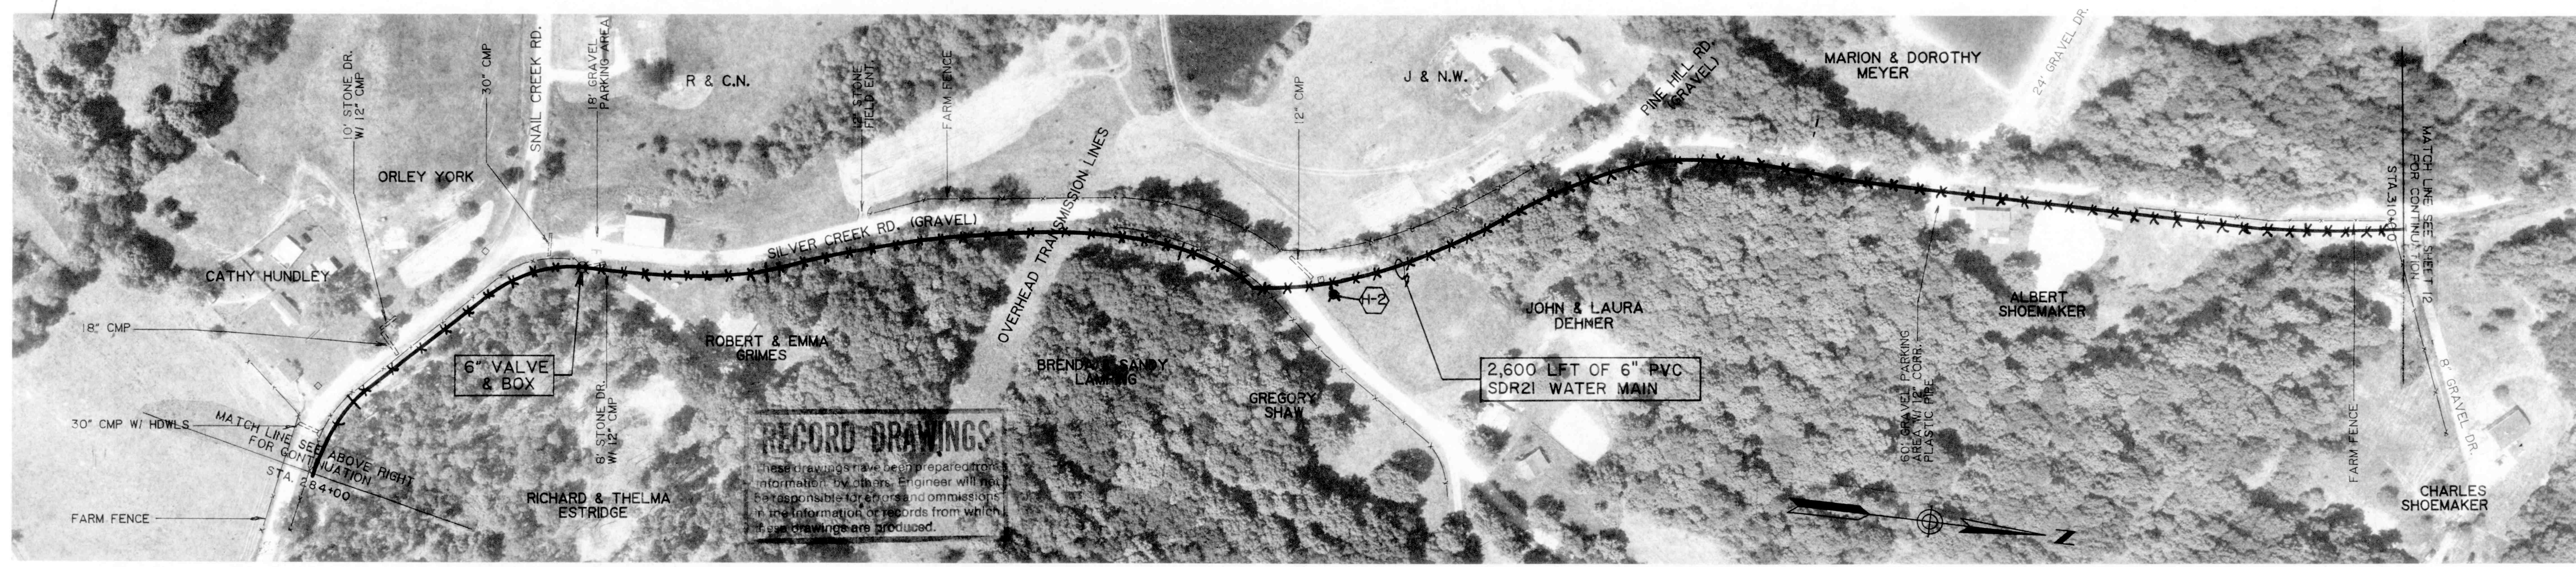

GROUND ELEV. = 850.0 ±
MAX. STATIC PRESS. = 134.2 PSI ±

GROUND ELEV. = 856.0 ±
MAX. STATIC PRESS. = 131.6 PSI ±

LINE A-1 SILVER CREEK RD.

GROUND ELEV. = 925.0 ±
MAX. STATIC PRESS. = 101.7 PSI ±

GROUND ELEV. = 865.0 ±
MAX. STATIC PRESS. = 127.7 PSI ±

CONTRACT "A"
WATER MAINS
LINE "A-1"
DIVISION "E"
WATERWORKS SYSTEM IMPROVEMENTS

M.D. WESSLER and ASSOCIATES
CONSULTING ENGINEERS
8219 South East Street, Suite A
Indianapolis, Indiana 46227-2148

SCALE: 1" = 100'
DATE: OCT. 14, 1993
PROJECT NO.: 37391.04
DRAWN BY: CLG
APPROVED BY: DGC

NOT PUBLISHED
ALL RIGHTS RESERVED
EXCEPT FOR USES EXPRESSLY
PERMITTED IN WRITING, INFOR-
MATION SHOWN OR INCLUDED
IN THIS DOCUMENT IS SOLELY
THE PROPERTY OF M.D.
WESSLER & ASSOCIATES, INC.

PROFESSIONAL ENGINEER
NO. 13334
STATE OF INDIANA
SHEET A 18
OF 45