


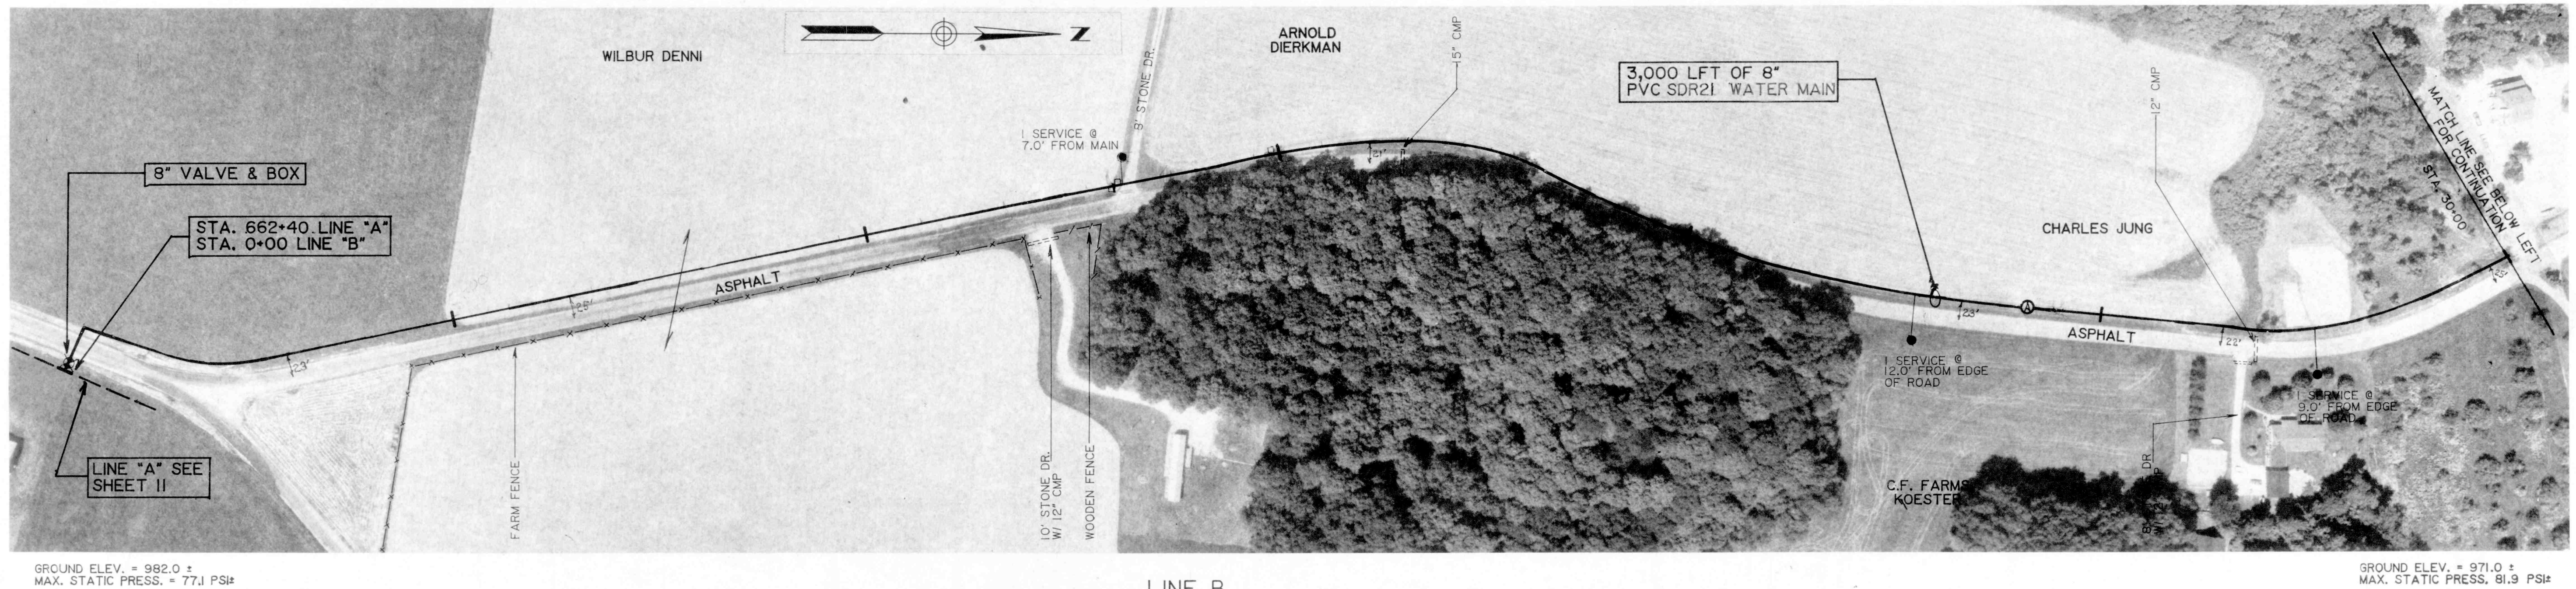


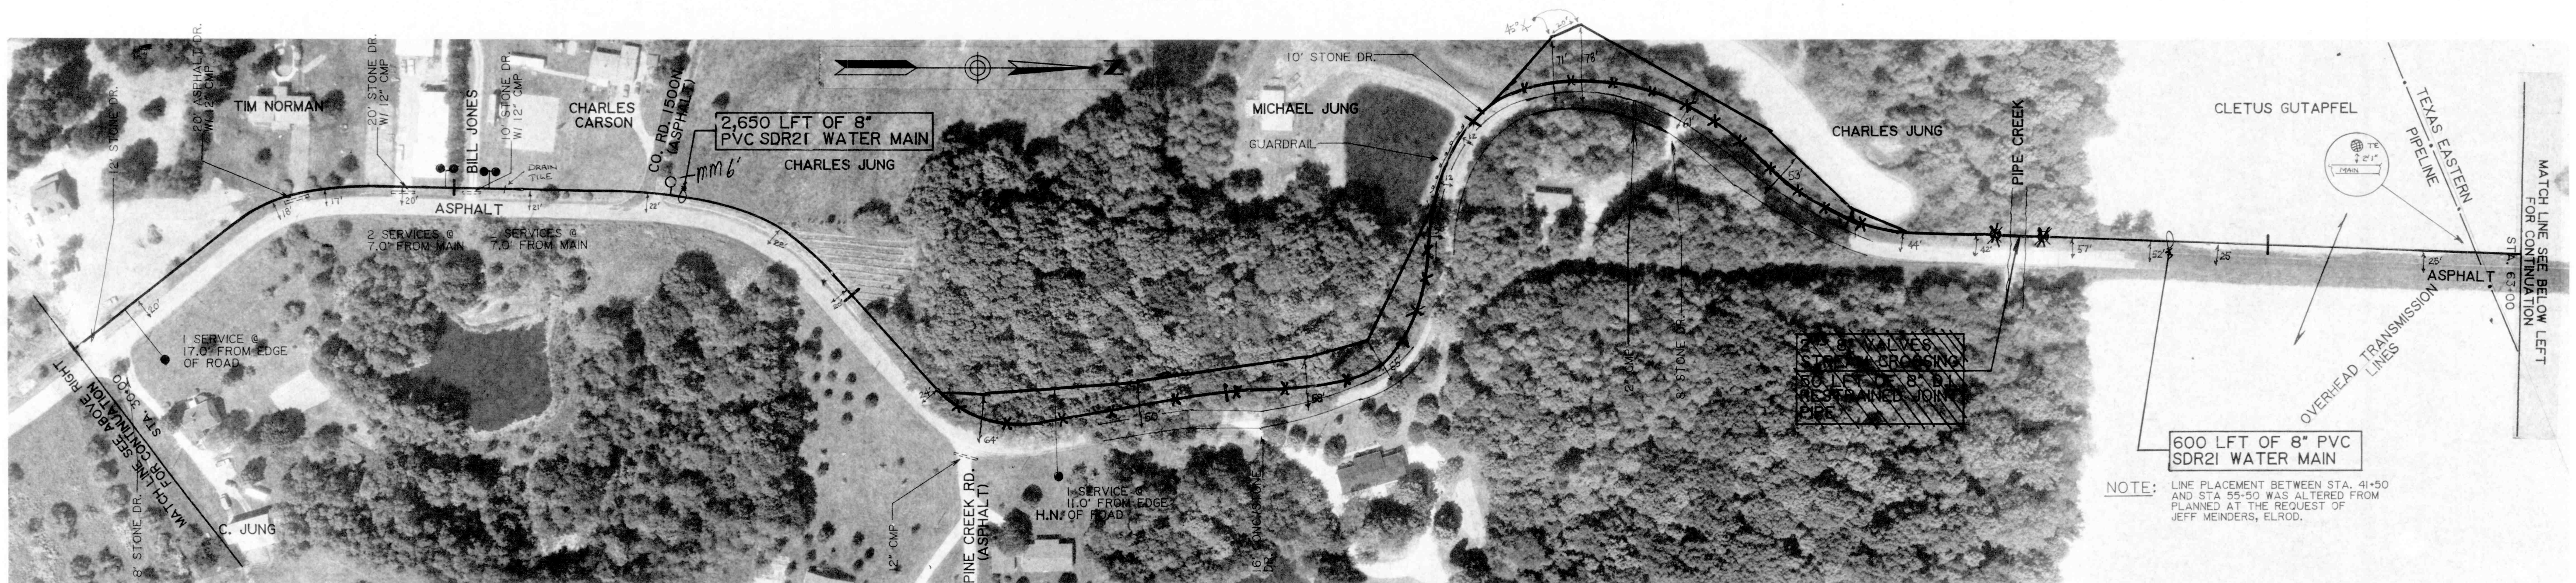

LINE B

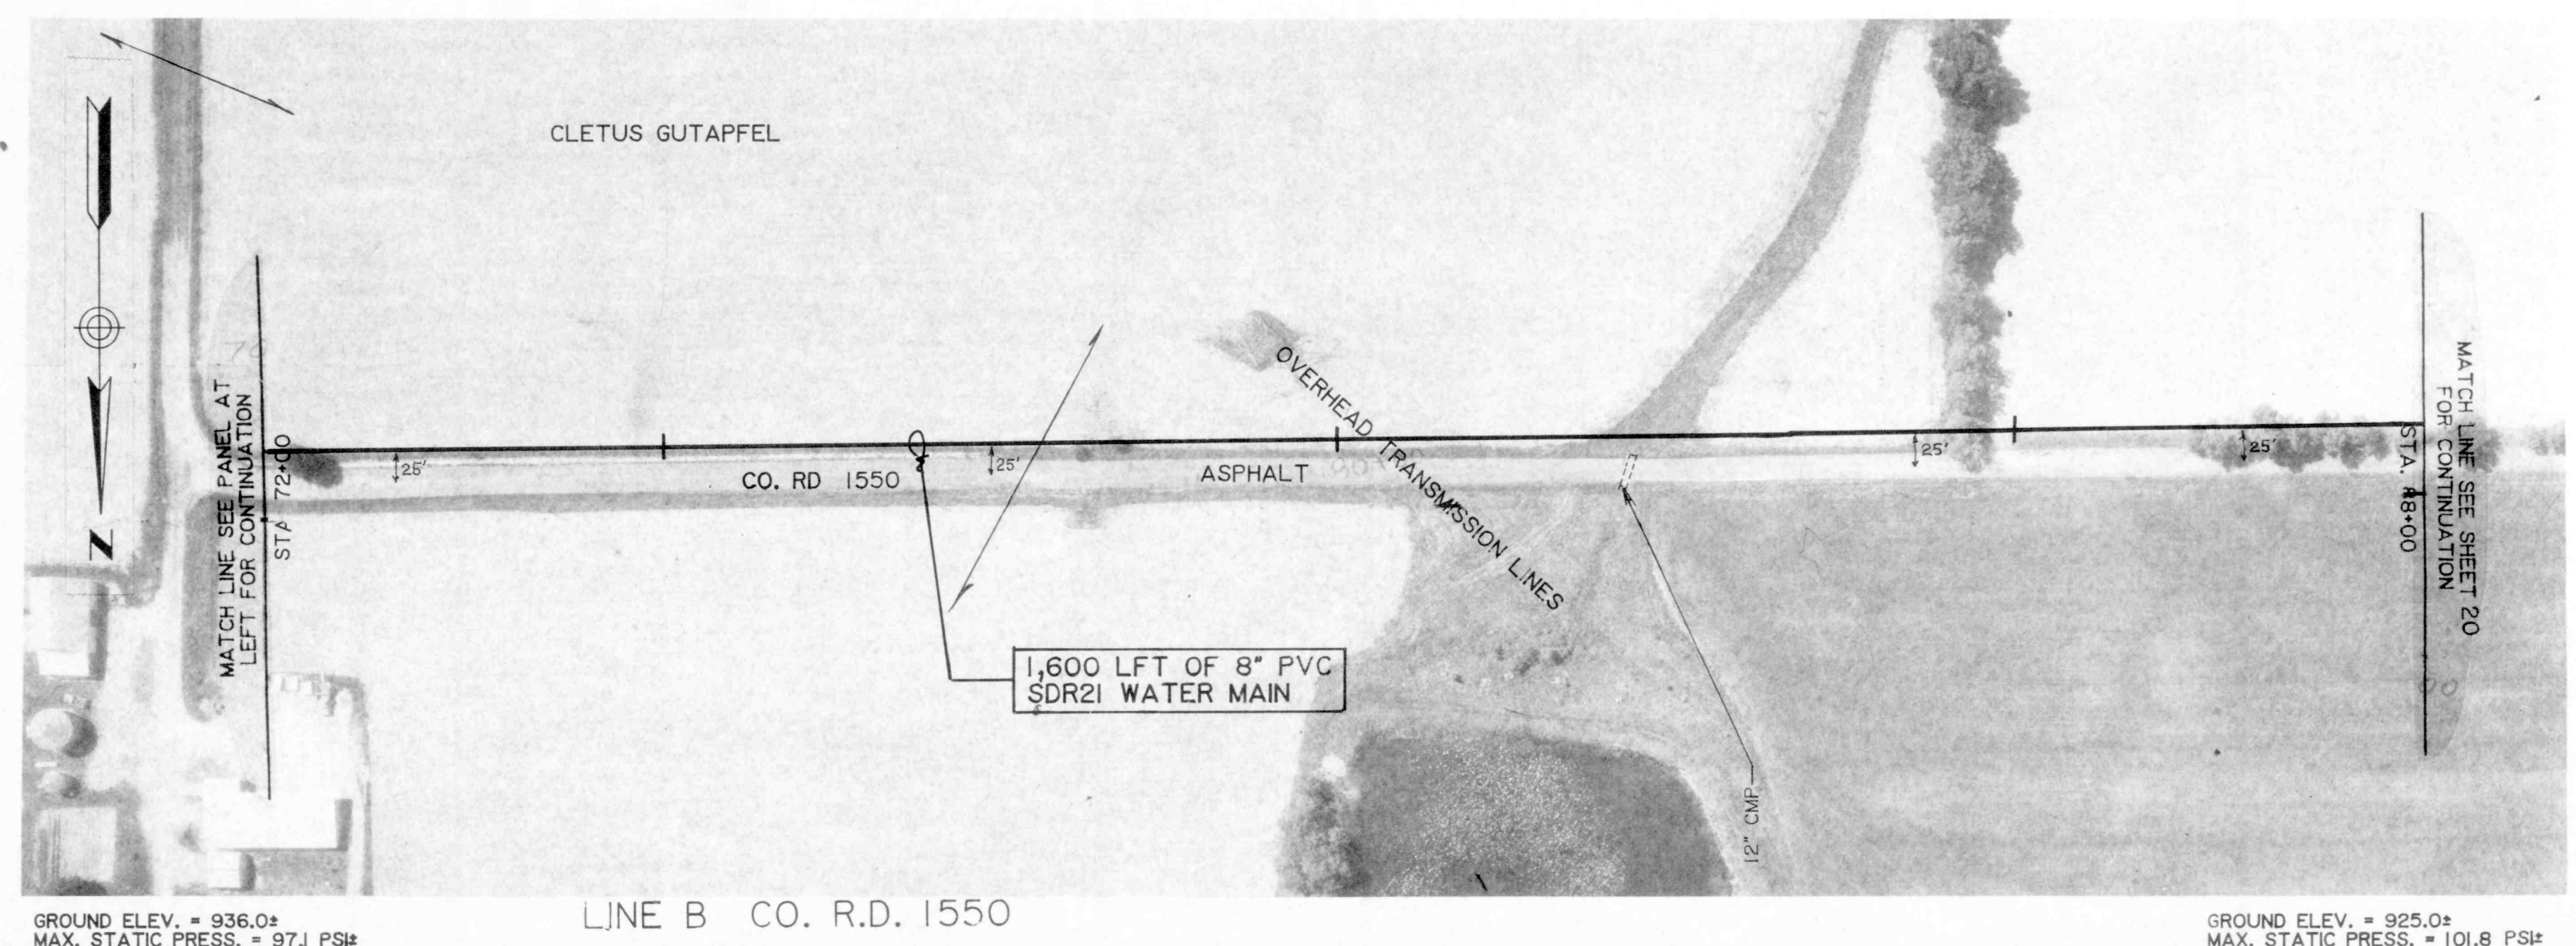

LINE B

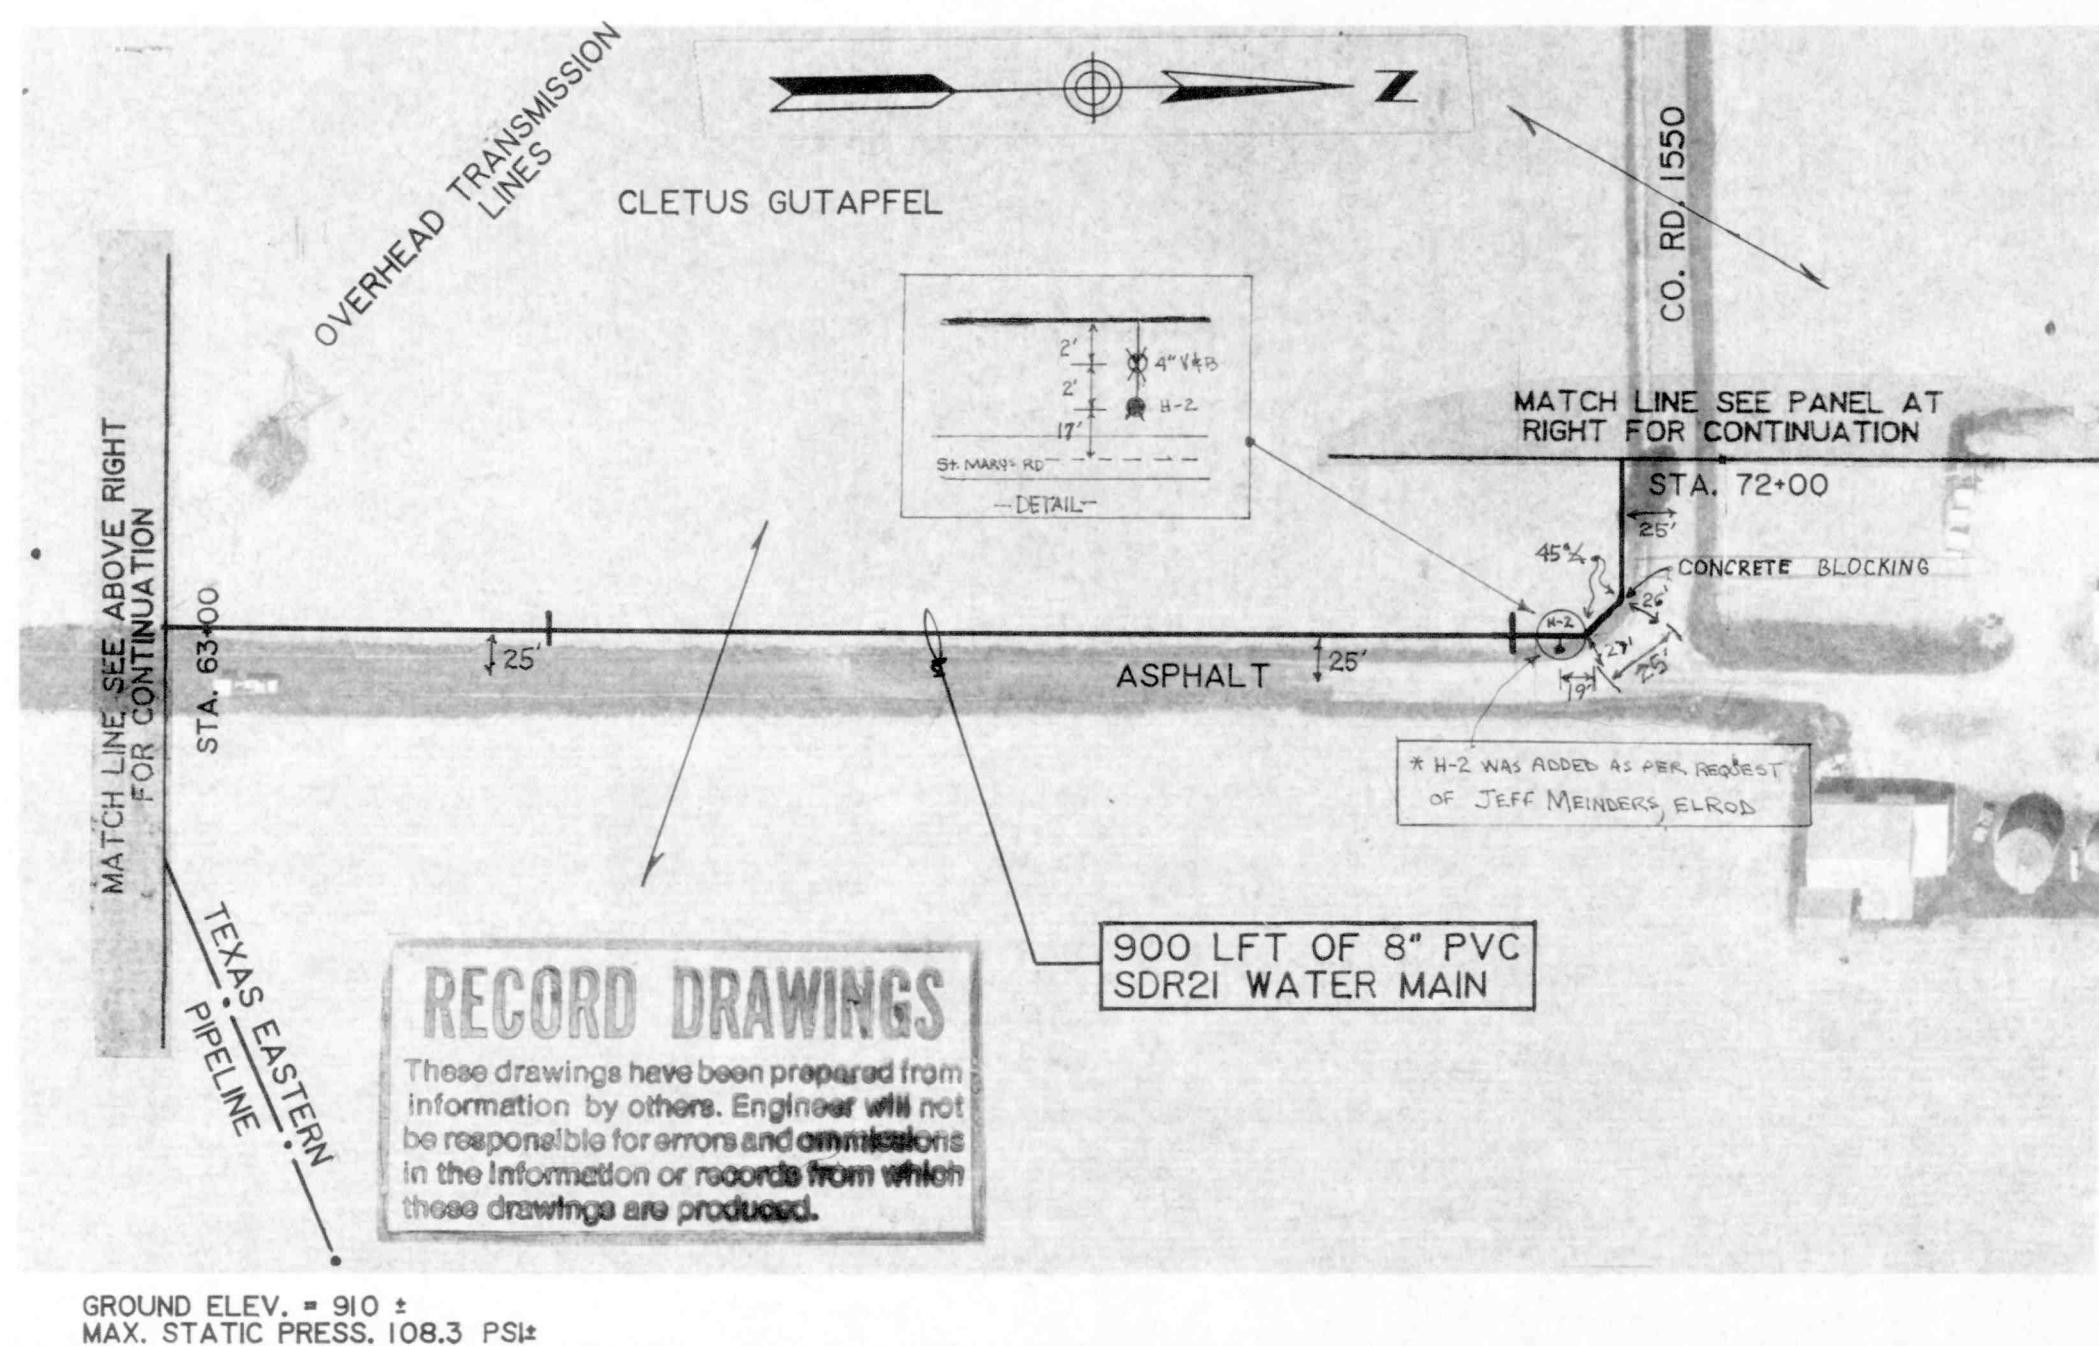

LINE B CO. R.D. 1550

CONTRACT "A" WATER MAINS LINE "B"		ELROD WATER COMPANY, INC. DIVISION "E" WATERWORKS SYSTEM IMPROVEMENTS	
M.D. WESSLER and ASSOCIATES CONSULTING ENGINEERS 8219 South East Street, Suite A Indianapolis, Indiana 46227-2148		SCALE: 1" = 100' DATE: OCT. 14, 1993 PROJECT NO.: 37391.04 DRAWN BY: CLG APPROVED BY: DGC	
EXCEPT FOR USES EXPRESSLY PERMITTED IN WRITING, INFORMATION SHOWN OR INCLUDED IN THIS DOCUMENT IS SOLELY THE PROPERTY OF M.D. WESSLER & ASSOCIATES, INC.		SHEET A 19 OF 45	