
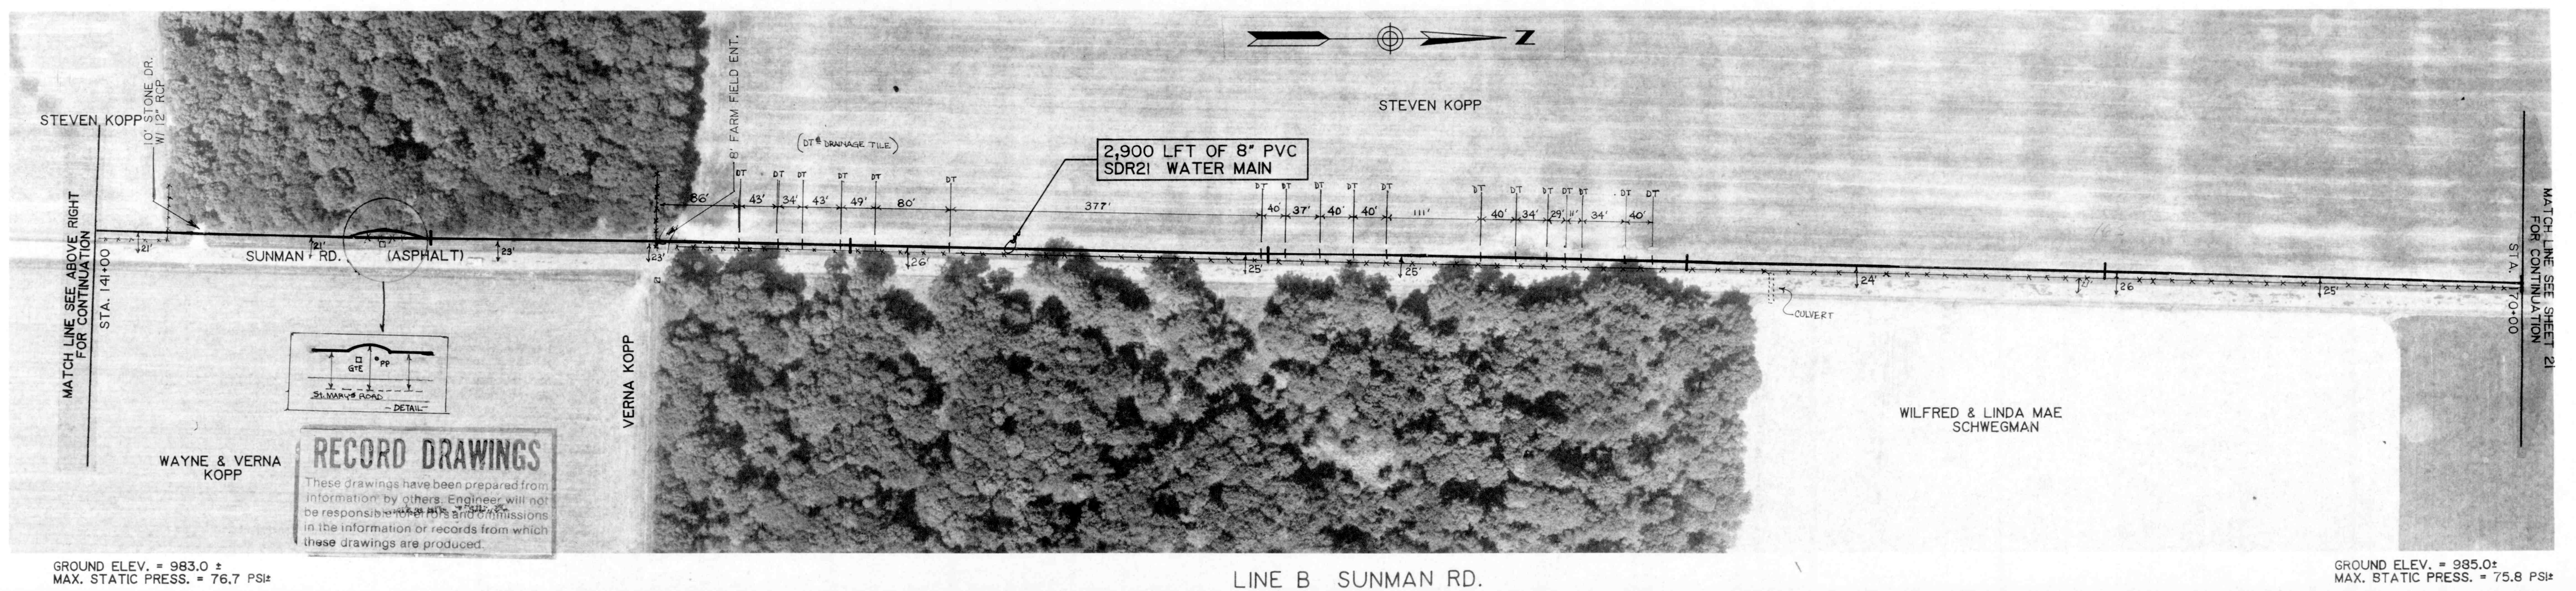
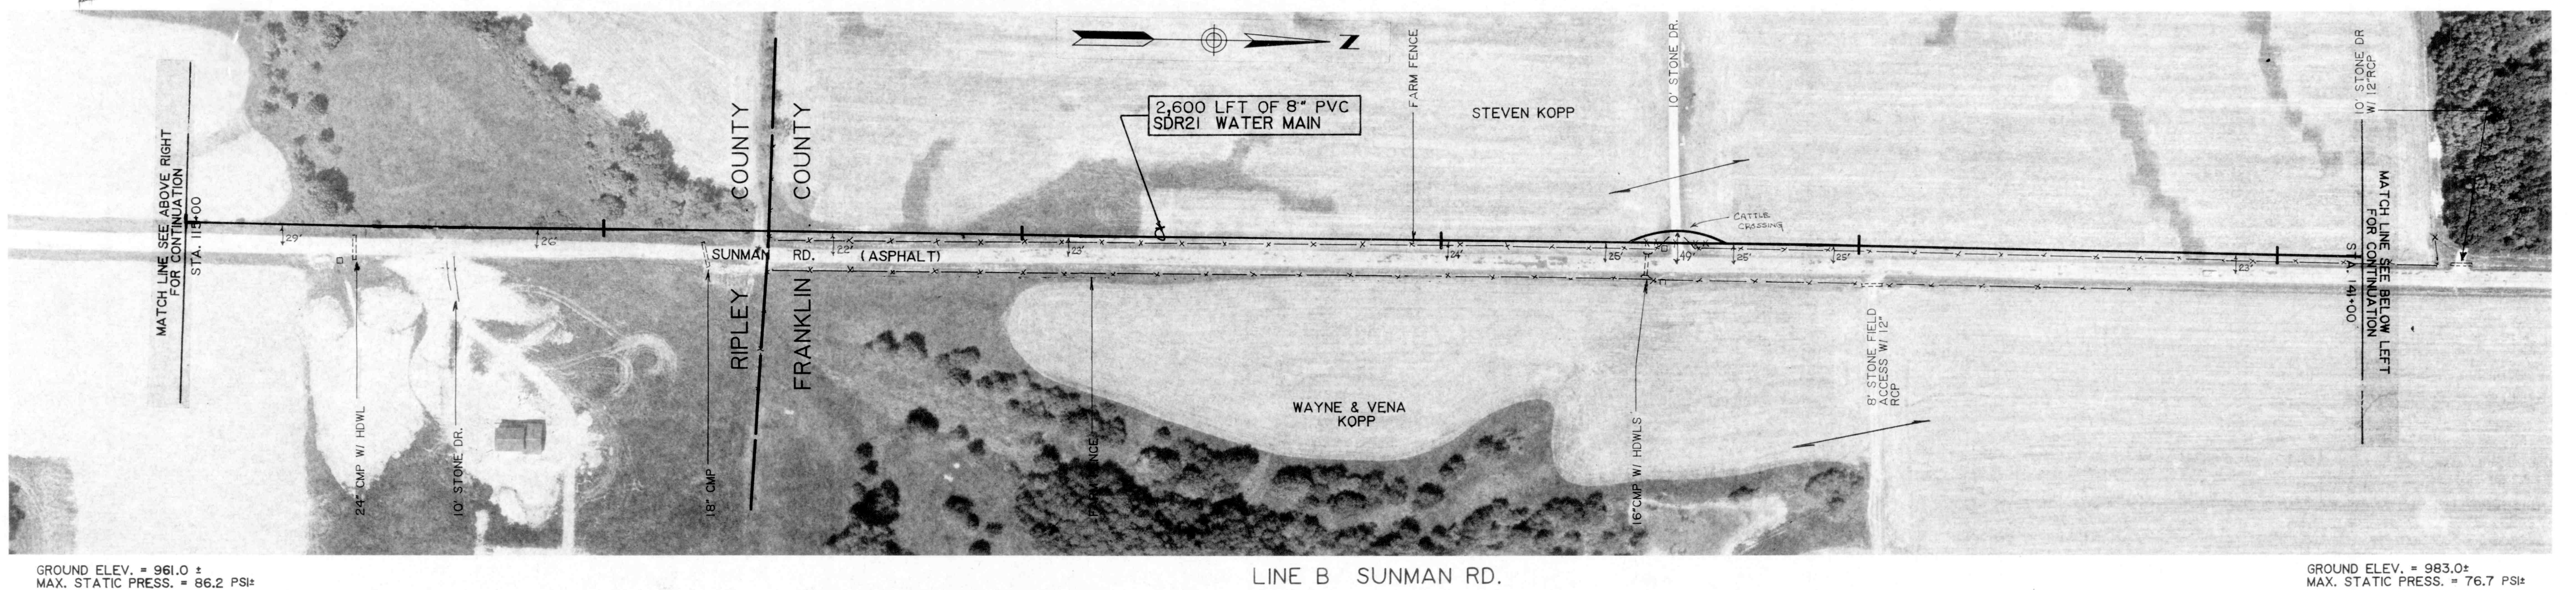
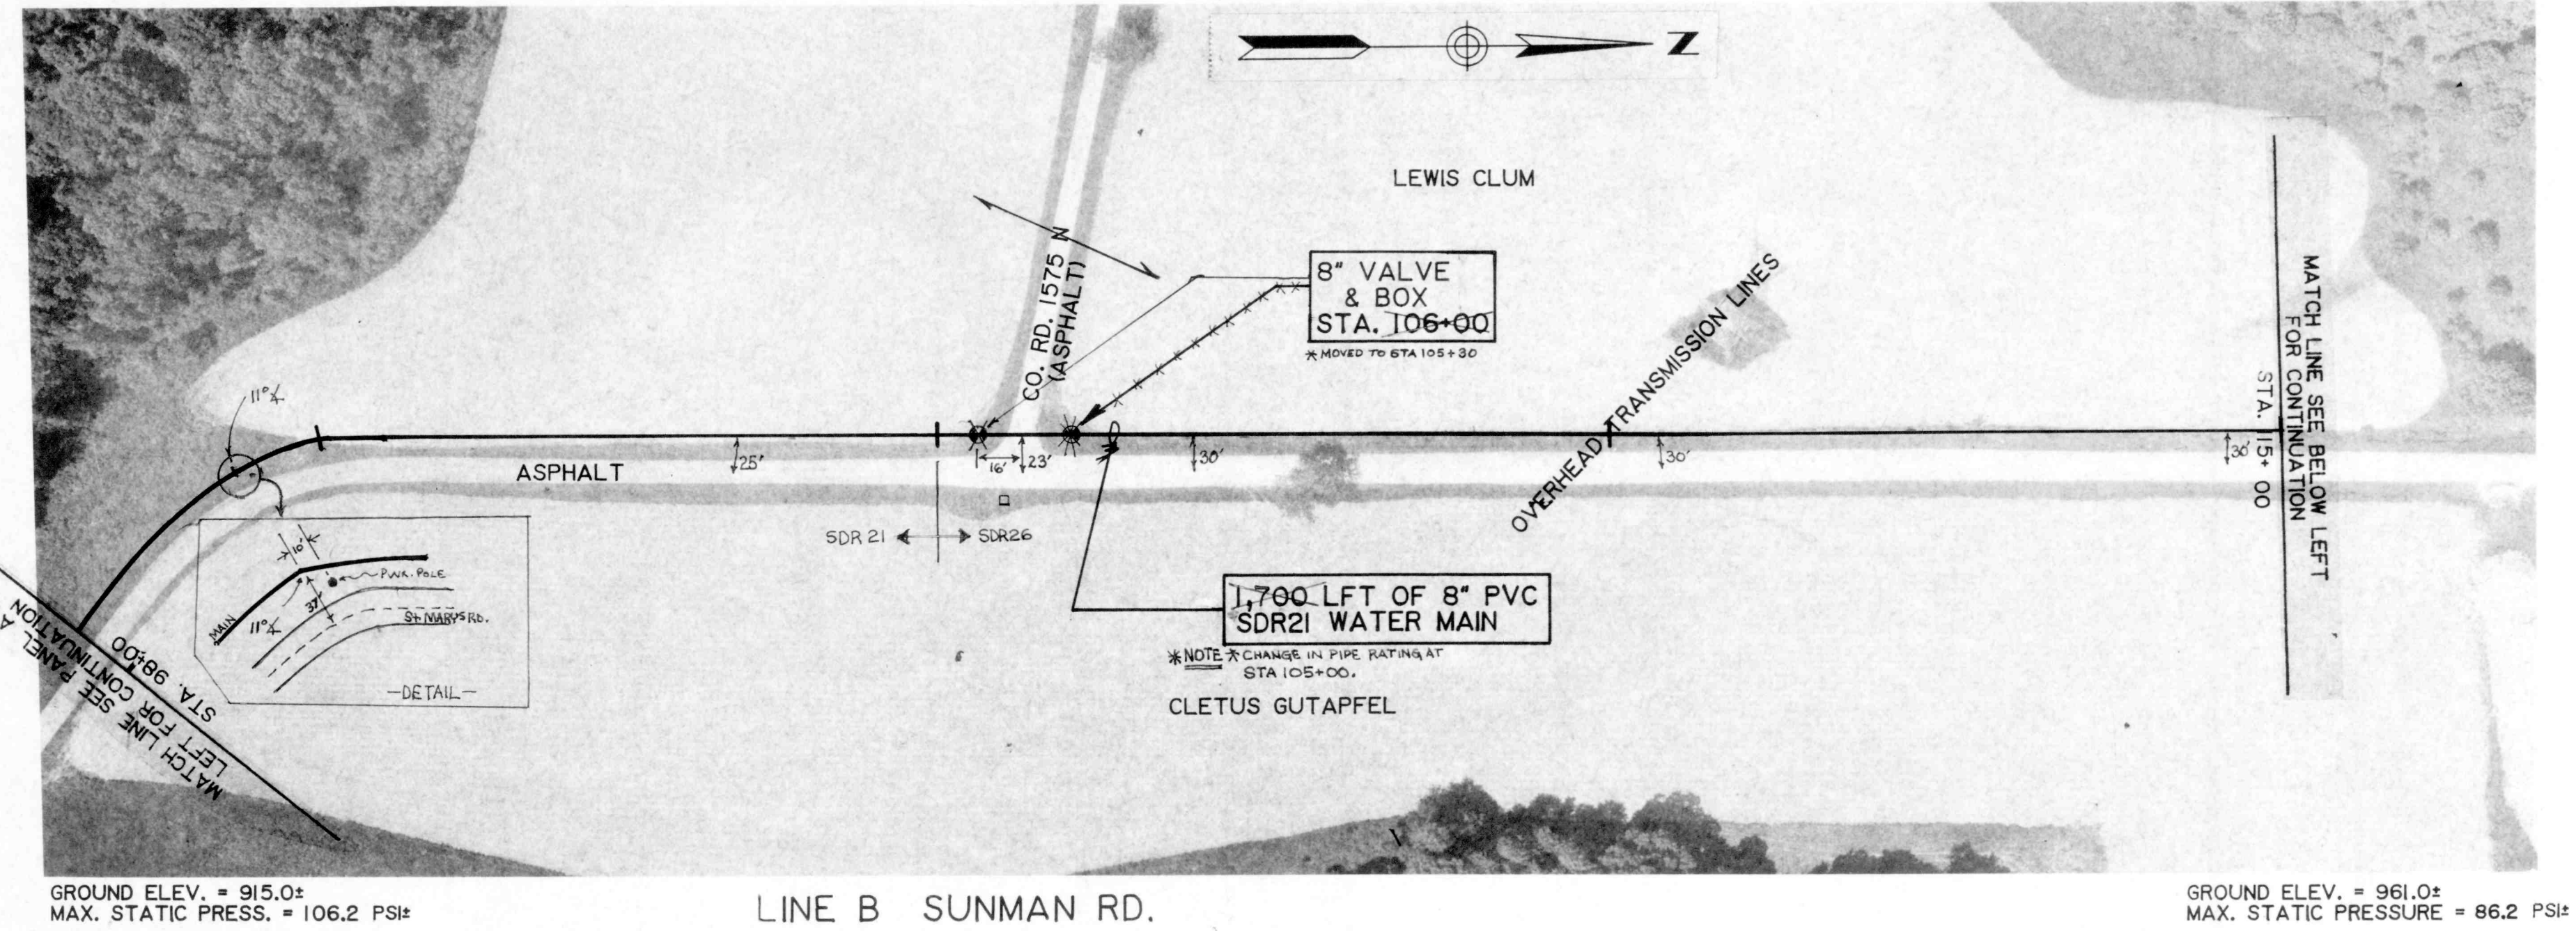


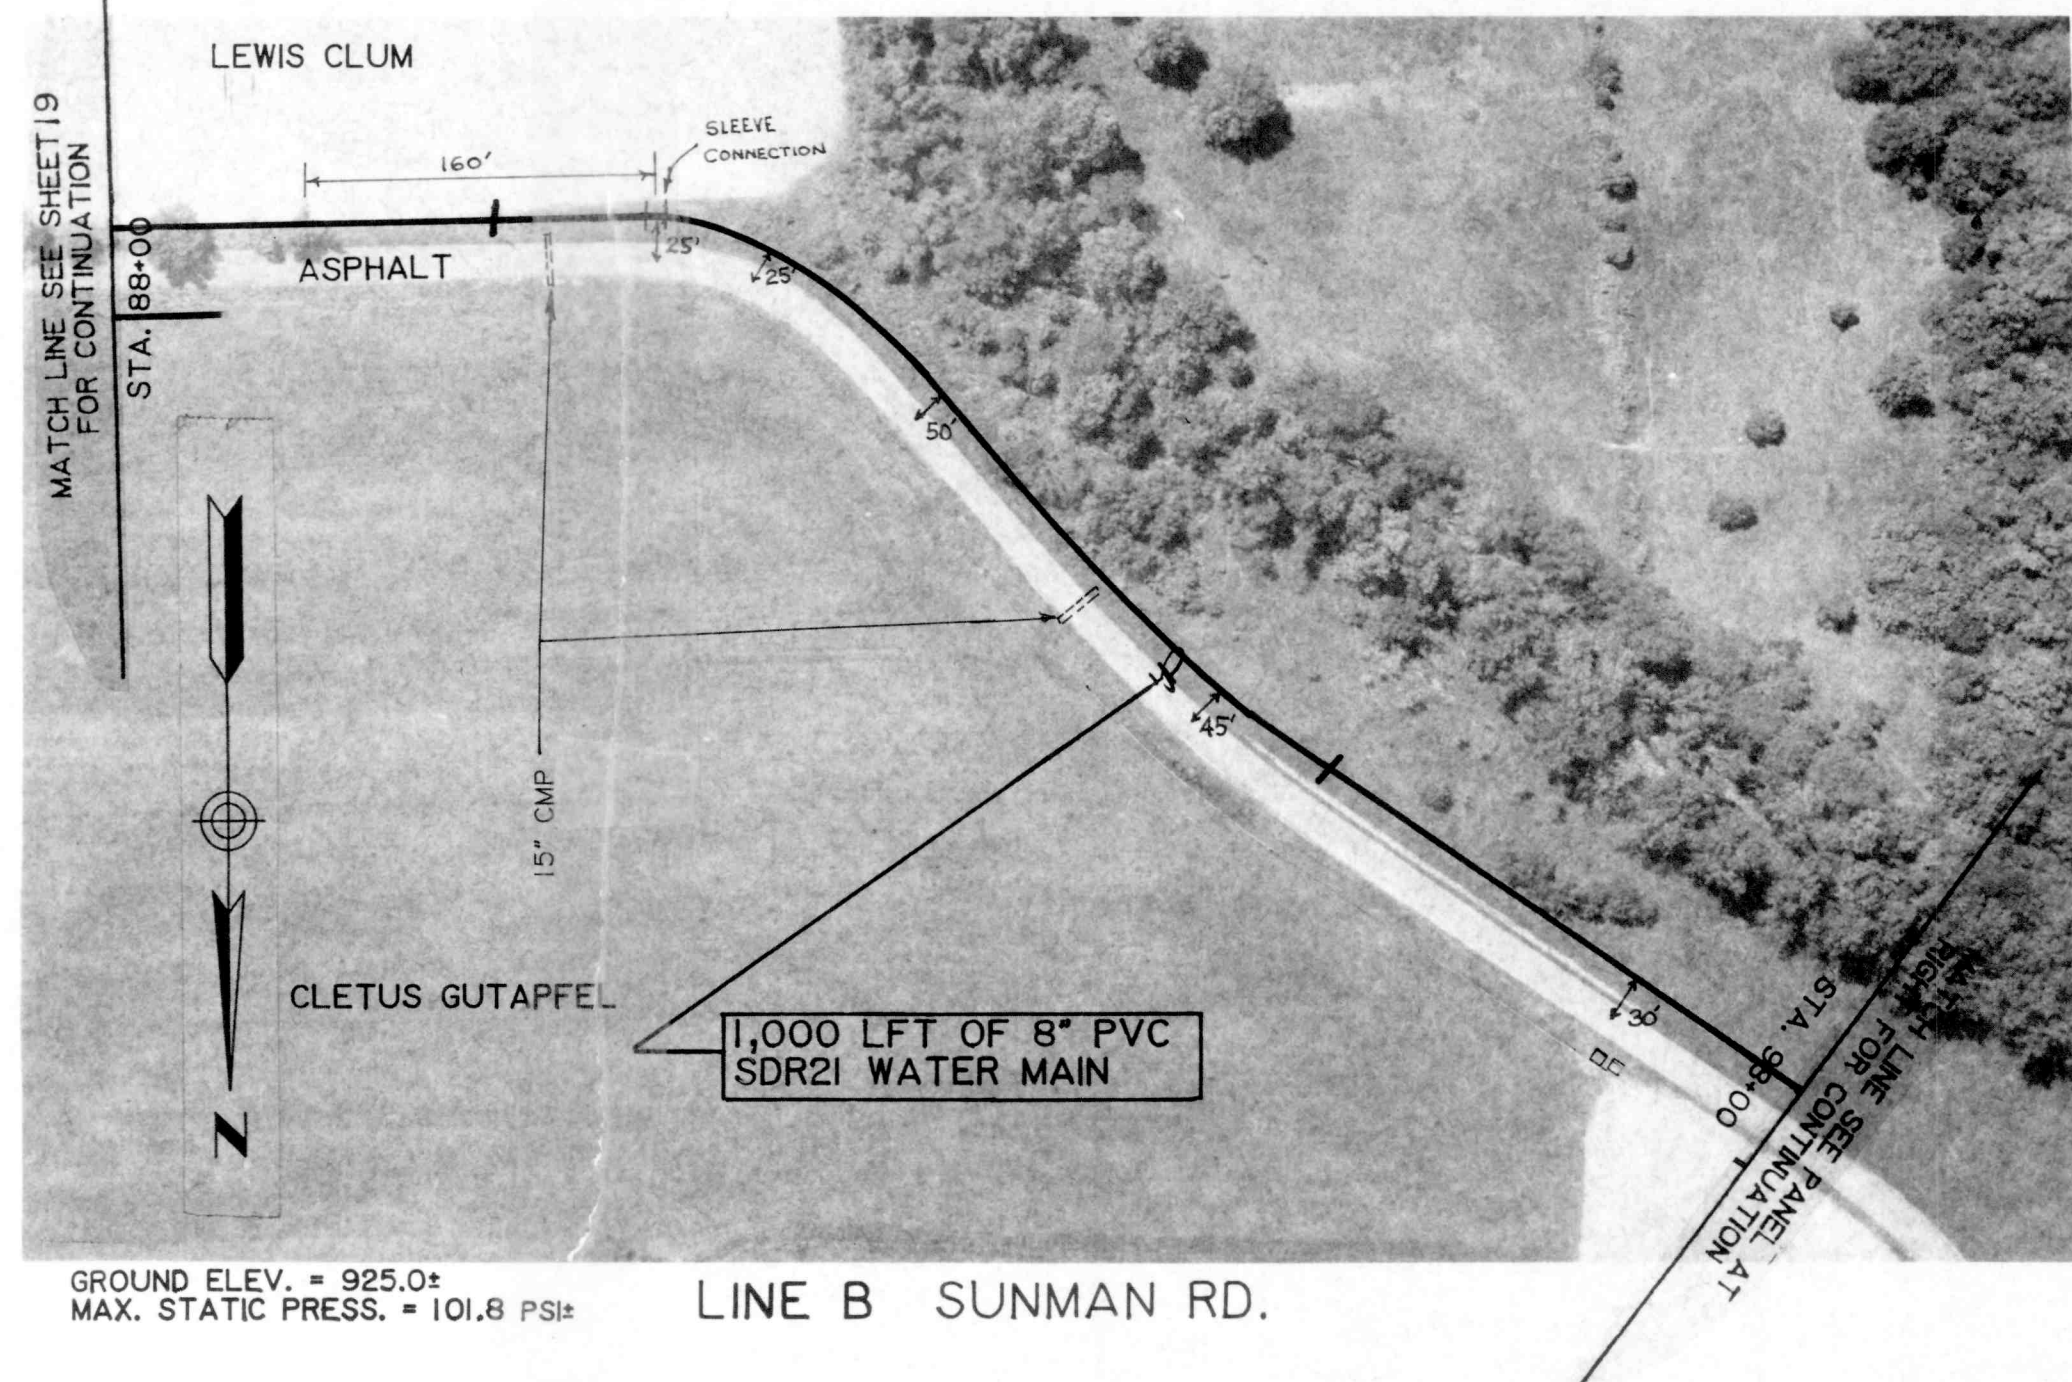

CONTRACT "A" WATER MAINS LINE "B"		ELROD WATER COMPANY, INC. DIVISION "E" WATERWORKS SYSTEM IMPROVEMENTS	
SCALE: 1" = 100' DATE: OCT. 14, 1993 PROJECT NO.: 37391.04 DRAWN BY: CLG APPROVED BY: DGC	NOT PUBLISHED ALL RIGHTS RESERVED EXCEPT FOR USES EXPRESSLY PERMITTED IN WRITING, INFOR- MATION SHOWN OR INCLUDED IN THIS DOCUMENT IS SOLELY THE PROPERTY OF M.D. WESSLER & ASSOCIATES, INC.	SHEET A 20 OF 45	PHOTOGRAPHY BY: AGU-AIR SURVEYS, INC., SEYMOUR, INDIANA