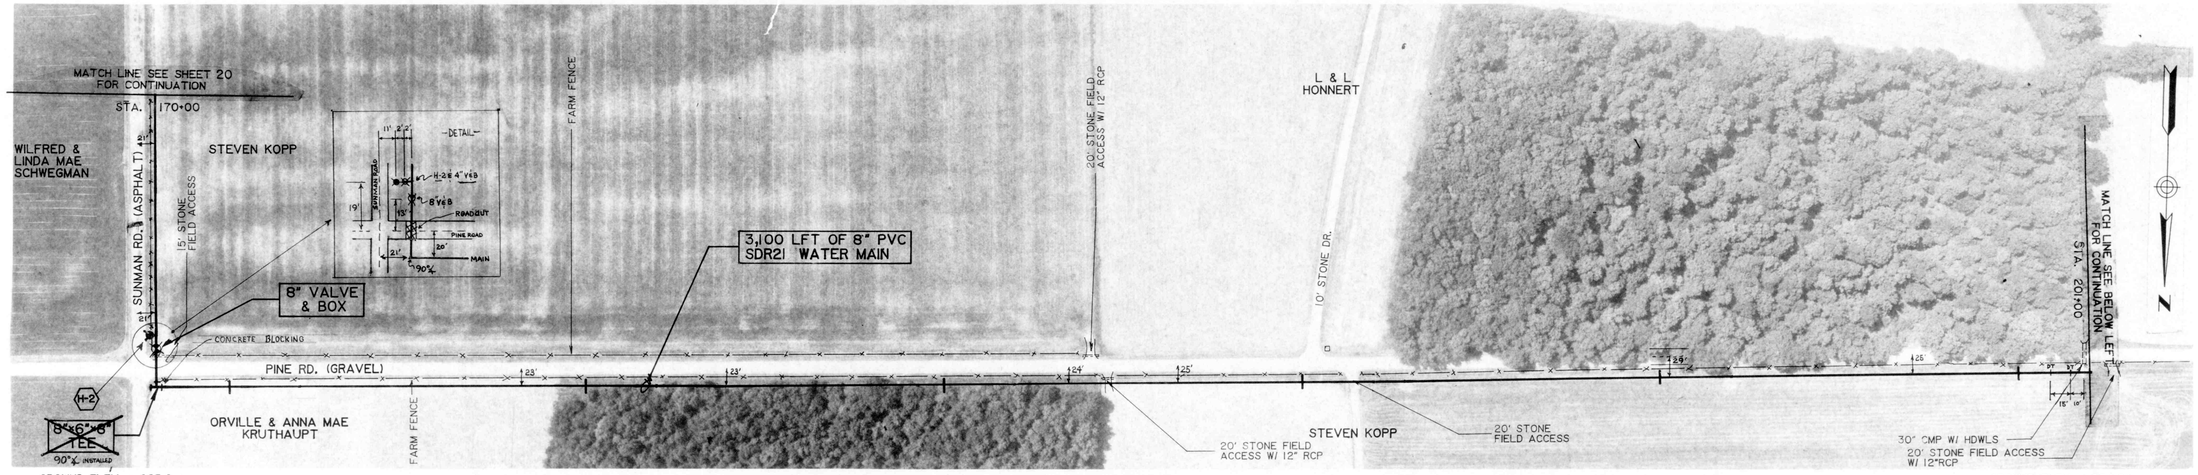

LINE B PINE RD.

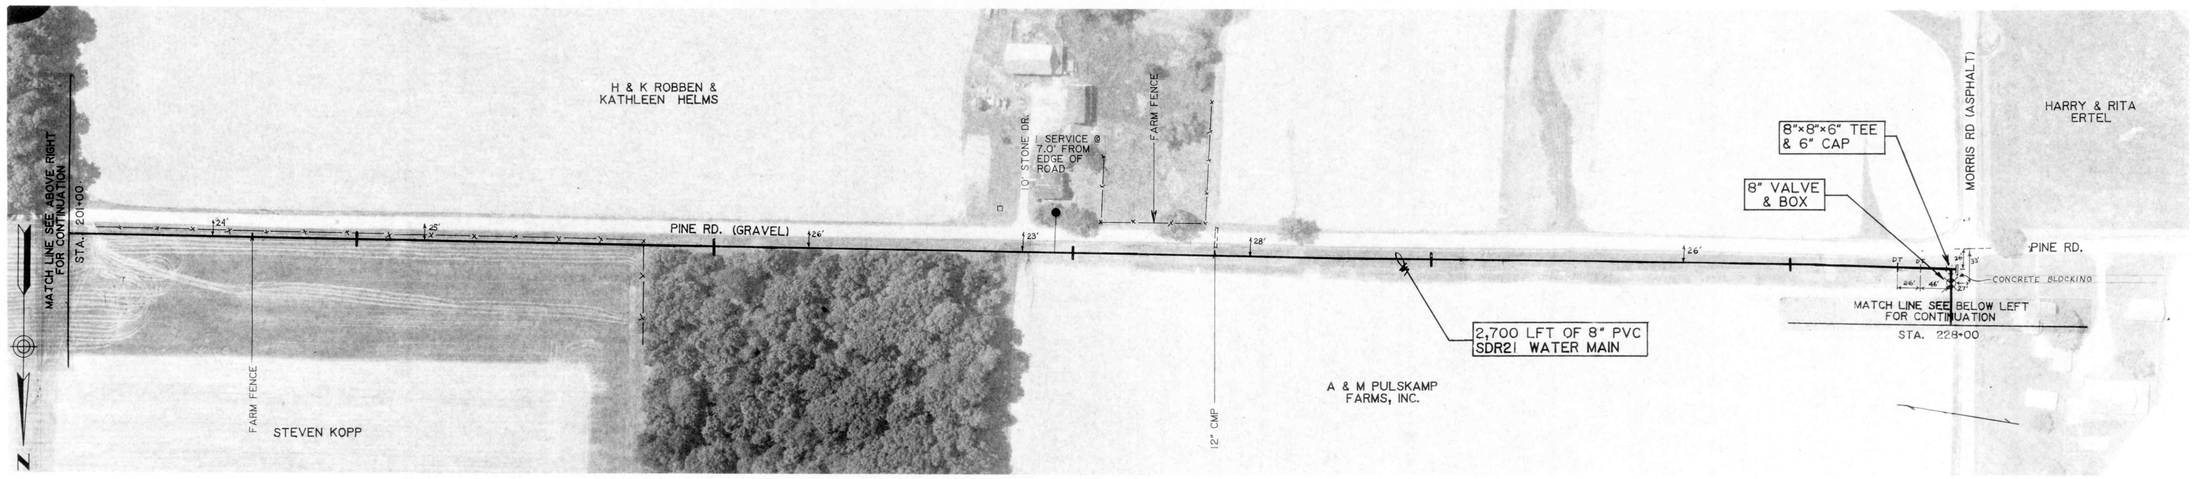

LINE B PINE RD

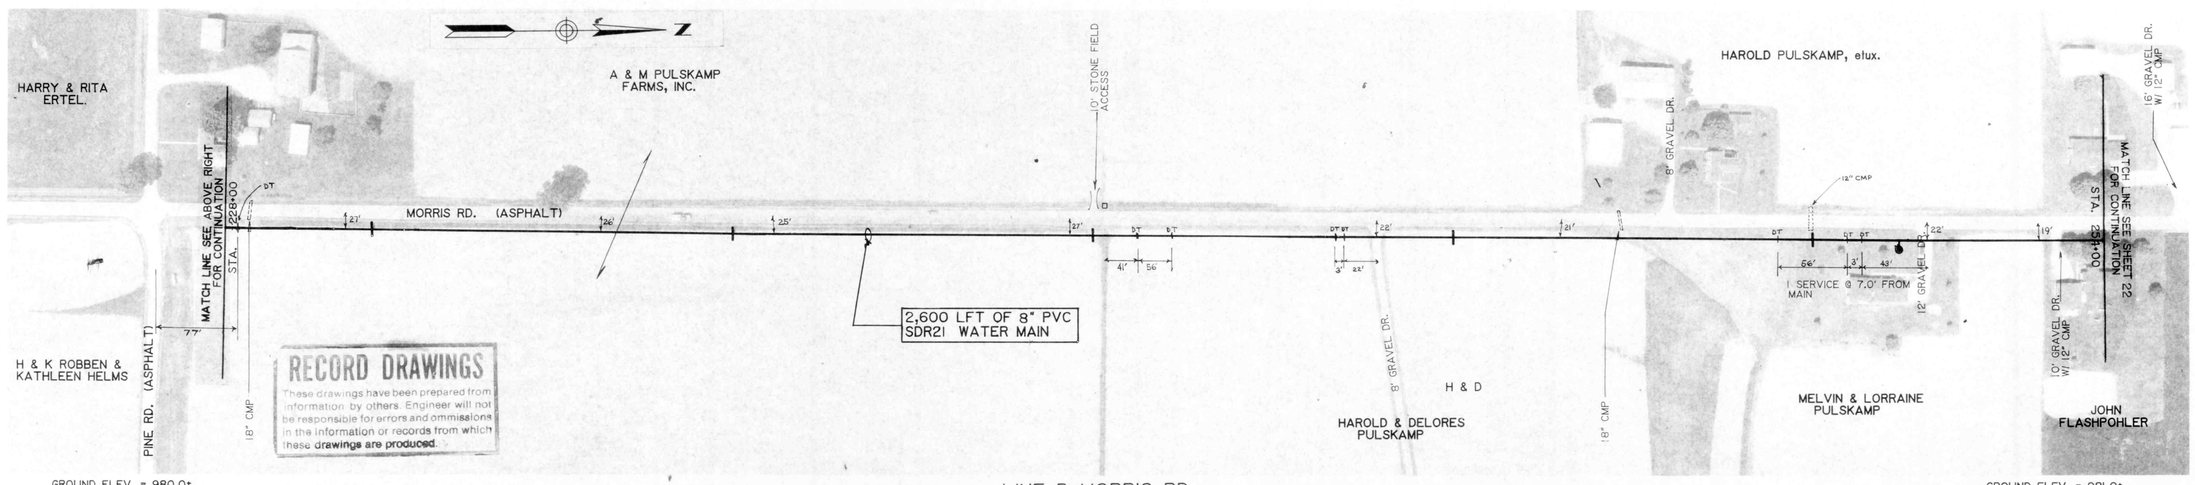

LINE B MORRIS RD.

RECORD DRAWINGS

These drawings have been prepared from information by others. Engineer will not be responsible for errors and ommissions in the information or records from which these drawings are produced.

NO.	DATE	BY	REVISIONS
1	10/3/94	CLG	CORRECTED PROP. OWNERS

CONTRACT "A"
WATER MAINS
LINE "B"

ELROD WATER COMPANY, INC.
DIVISION "E"
WATERWORKS SYSTEM IMPROVEMENTS

M.D. WESSLER and ASSOCIATES
CONSULTING ENGINEERS
6219 South East Street, Suite A
Indianapolis, Indiana 46227-2148

SCALE: 1" = 100'
DATE: OCT. 14, 1993
PROJECT NO.: 37391.04
DRAWN BY: CLG
APPROVED BY: DGC

NOT PUBLISHED
ALL RIGHTS RESERVED

EXCEPT FOR USES EXPRESSLY PERMITTED IN WRITING, INFORMATION SHOWN OR INCLUDED IN THIS DOCUMENT IS SOLELY THE PROPERTY OF M.D. WESSLER & ASSOCIATES, INC.

DONALD G. COREY
REGISTERED
NO. 13334
STATE OF INDIANA
PROFESSIONAL ENGINEER

Donald G. Corey

PHOTOGRAPHY BY ACCU-AIR SURVEYS, INC., SEYMOUR, INDIANA