


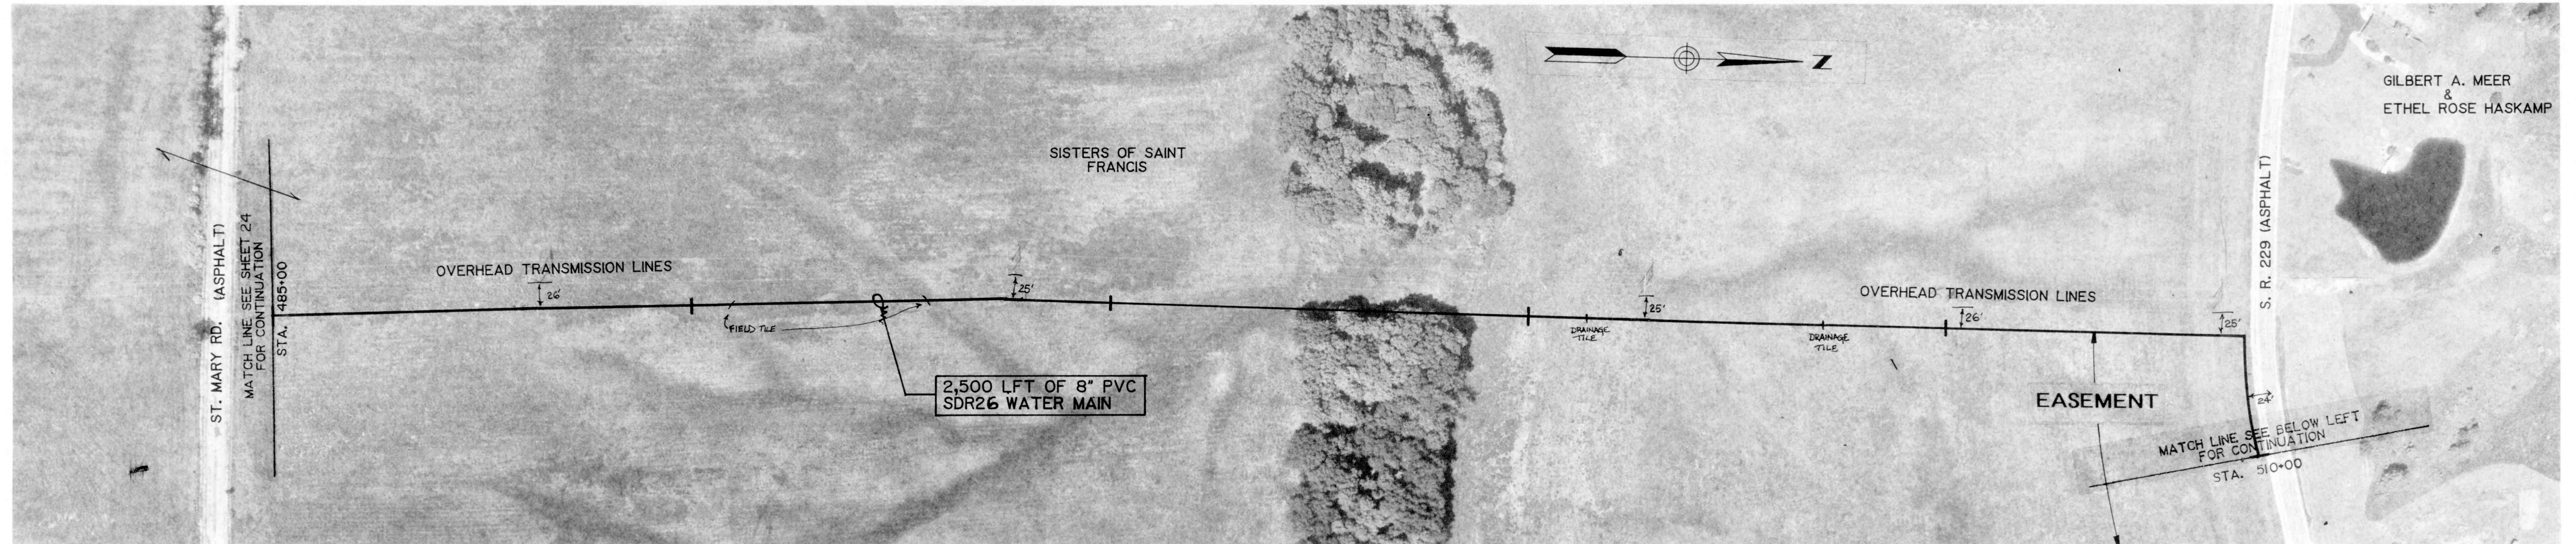

GROUND ELEV. = 960.0±
MAX. STATIC PRESS. = 86.7 PSI±

LINE B EASEMENT


GROUND ELEV. = 965.0±
MAX. STATIC PRESS. = 84.5 PSI±



GROUND ELEV. = 965.0±
MAX. STATIC PRESS. = 84.5 PSI±

LINE B S.R. 229

GROUND ELEV. = 972.0±
MAX. STATIC PRESS. = 81.5 PSI±

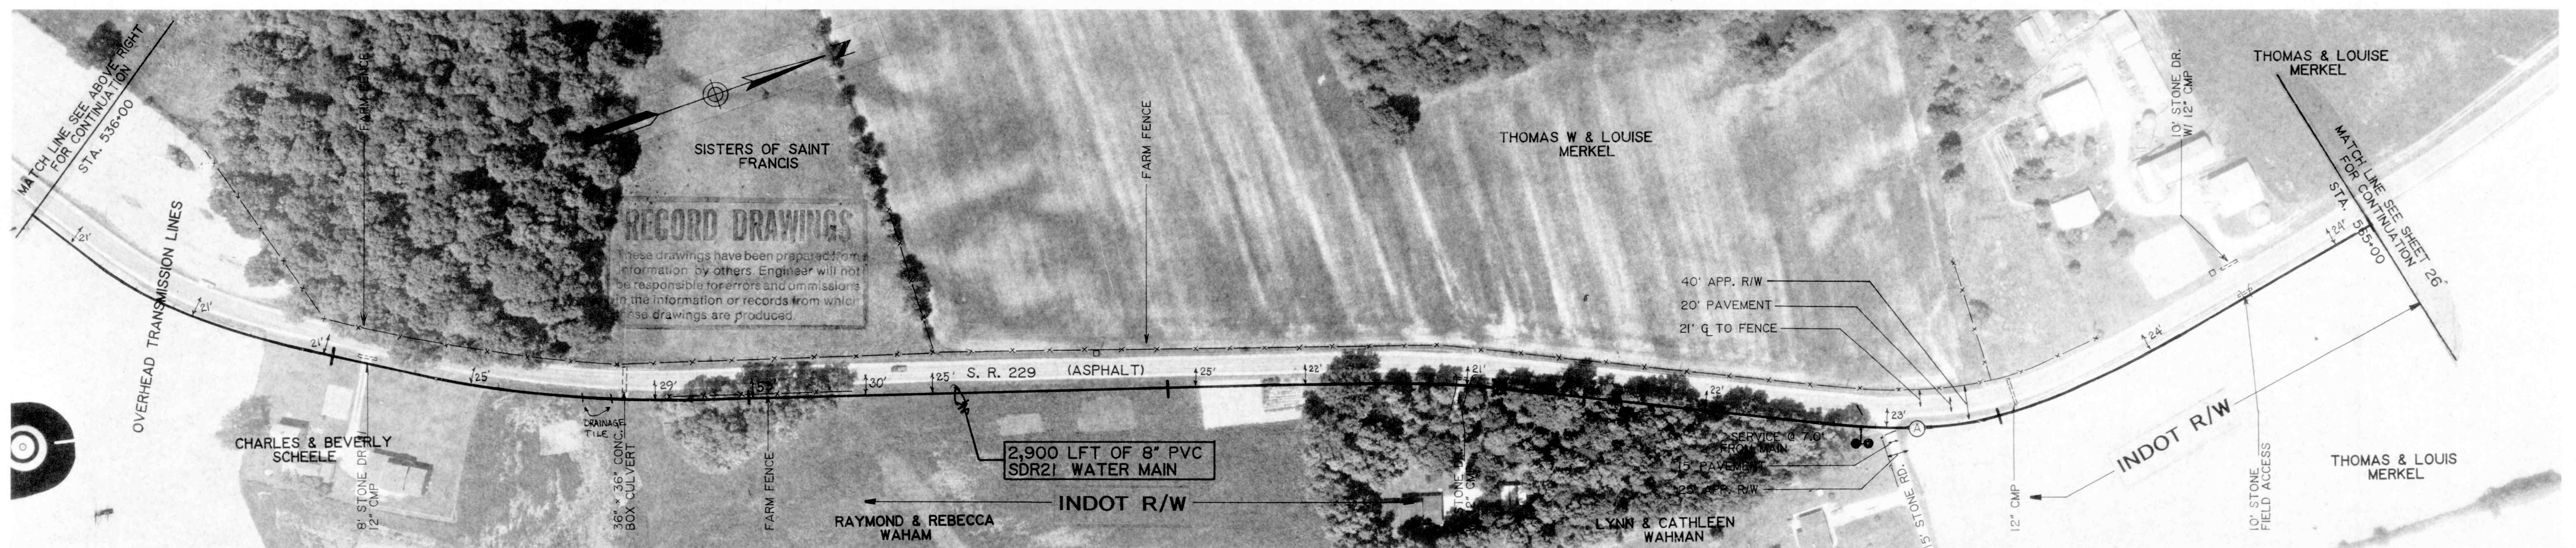

GROUND ELEV. = 972.0±
MAX. STATIC PRESS. = 81.5 PSI±

LINE B S.R. 229

GROUND ELEV. = 973.0±
MAX. STATIC PRESS. = 81.0 PSI±

NO.	DATE	BY	REVISIONS
2	10/3/94	CLG	CORRECTED PROP. OWNERS
1	10/3/94	DAR	ADD EASEMENTS, INDOT PERMIT

CONTRACT "A"
WATER MAINS
LINE "B"
ELROD WATER COMPANY, INC.
DIVISION "E"
WATERWORKS SYSTEM IMPROVEMENTS

M.D. WESSLER and ASSOCIATES
CONSULTING ENGINEERS
8219 South East Street, Suite A
Indianapolis, Indiana 46227-2148

SCALE: 1" = 100'
DATE: OCT. 14, 1993
PROJECT NO.: 37391.04
DRAWN BY: CLG
APPROVED BY: DGC

NOT PUBLISHED
ALL RIGHTS RESERVED
EXCEPT FOR USES EXPRESSLY
PERMITTED IN WRITING, INFOR-
MATION SHOWN OR INCLUDED
IN THIS DOCUMENT IS SOLELY
THE PROPERTY OF M.D.
WESSLER & ASSOCIATES, INC.



SHEET A 25
OF 45