
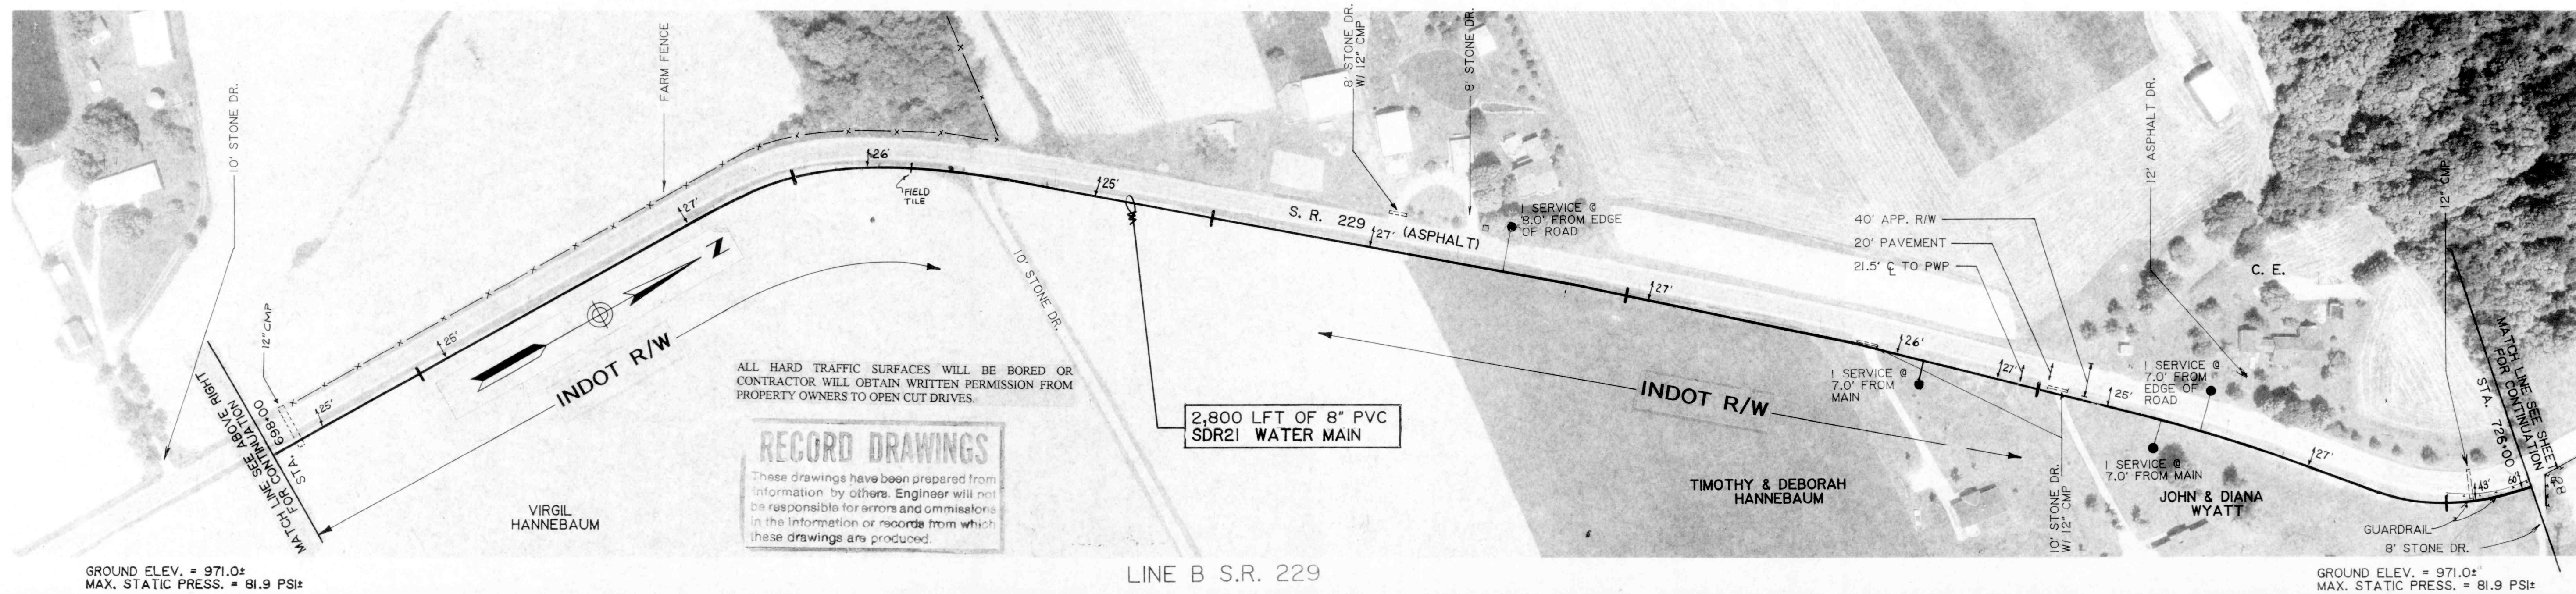
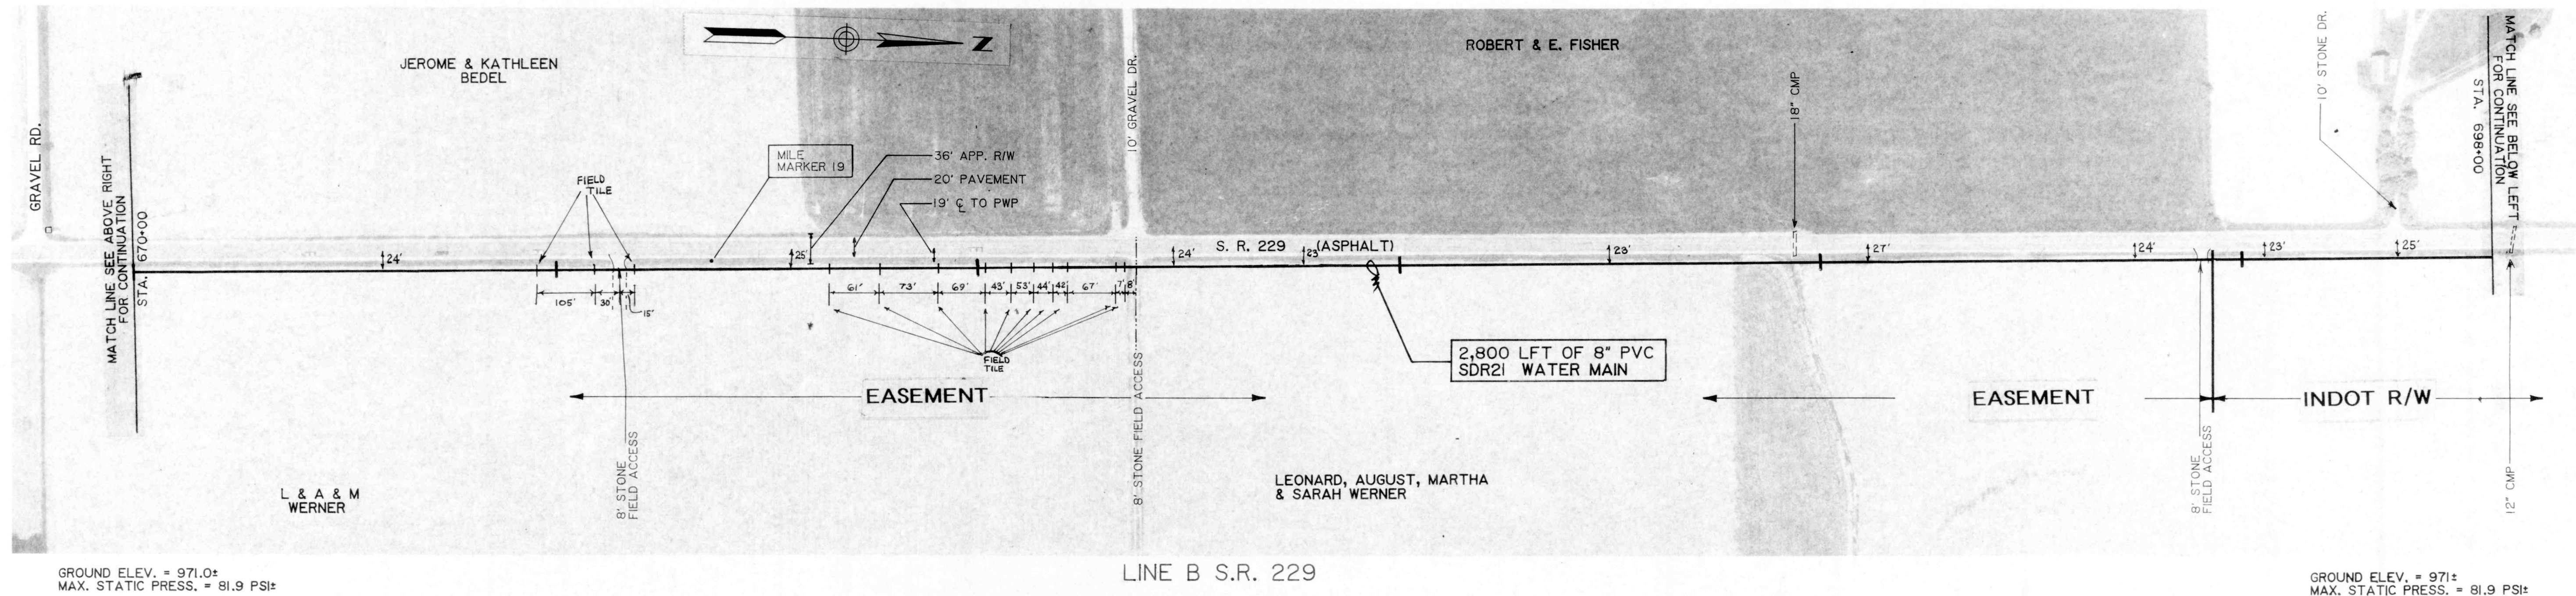


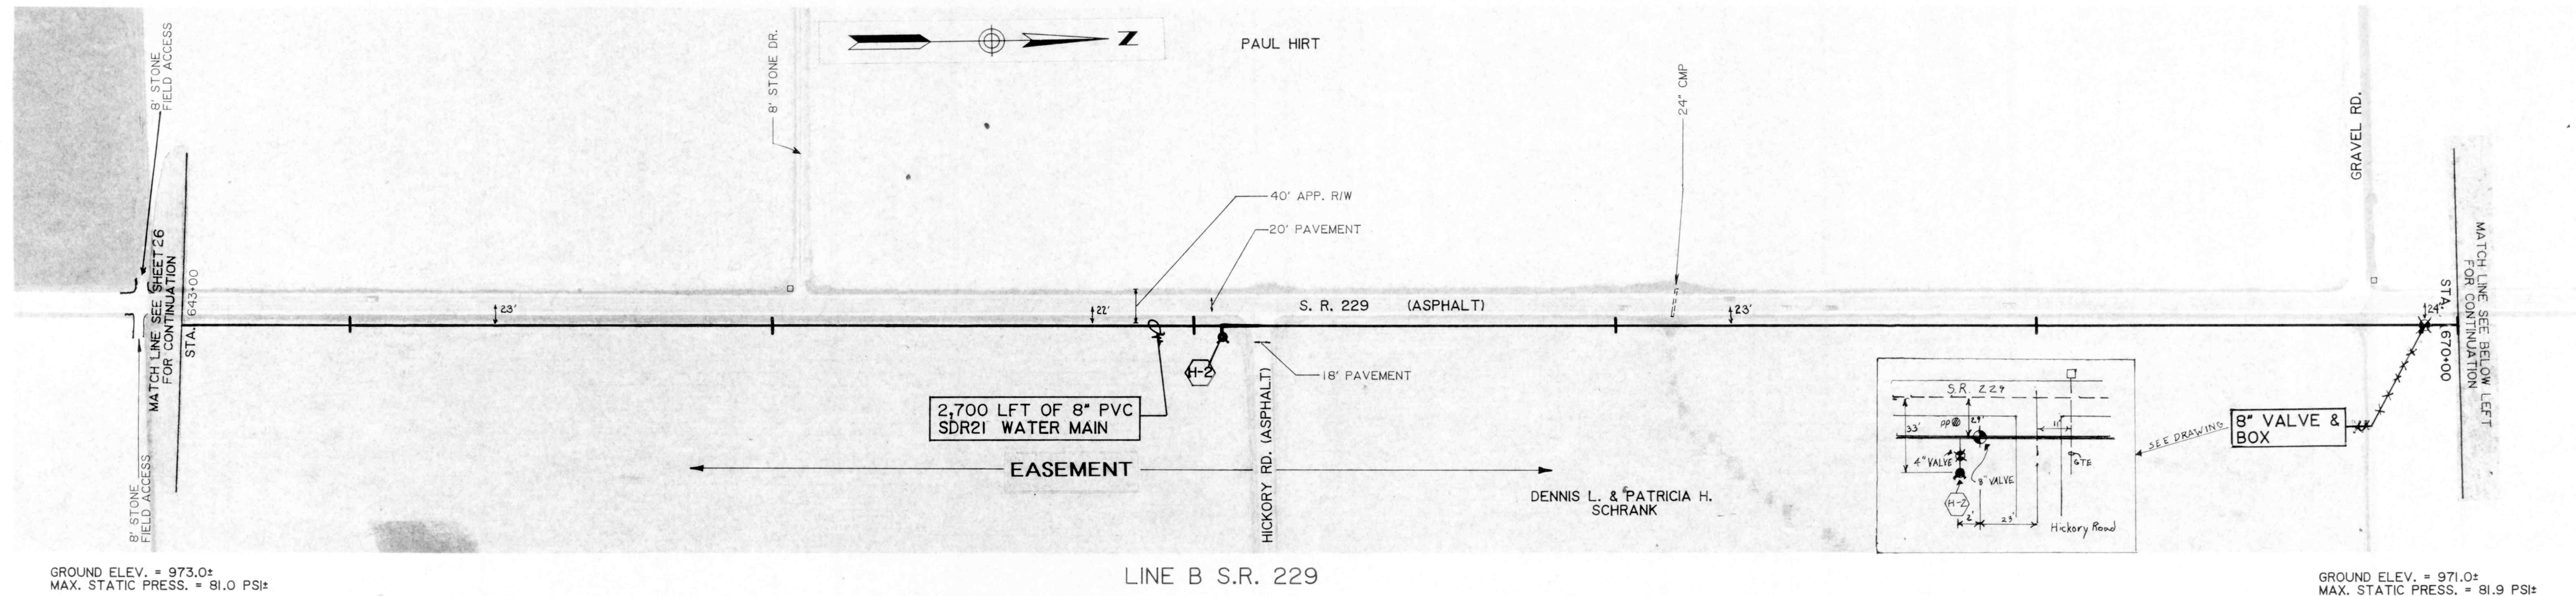

NO.	DATE	BY	REVISIONS
2	10/3/94	CLG	CORRECTED PROP. OWNERS
1	10/3/94	DAR	ADD EASEMENTS, INDOT PERMIT

CONTRACT "A"
WATER MAINS
LINE "B"
ELROD WATER COMPANY, INC.
DIVISION "E"
WATERWORKS SYSTEM IMPROVEMENTS

WESSLER and ASSOCIATES
CONSULTING ENGINEERS
6219 South East Street, Suite A
Indianapolis, Indiana 46227-2148

SCALE: 1" = 100'
DATE: OCT. 14, 1993
PROJECT NO.: 37391.04
DRAWN BY: CLG
APPROVED BY: DCC

NOT PUBLISHED
ALL RIGHTS RESERVED
EXCEPT FOR USES EXPRESSLY
PERMITTED IN WRITING, INFOR-
MATION SHOWN OR INCLUDED
IN THIS DOCUMENT IS SOLELY
THE PROPERTY OF M.D.
WESSLER & ASSOCIATES, INC.

REGISTERED
NO. 13334
STATE OF INDIANA
PROFESSIONAL ENGINEER

SHEET A 27
OF 45