
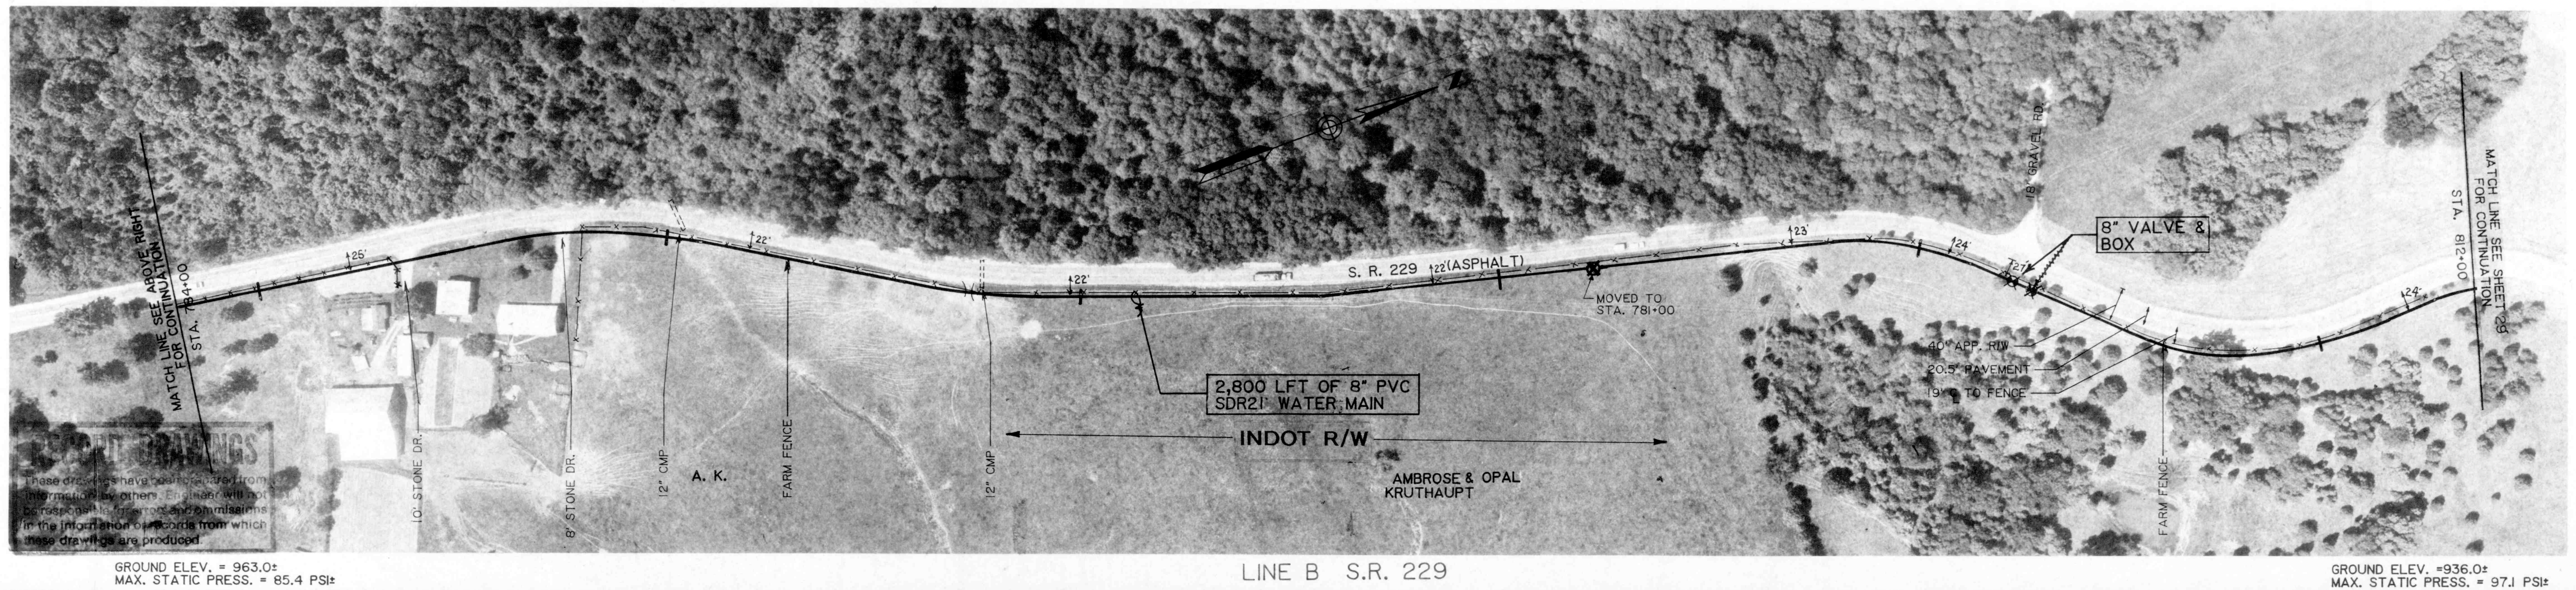
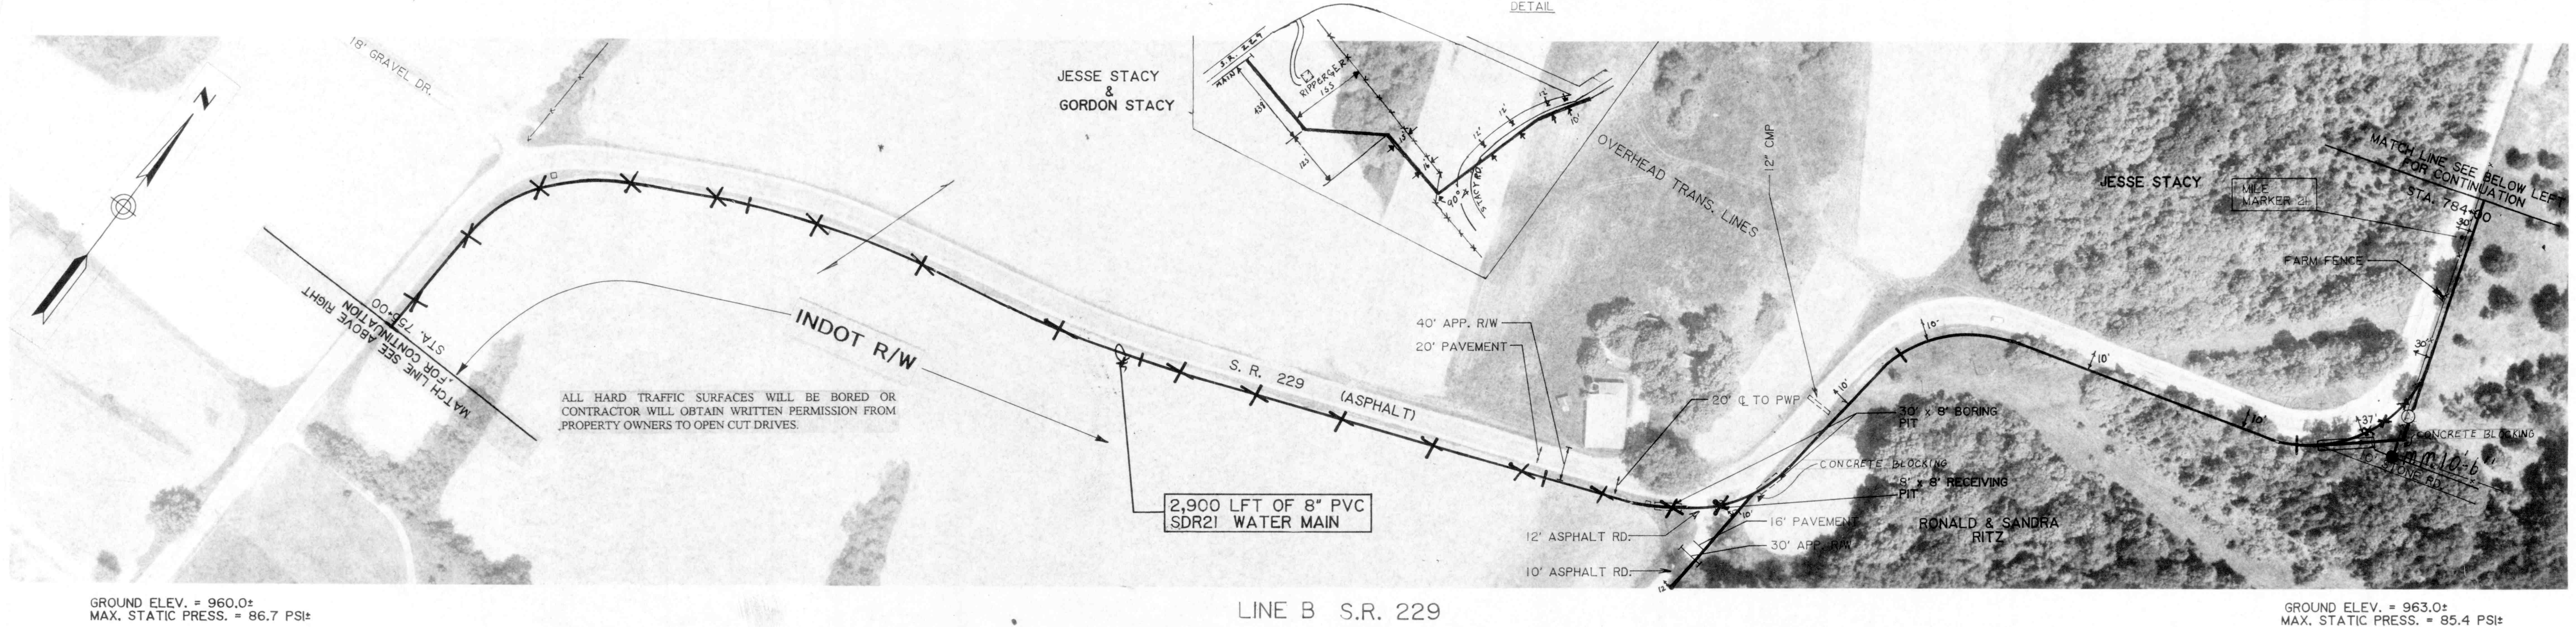


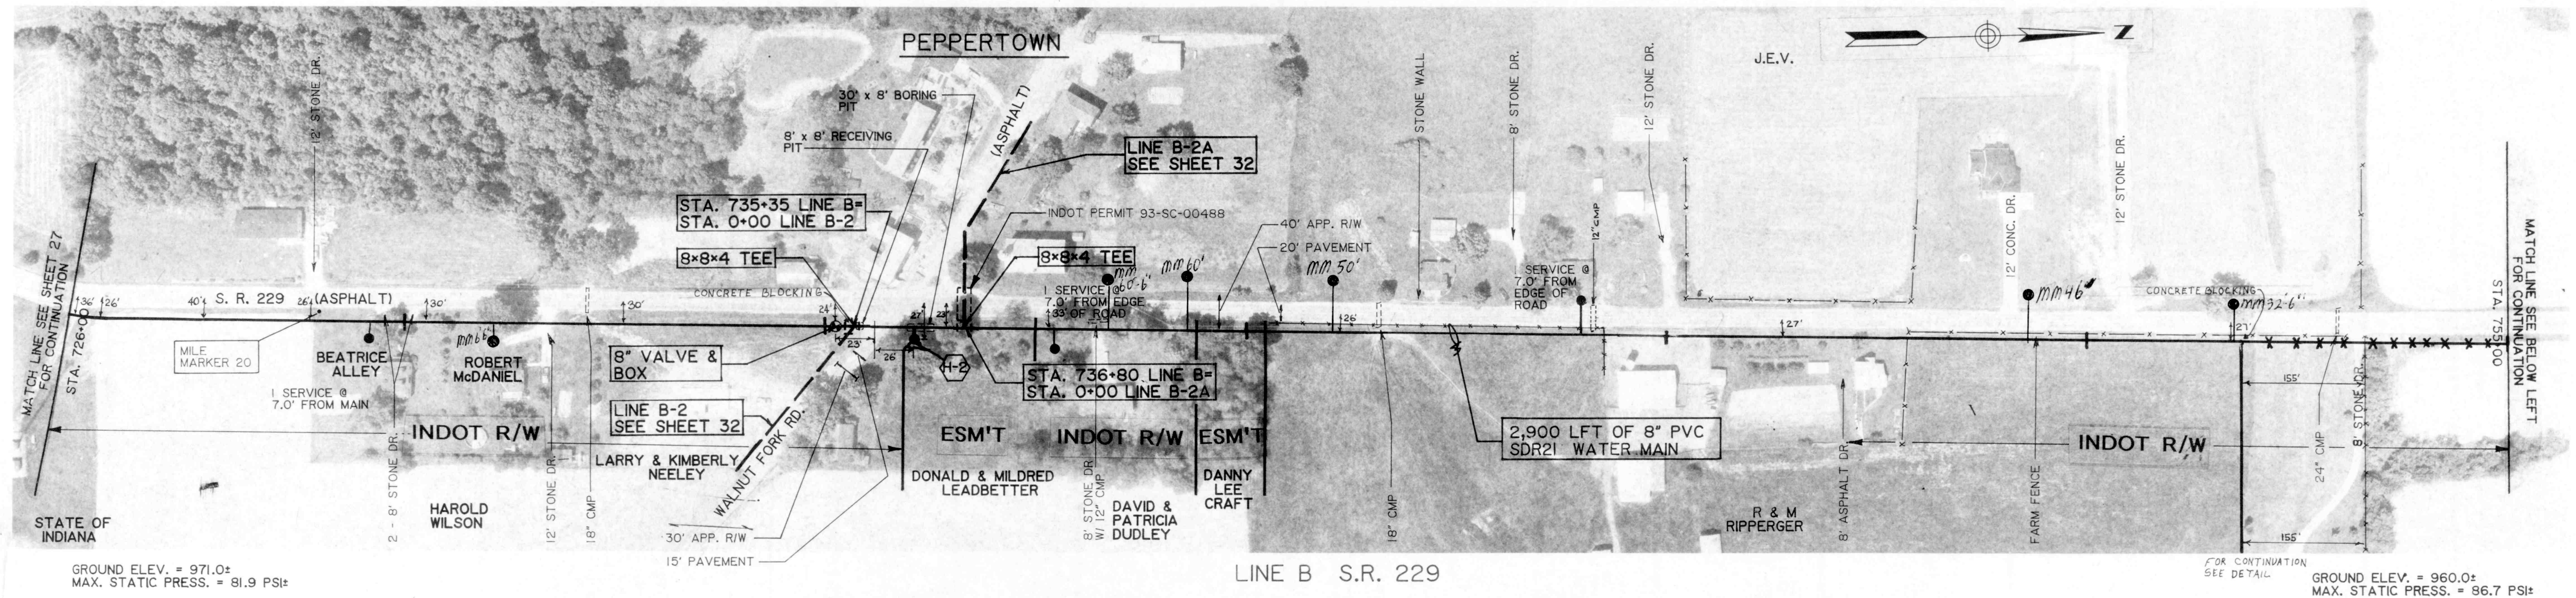

CONTRACT "A" WATER MAINS LINE "B"		ELROD WATER COMPANY, INC. DIVISION "E" WATERWORKS SYSTEM IMPROVEMENTS	
WESSLER and ASSOCIATES CONSULTING ENGINEERS 6219 South East Street, Suite A Indianapolis, Indiana 46227-2148		SCALE: 1" = 100' DATE: OCT. 14, 1993 PROJECT NO.: 37391.04 DRAWN BY: CLG APPROVED BY: DGC	
NOT PUBLISHED ALL RIGHTS RESERVED EXCEPT FOR USES EXPRESSLY PERMITTED IN WRITING, INFOR- MATION SHOWN OR INCLUDED IN THIS DOCUMENT IS SOLELY THE PROPERTY OF M.D. WESSLER & ASSOCIATES, INC.		CORRECTED PROP. OWNERS 10/3/94 CLG ADD EASEMENTS, INDOT PERMIT 10/3/94 DAR NO. DATE BY REVISIONS	
SHEET A 28 OF 45		PHOTOGRAPHY BY: ACCU-AIR SURVEYS, INC., SEYMOUR, INDIANA	