



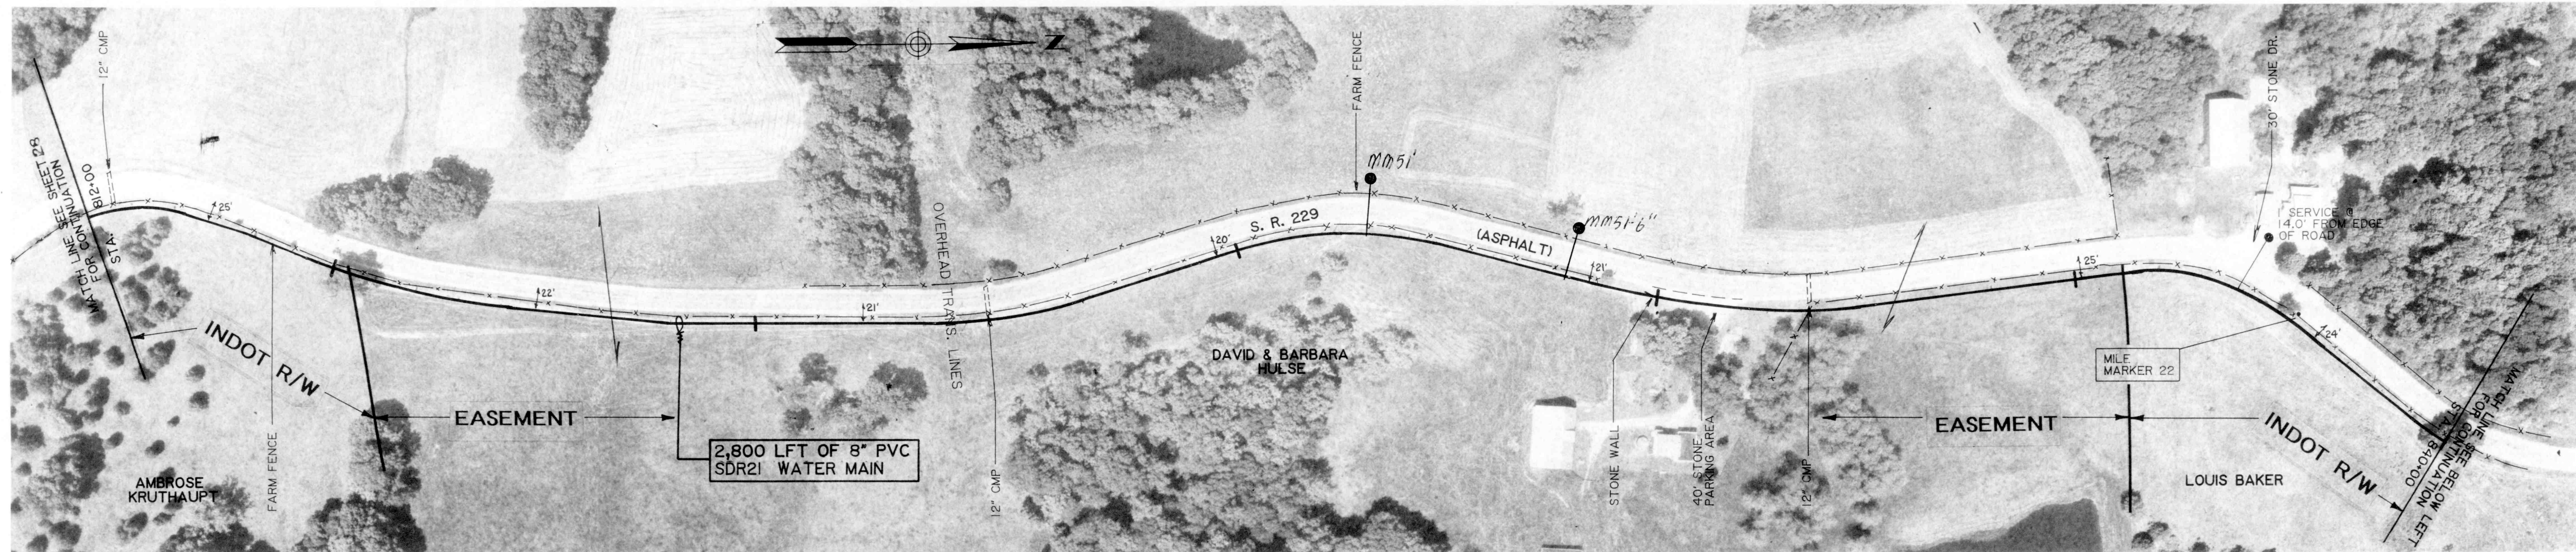

GROUND ELEV. = 936.0±
MAX. STATIC PRESS. = 97.1 PSI±

LINE B S.R. 229


GROUND ELEV. = 952.0±
MAX. STATIC PRESS. = 90.1 PSI±

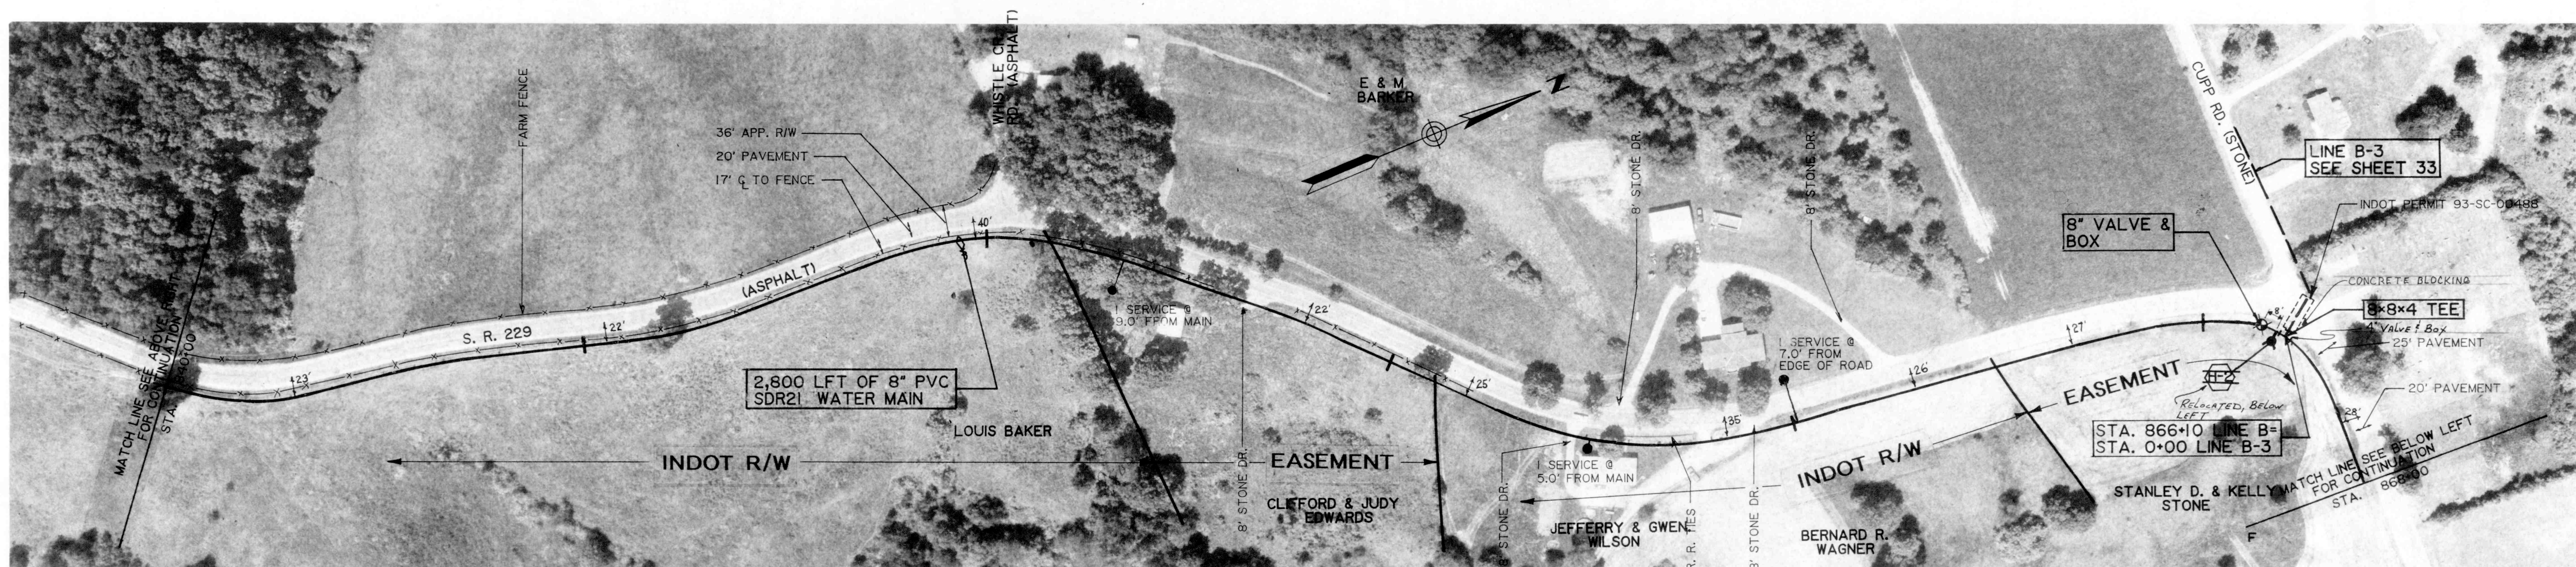

GROUND ELEV. = 952.0±
MAX. STATIC PRESS. = 90.1 PSI±

LINE B S.R. 229

GROUND ELEV. = 964.0±
MAX. STATIC PRESS. = 84.9 PSI±

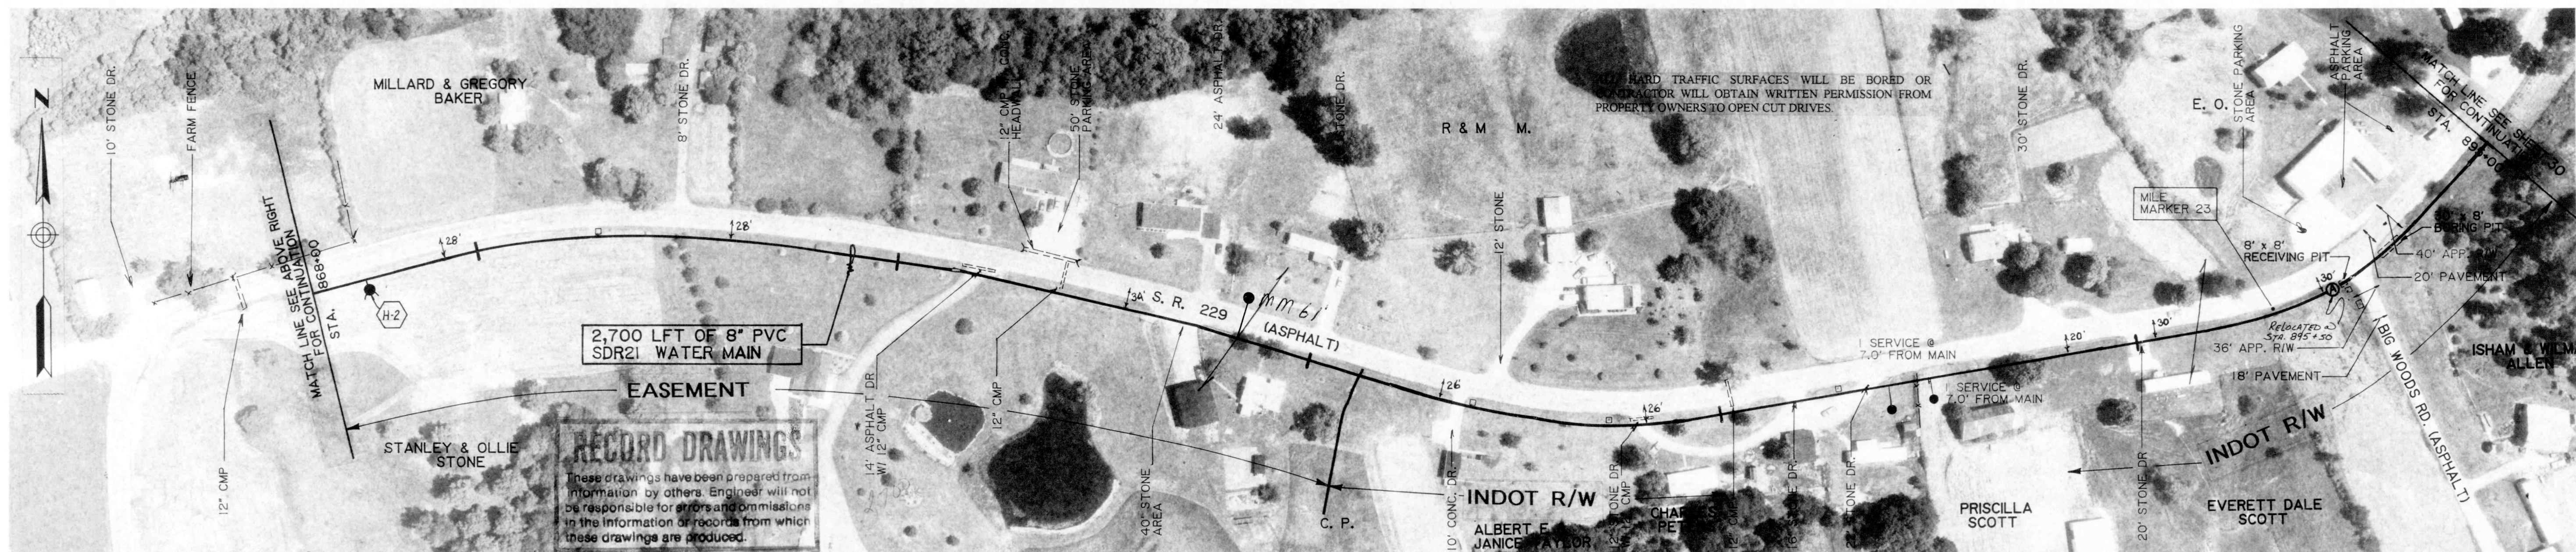

GROUND ELEV. = 964.0±
MAX. STATIC PRESS. = 84.9 PSI±

LINE B S.R. 229

GROUND ELEV. = 965.0±
MAX. STATIC PRESS. = 84.5 PSI±

CONTRACT "A"
WATER MAINS
LINE "B"

ELROD WATER COMPANY, INC.
DIVISION "E"
WATERWORKS SYSTEM IMPROVEMENTS

WESSLER and
ASSOCIATES
CONSULTING ENGINEERS

6219 South East Street, Suite A
Indianapolis, Indiana 46227-2148

SCALE: 1" = 100'
DATE: OCT. 14, 1993
PROJECT NO.: 37391.04
DRAWN BY: CLG
APPROVED BY: DGC

NOT PUBLISHED
ALL RIGHTS RESERVED
EXCEPT FOR USES EXPRESSLY
PERMITTED IN WRITING, INFOR-
MATION SHOWN OR INCLUDED
IN THIS DOCUMENT IS SOLELY
THE PROPERTY OF M.D.
WESSLER & ASSOCIATES, INC.

PROFESSIONAL ENGINEER
STATE OF INDIANA
NO. 13334

Paul L. Wessler

SHEET A 29

OF 45

PHOTOGRAPHY BY AERIAL SURVEYS, INC., SEYMOUR, INDIANA