



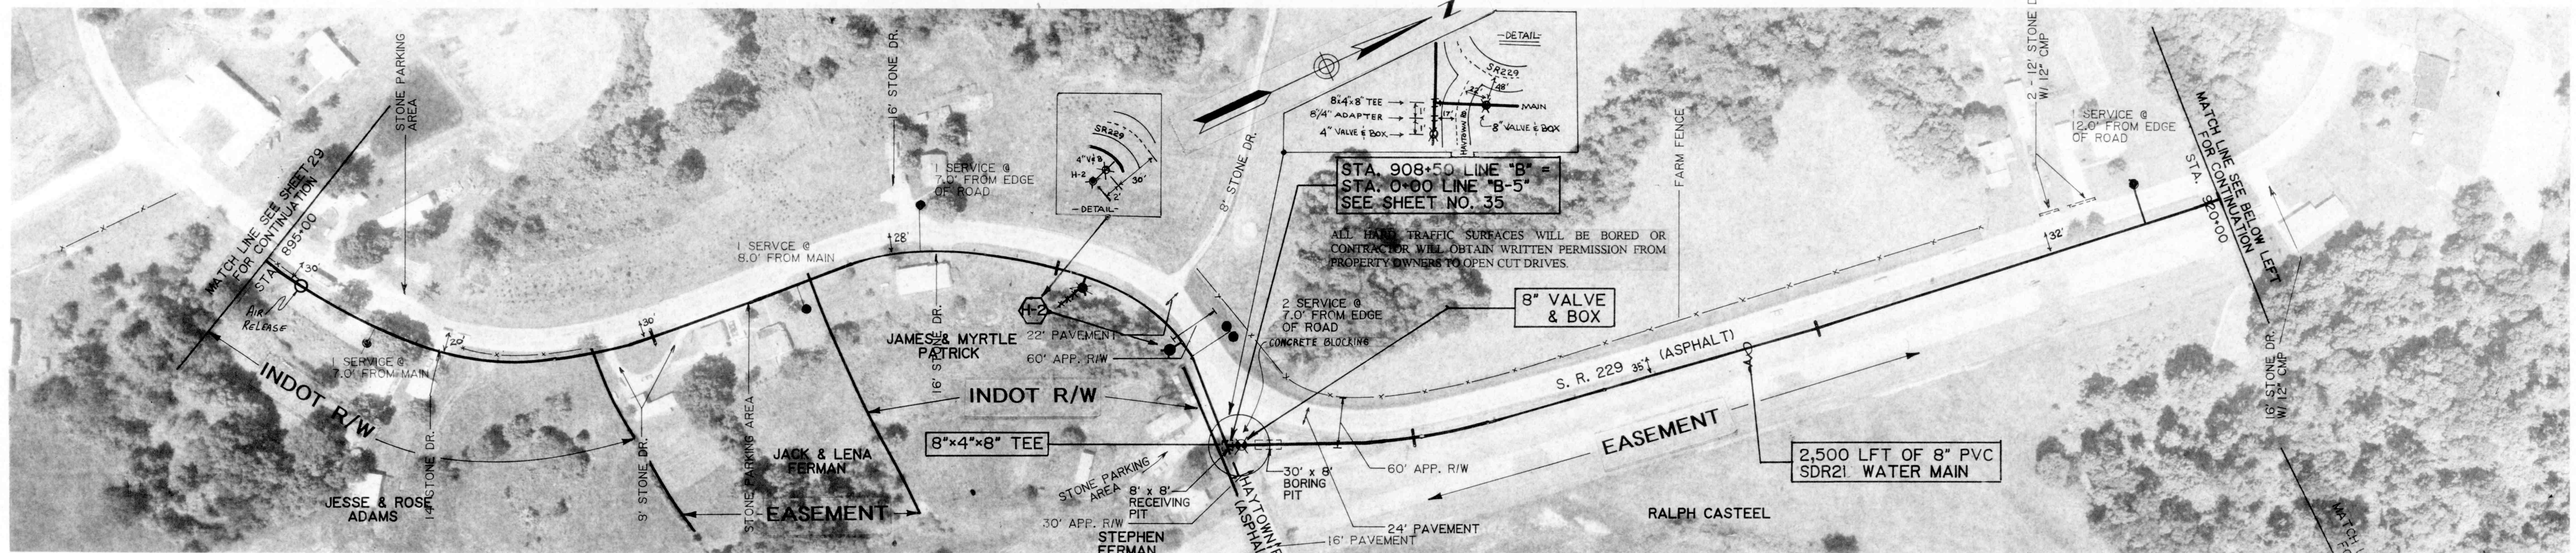

GROUND ELEV. = 965.0'
MAX. STATIC PRESS. = 84.5 PSI



GROUND ELEV. = 952.0'
MAX. STATIC PRESS. = 90.0 PSI

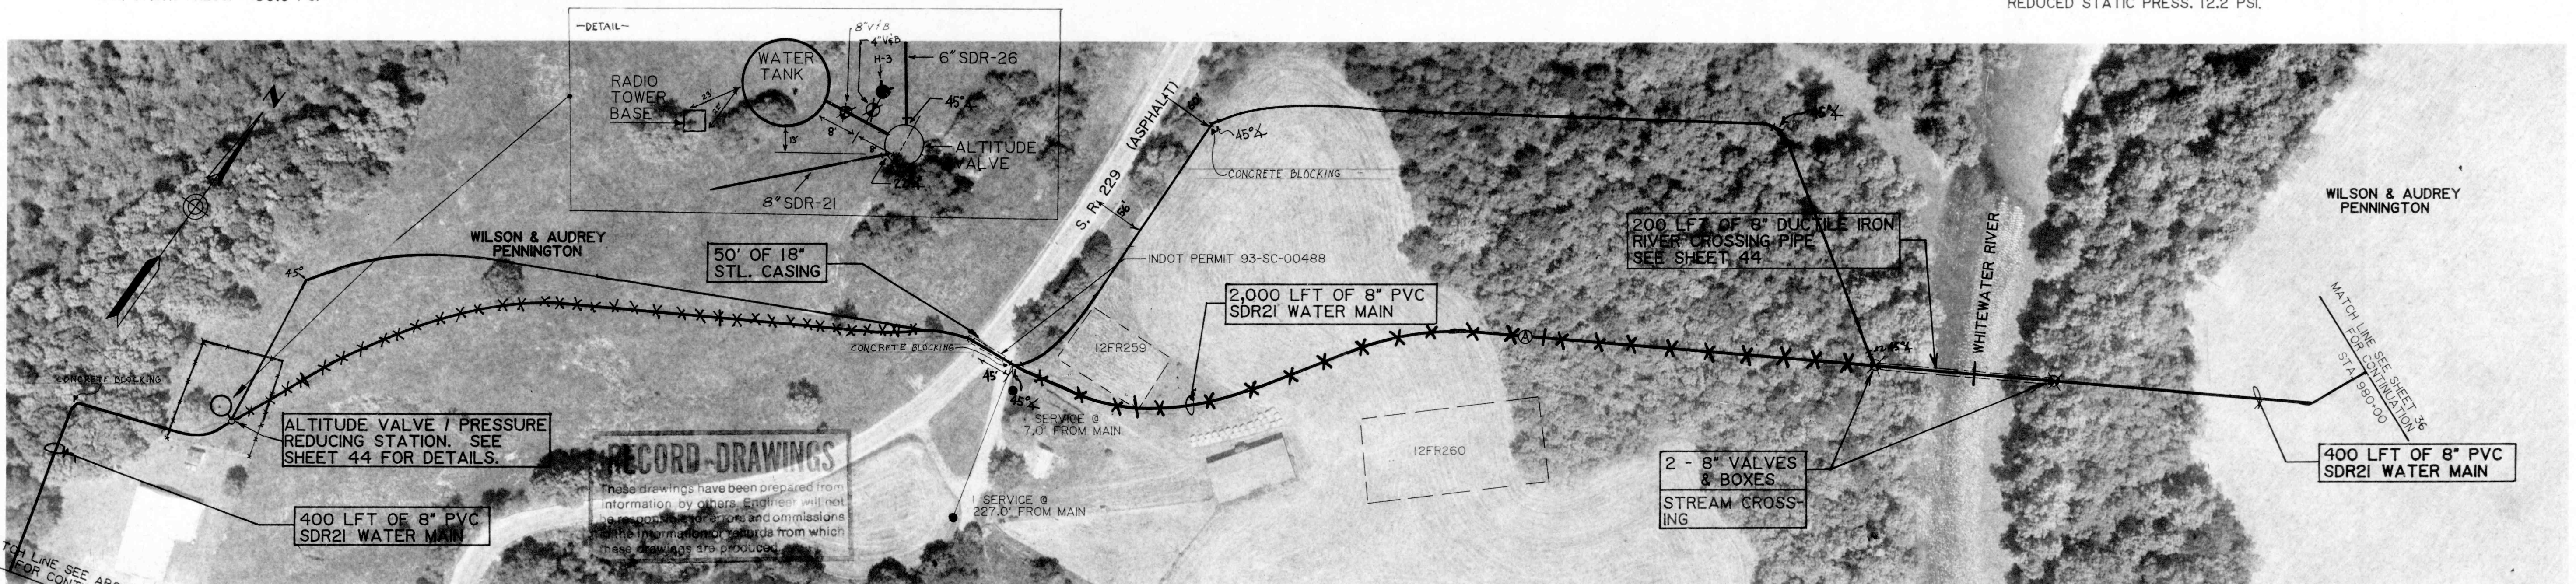

GROUND ELEV. = 865.0'
REDUCED PRESS. 12.2 PSI

GROUND ELEV. = 750.0'
REDUCED PRESS. 61.9 PSI

GROUND ELEV. = 670'
REDUCED PRESS. 96.5 PSI

CONTRACT "A"
WATER MAINS
LINE "B"
ELROD WATER COMPANY, INC.
DIVISION "E"
WATERWORKS SYSTEM IMPROVEMENTS

M.D. WESSLER and ASSOCIATES
CONSULTING ENGINEERS
6219 South East Street, Suite A
Indianapolis, Indiana 46227-2148

SCALE: 1" = 100'
DATE: OCT. 14, 1993
PROJECT NO.: 37391.04
DRAWN BY: CLG
APPROVED BY: DGC

NOT PUBLISHED
ALL RIGHTS RESERVED
EXCEPT FOR USES EXPRESSLY
PERMITTED IN WRITING, INFOR-
MATION SHOWN OR INCLUDED
IN THIS DOCUMENT IS SOLELY
THE PROPERTY OF M.D.
WESSLER & ASSOCIATES, INC.

PROFESSIONAL ENGINEER
NO. 13334
STATE OF INDIANA

SHEET A 30
OF 45