
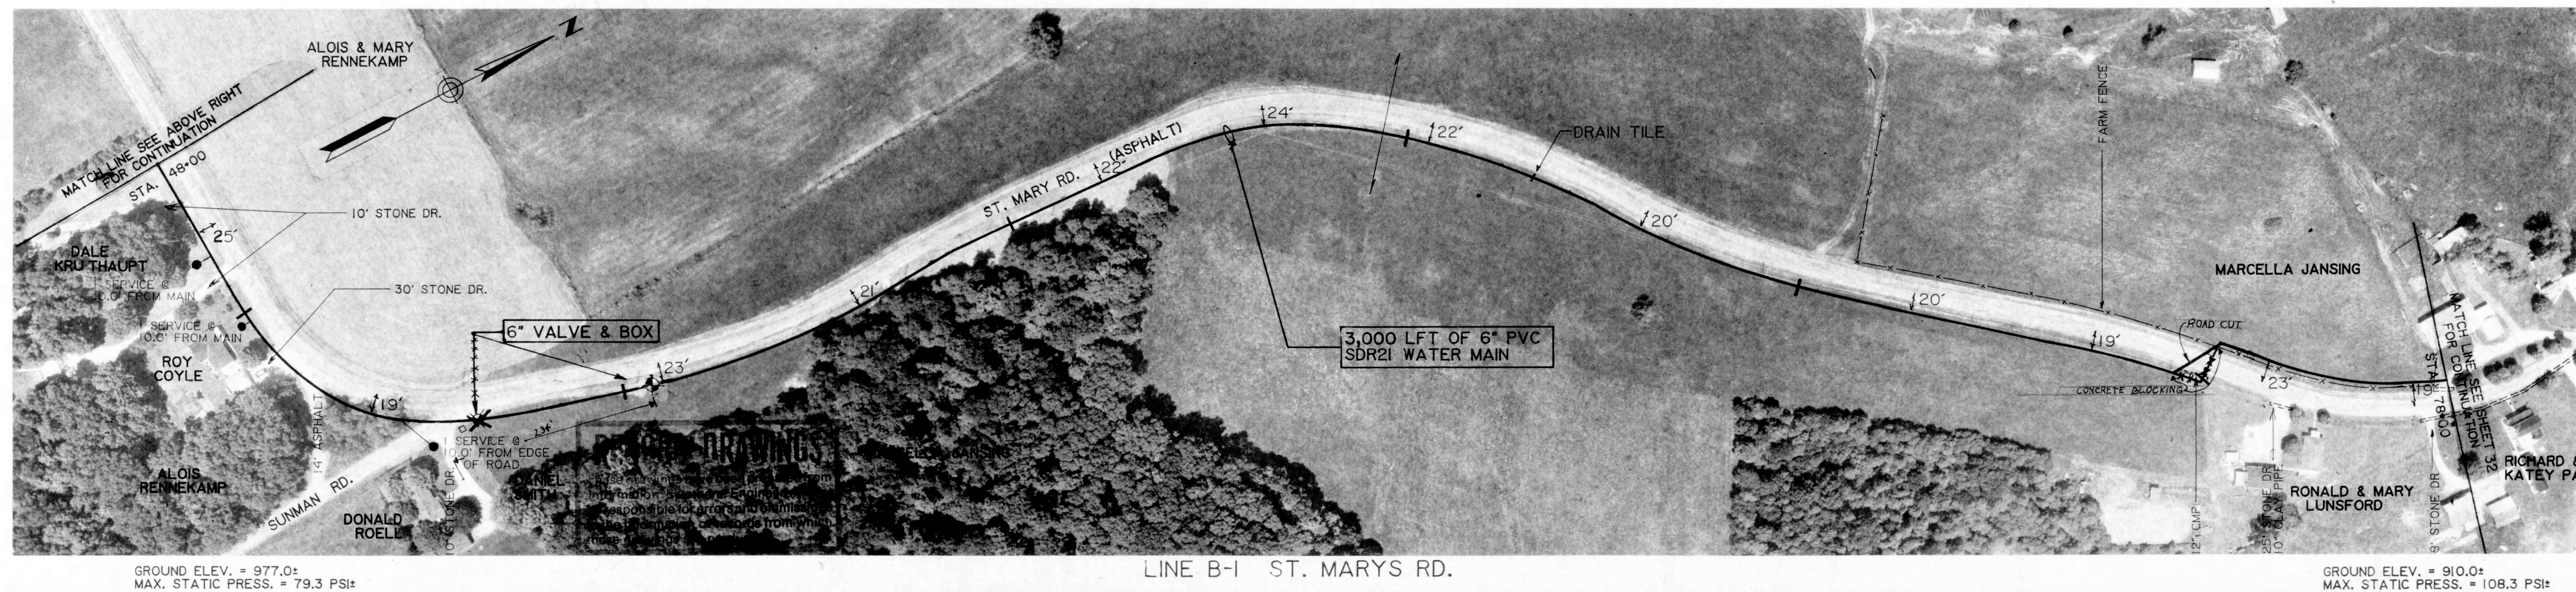
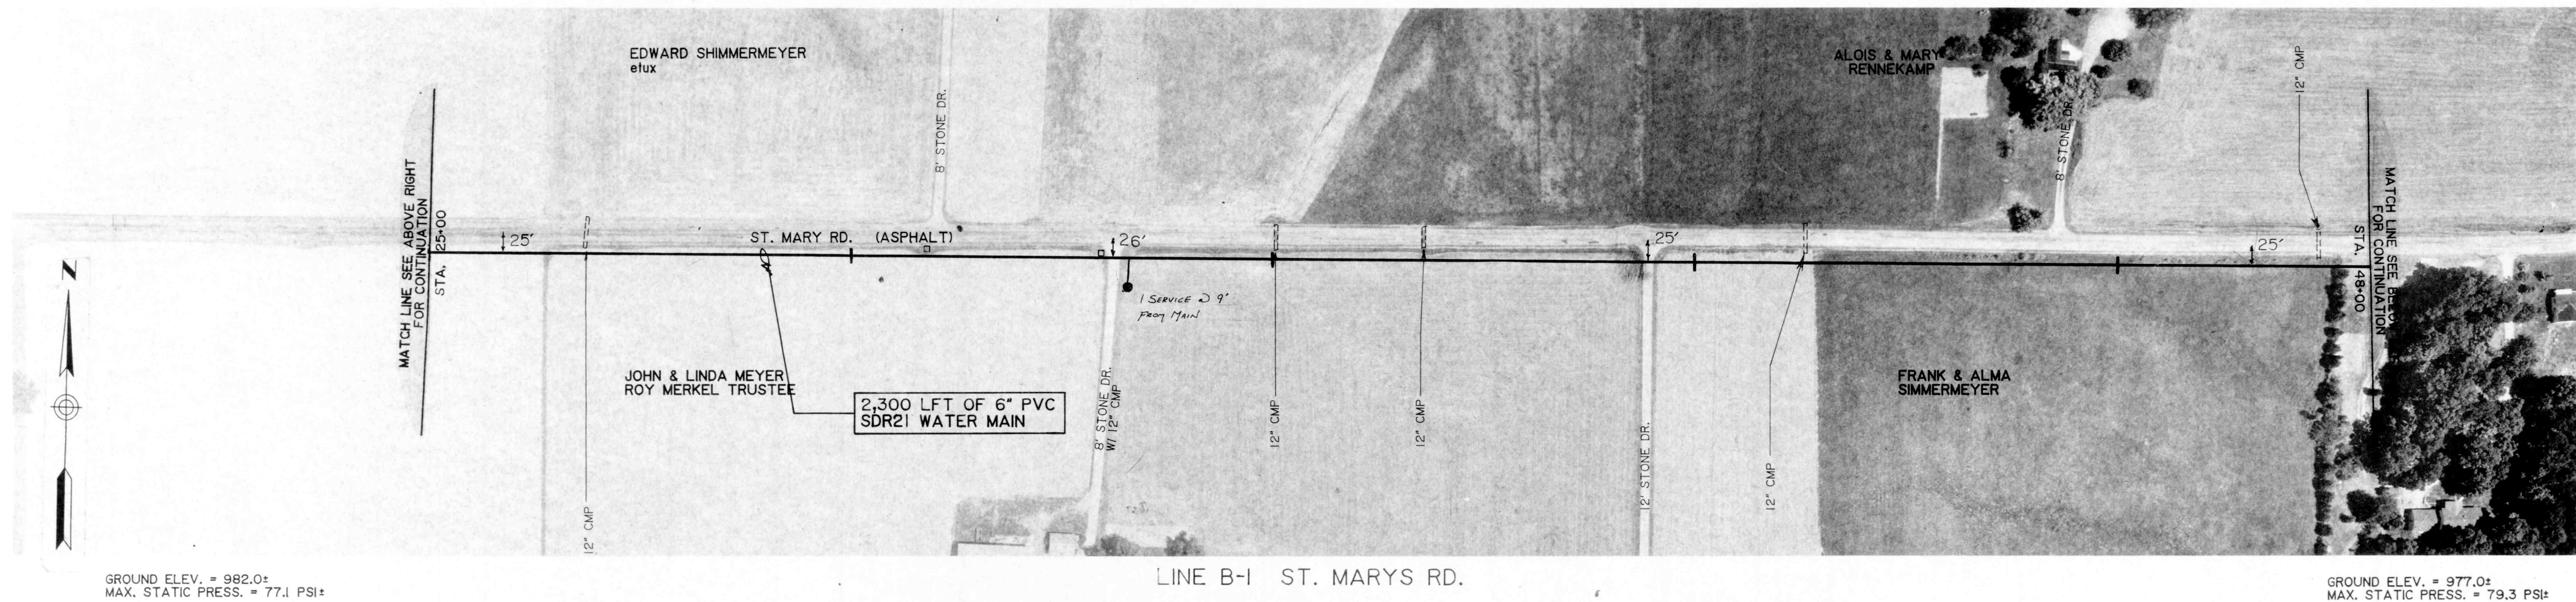


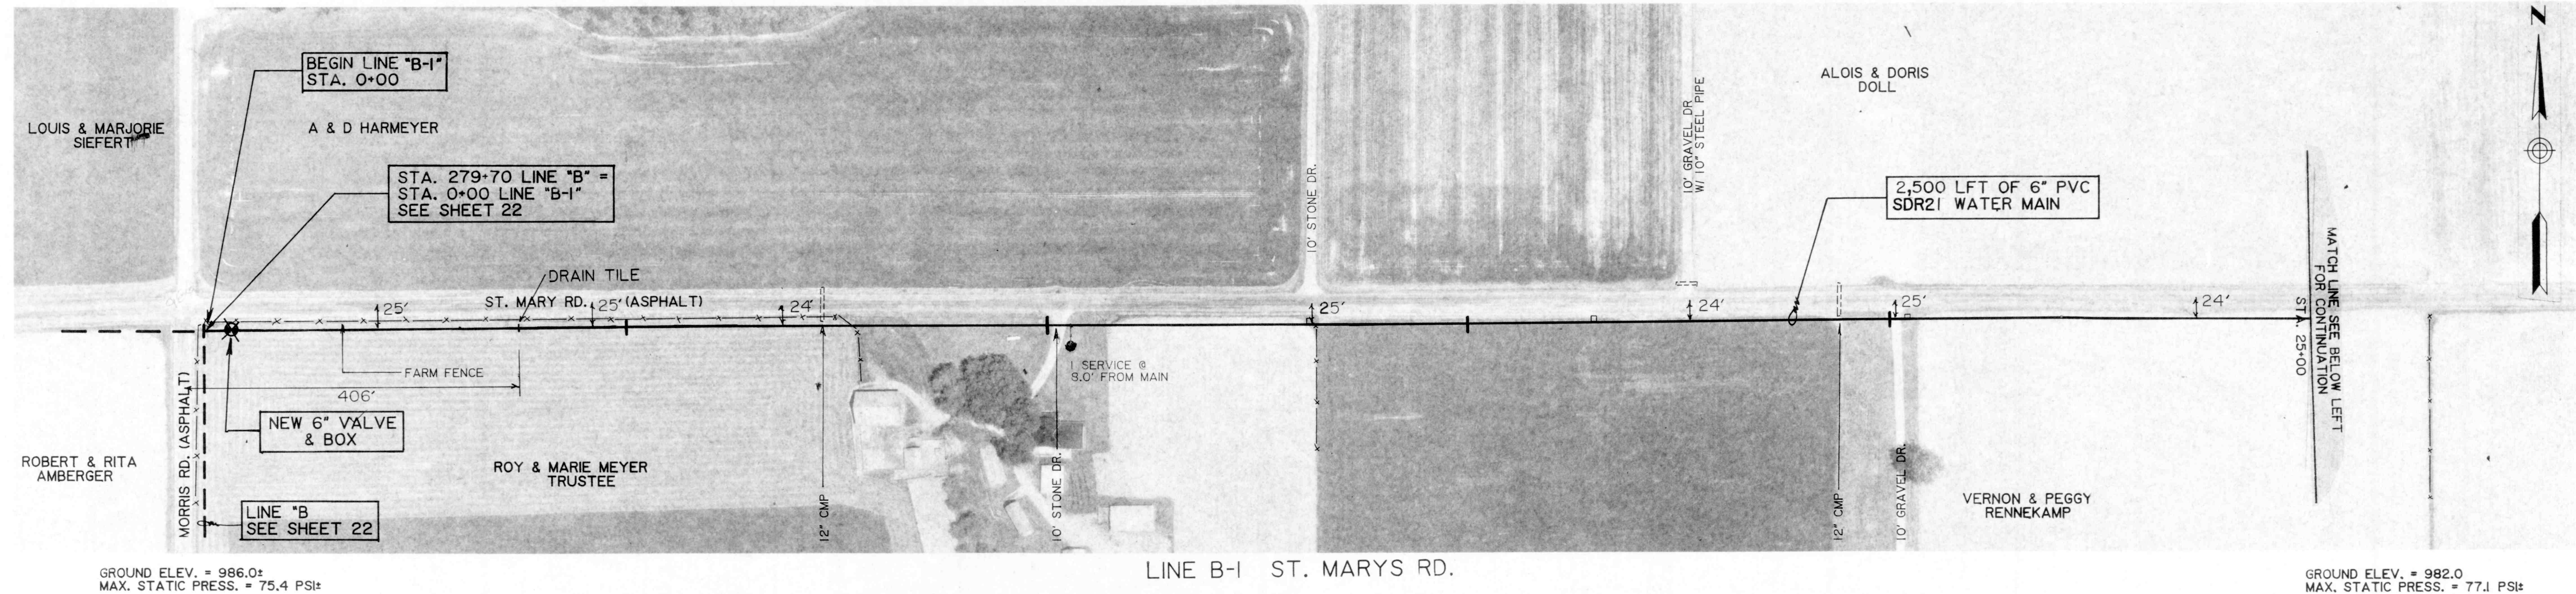

CONTRACT "A"
WATER MAINS
LINE "B-1"
DIVISION "E"
WATERWORKS SYSTEM IMPROVEMENTS

M.D. WESSLER and ASSOCIATES
CONSULTING ENGINEERS
6219 South East Street, Suite A
Indianapolis, Indiana 46227-2148

ELROD WATER COMPANY, INC.

SCALE: 1" = 100'

DATE: OCT. 14, 1993

PROJECT NO.: 37391.04

DRAWN BY: CLG

APPROVED BY: DCC

NOT PUBLISHED
ALL RIGHTS RESERVED

EXCEPT FOR USES EXPRESSLY
PERMITTED IN WRITING, INFOR-
MATION SHOWN OR INCLUDED
IN THIS DOCUMENT IS SOLELY
THE PROPERTY OF M.D.
WESSLER & ASSOCIATES, INC.

PROFESSIONAL ENGINEER
NO. 13334
STATE OF INDIANA

SHEET A 31
OF 45