


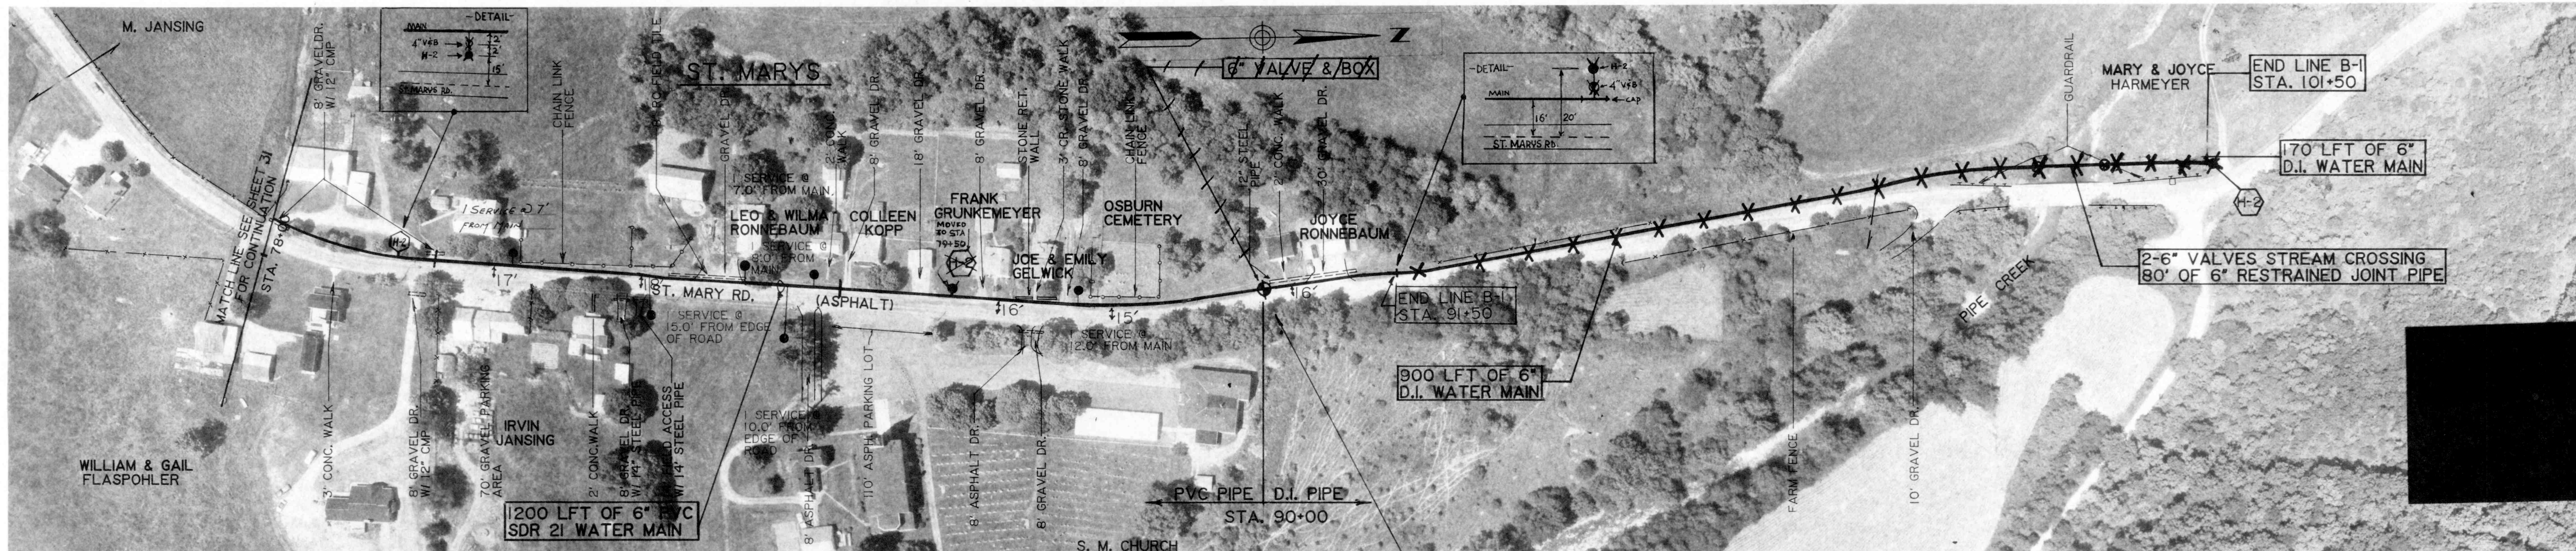

GROUND ELEV. = 910.0±
MAX. STATIC PRESS. = 108.3 PSI±

LINE B-1 ST. MARYS RD.

GROUND ELEV. = 855.0±
MAX. STATIC PRESS. = 132.0 PSI±


GROUND ELEV. = 755.0±
MAX. STATIC PRESS. = 175.4 PSI±



GROUND ELEV. = 969.0±
MAX. STATIC PRESS. = 82.8 PSI±

LINE B-2A BEACON RD

GROUND ELEV. = 964.0±
MAX. STATIC PRESS. = 84.9 PSI±

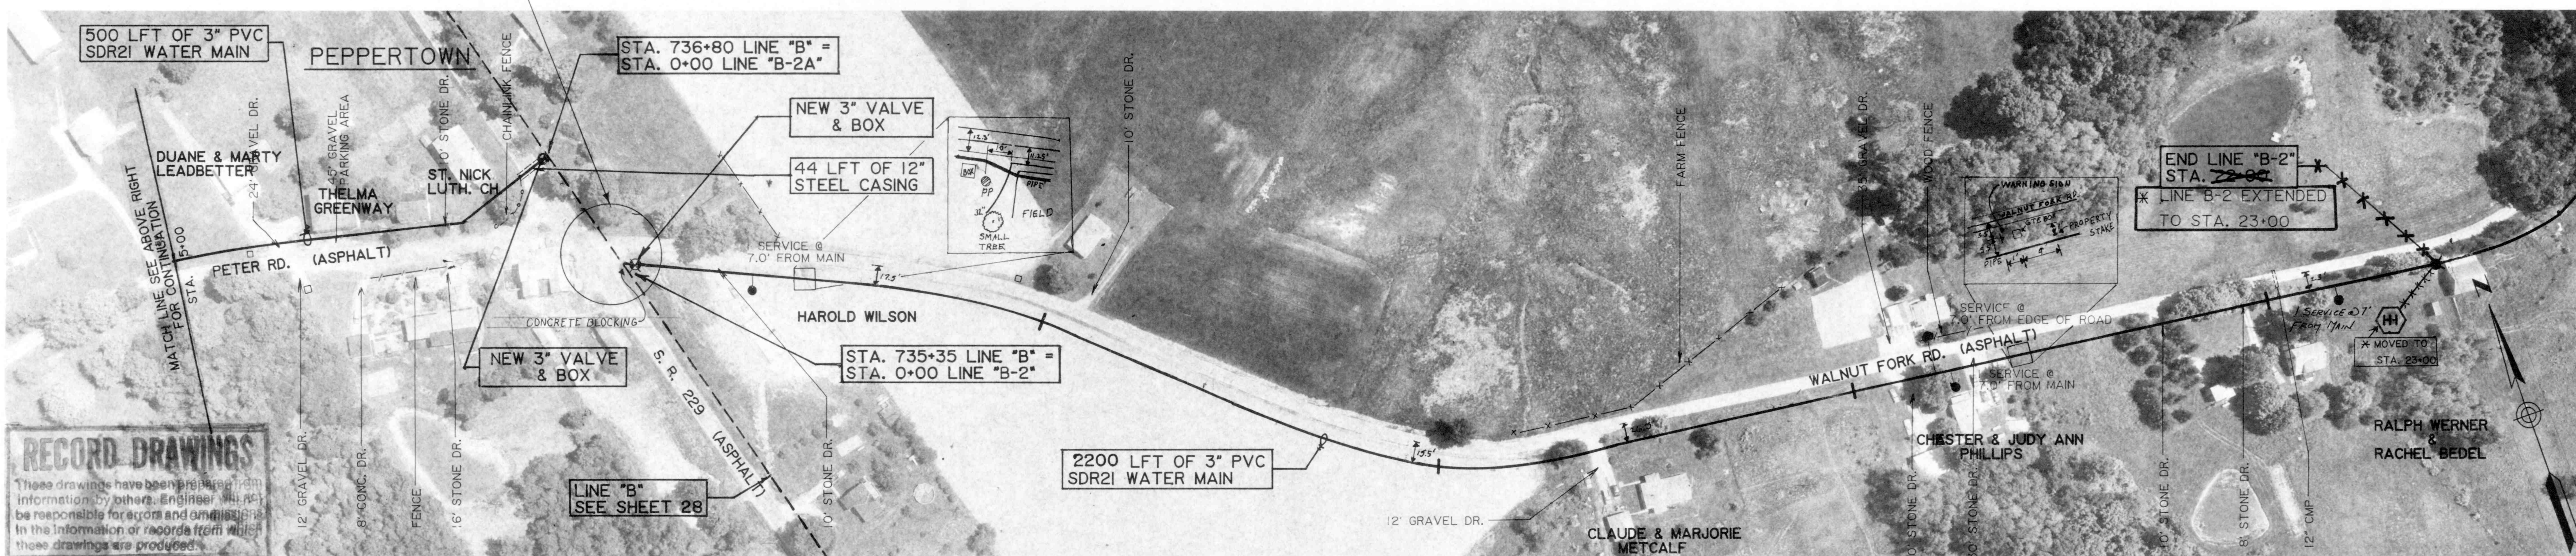

GROUND ELEV. = 964.0±
MAX. STATIC PRESS. = 84.9 PSI±

LINE B-2 & B-2A

GROUND ELEV. = 971.0±
MAX. STATIC PRESS. 81.9 PSI±

CONTRACT "A"
WATER MAINS
LINES B-1, B-2, & B-2A
ELROD WATER COMPANY, INC.
DIVISION "E"
WATERWORKS SYSTEM IMPROVEMENTS

M.D. WESSLER and ASSOCIATES
CONSULTING ENGINEERS
8219 South East Street, Suite A
Indianapolis, Indiana 46227-2148

SCALE: 1" = 100'
DATE: OCT. 14, 1993
PROJECT NO.: 37391.04
DRAWN BY: CLG
APPROVED BY: DCC

NOT PUBLISHED
ALL RIGHTS RESERVED
EXCEPT FOR USES EXPRESSLY
PERMITTED IN WRITING, INFOR-
MATION SHOWN OR INCLUDED
IN THIS DOCUMENT IS SOLELY
THE PROPERTY OF M.D.
WESSLER & ASSOCIATES, INC.

INDIANAPOLIS
13334
STATE OF INDIANA
PROFESSIONAL ENGINEER

Donald B. Wessler
SHEET A 32
OF 45

PHOTOGRAPHY BY ACCU-AIR SURVEYS, INC., SEYMOUR, INDIANA