
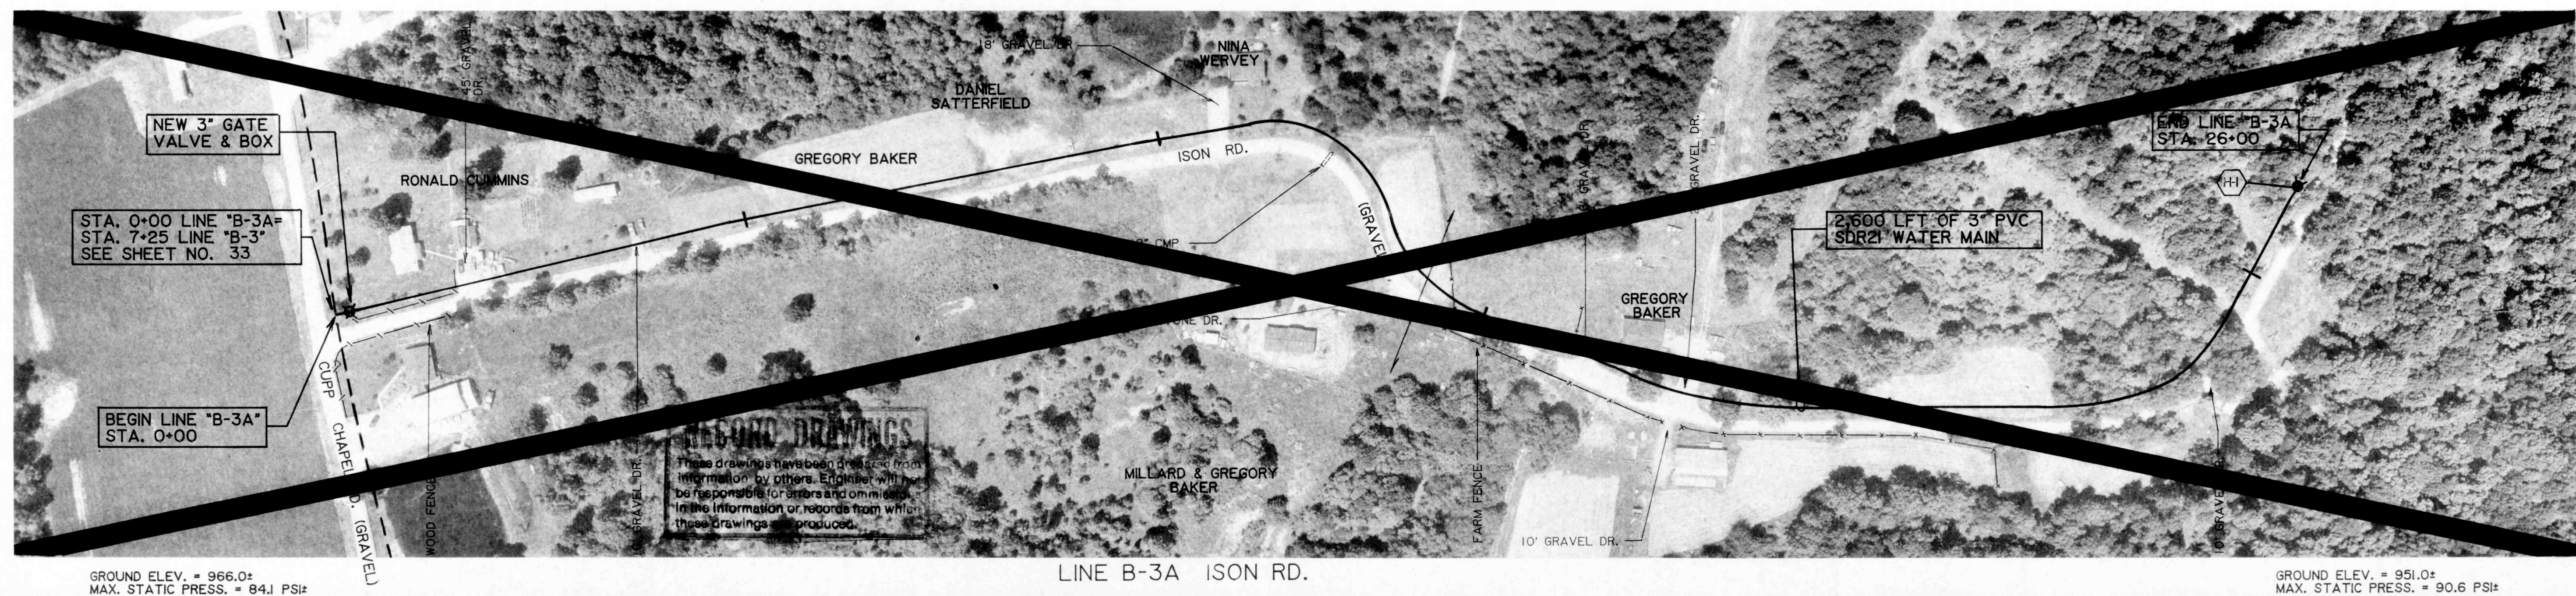
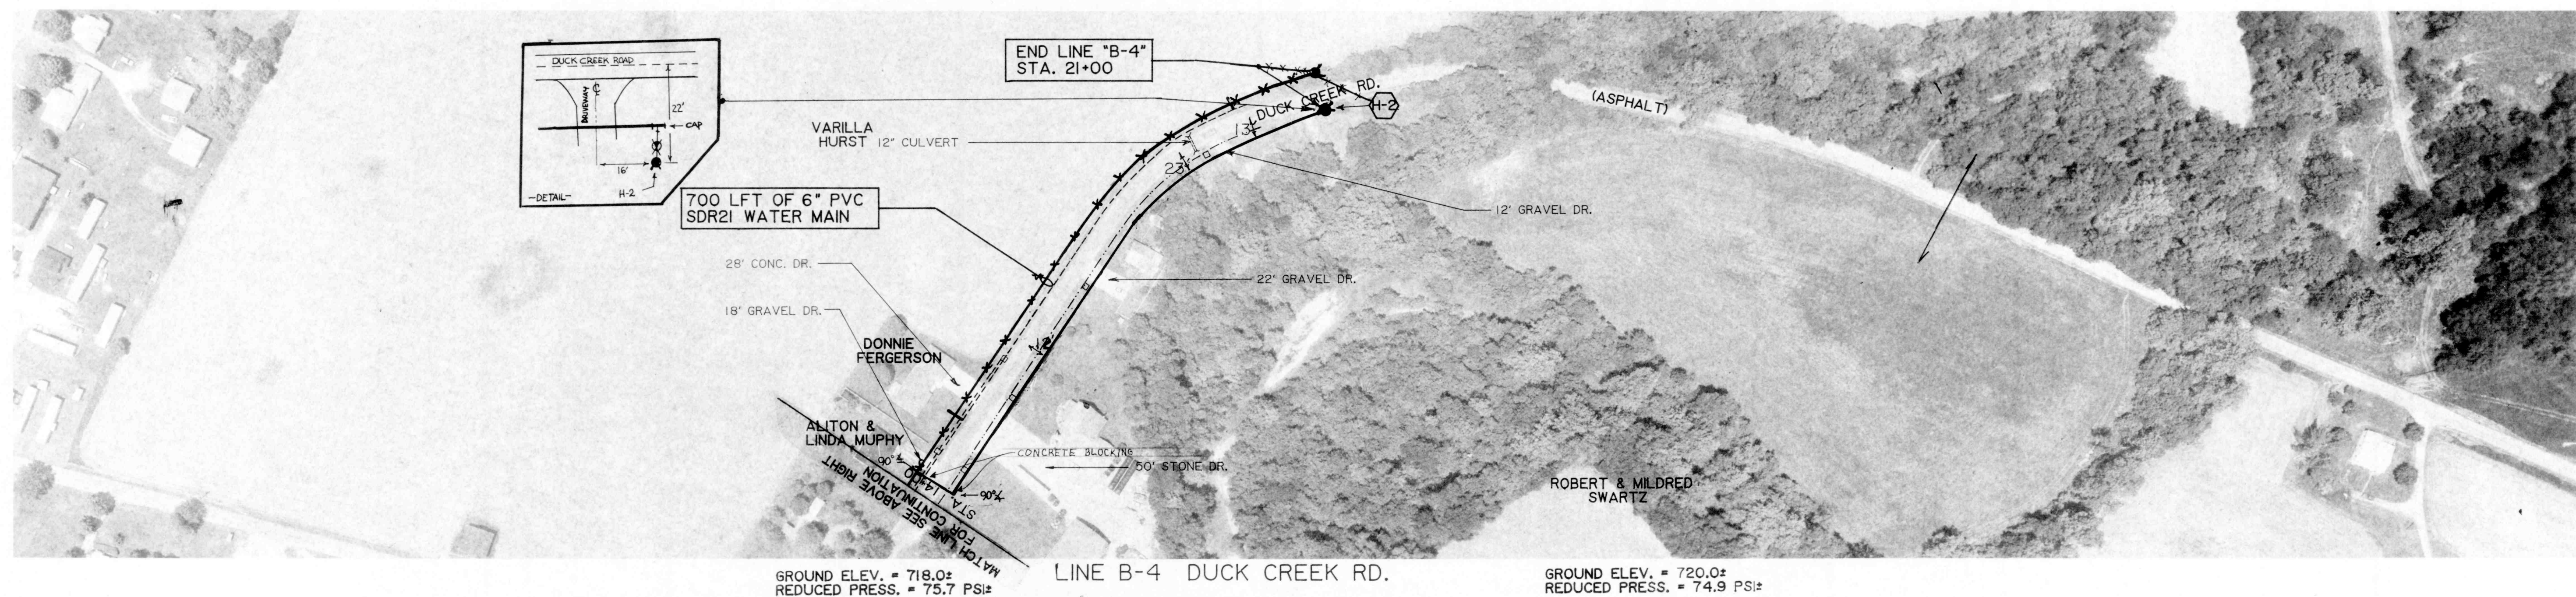


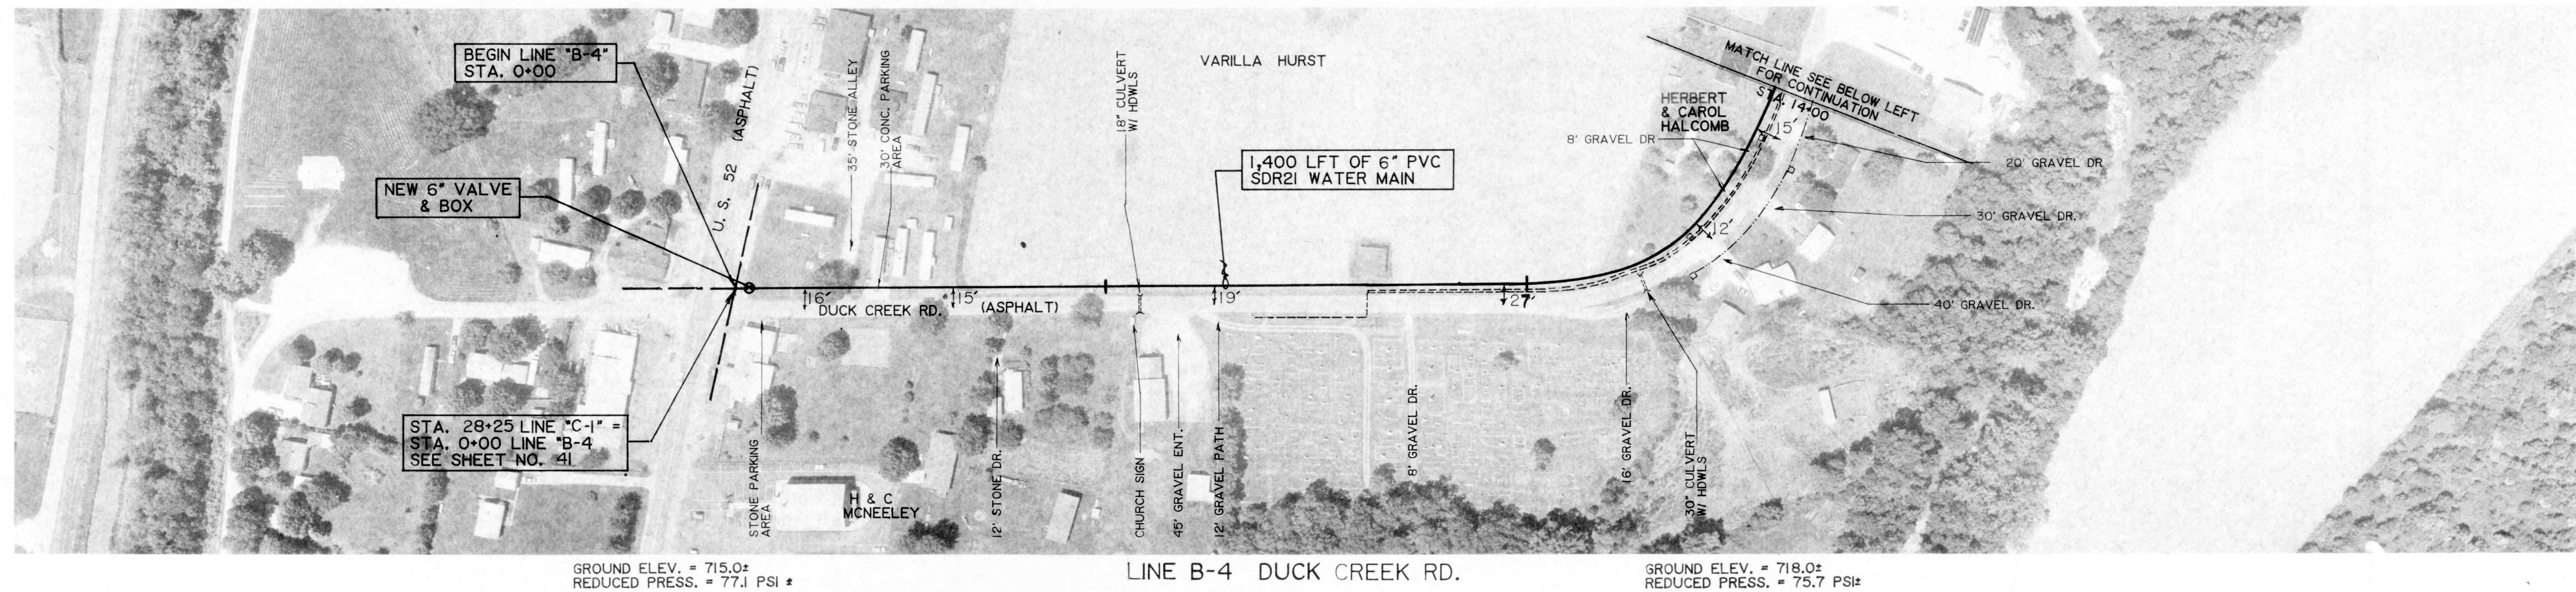

WESSLER and ASSOCIATES CONSULTING ENGINEERS 6219 South East Street, Suite A Indianapolis, Indiana 46227-2148		CONTRACT "A" WATER MAINS LINES B-3A & B-4 DIVISION "E" WATERWORKS SYSTEM IMPROVEMENTS	
SCALE: 1" = 100' DATE: OCT. 14, 1993 PROJECT NO.: 37391.04 DRAWN BY: CLG APPROVED BY: DSC	NOT PUBLISHED ALL RIGHTS RESERVED EXCEPT FOR USES EXPRESSLY PERMITTED IN WRITING, INFOR- MATION SHOWN OR INCLUDED IN THIS DOCUMENT IS SOLELY THE PROPERTY OF M.D. WESSLER & ASSOCIATES, INC.	10/17/94 CLG NO. 1 DATE BY	CORRECTED PROP. OWNERS REVISIONS
SHEET A 34 OF 45		PHOTOGRAPHY BY ACCURATE SURVEYS, INC., SEYMOUR, INDIANA	