


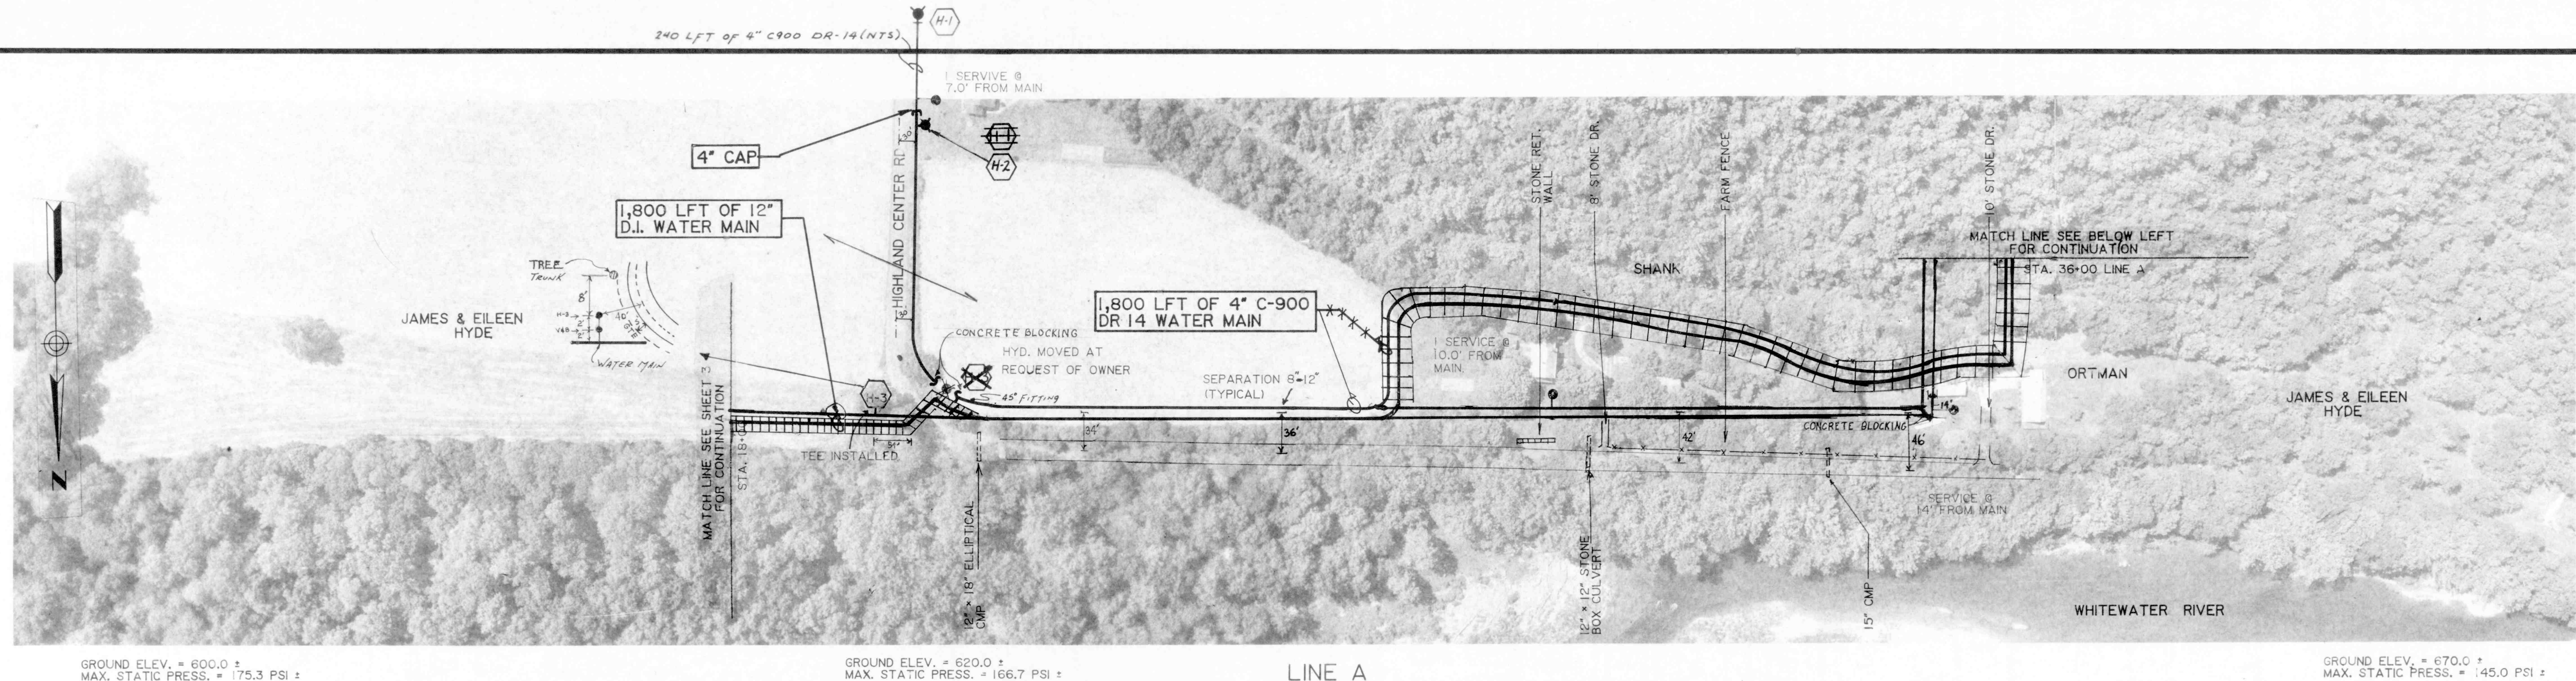


GROUND ELEV. = 600.0 ±  
MAX. STATIC PRESS. = 175.3 PSI ±

GROUND ELEV. = 620.0 ±  
MAX. STATIC PRESS. = 166.7 PSI ±

GROUND ELEV. = 670.0 ±  
MAX. STATIC PRESS. = 145.0 PSI ±

LINE A

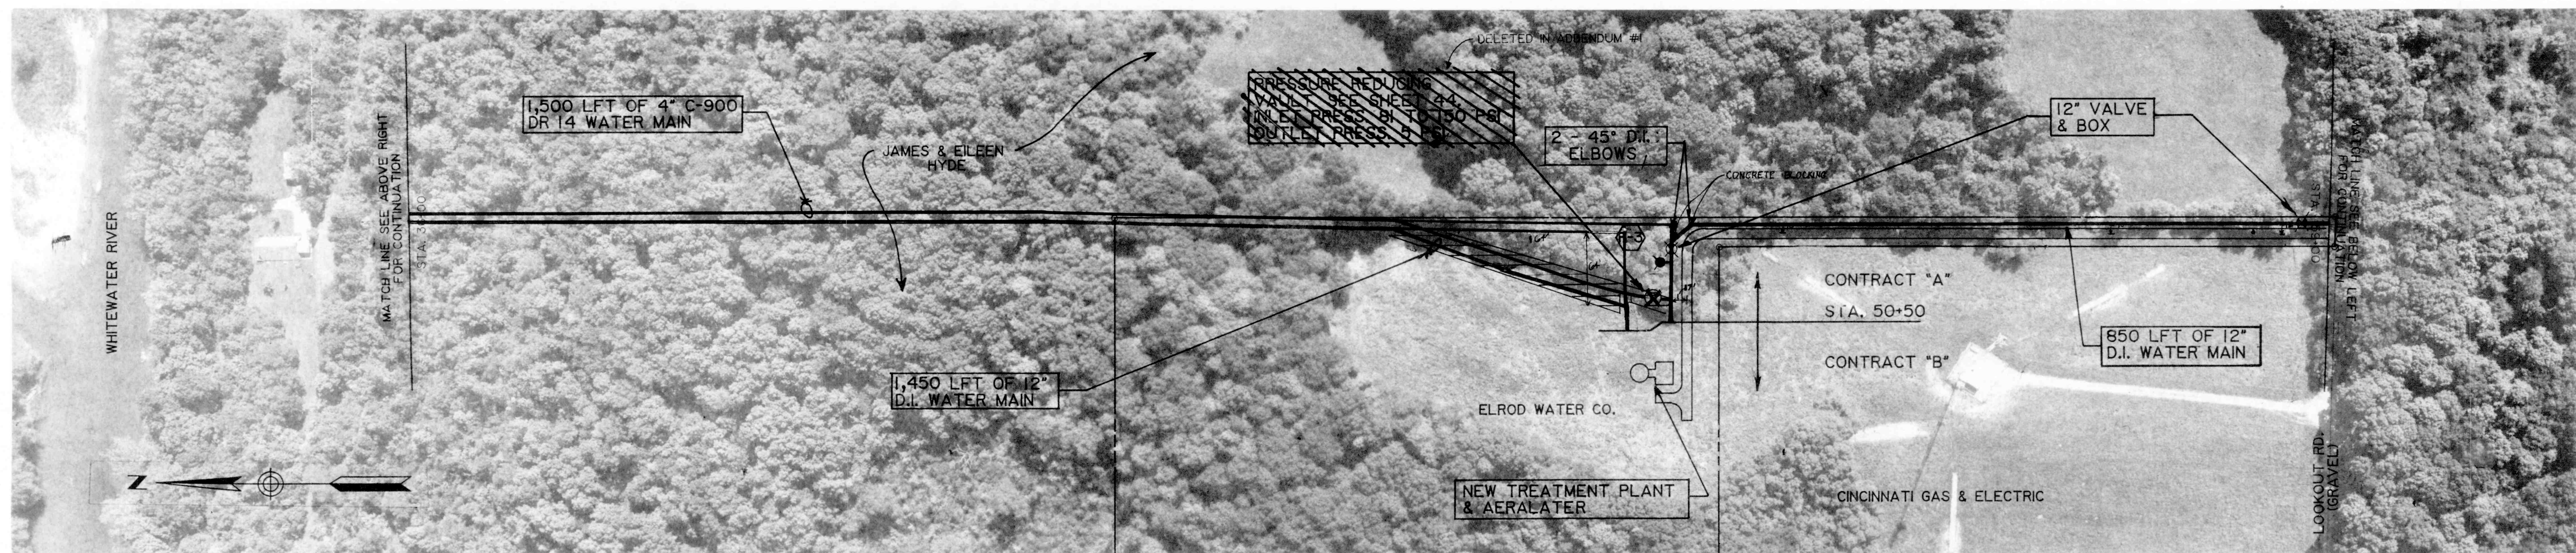


GROUND ELEV. = 670.0 ±  
MAX. STATIC PRESS. = 145.0 PSI ±

GROUND ELEV. = 972.0 ±  
MAX. STATIC PRESS. INLET = 14.3 PSI ±  
MAX. STATIC PRESS. OUTLET = 81.4 PSI ±

GROUND ELEV. = 980.0 ±  
MAX. STATIC PRESS. = 77.9 PSI ±

LINE A - TREATMENT PLANT

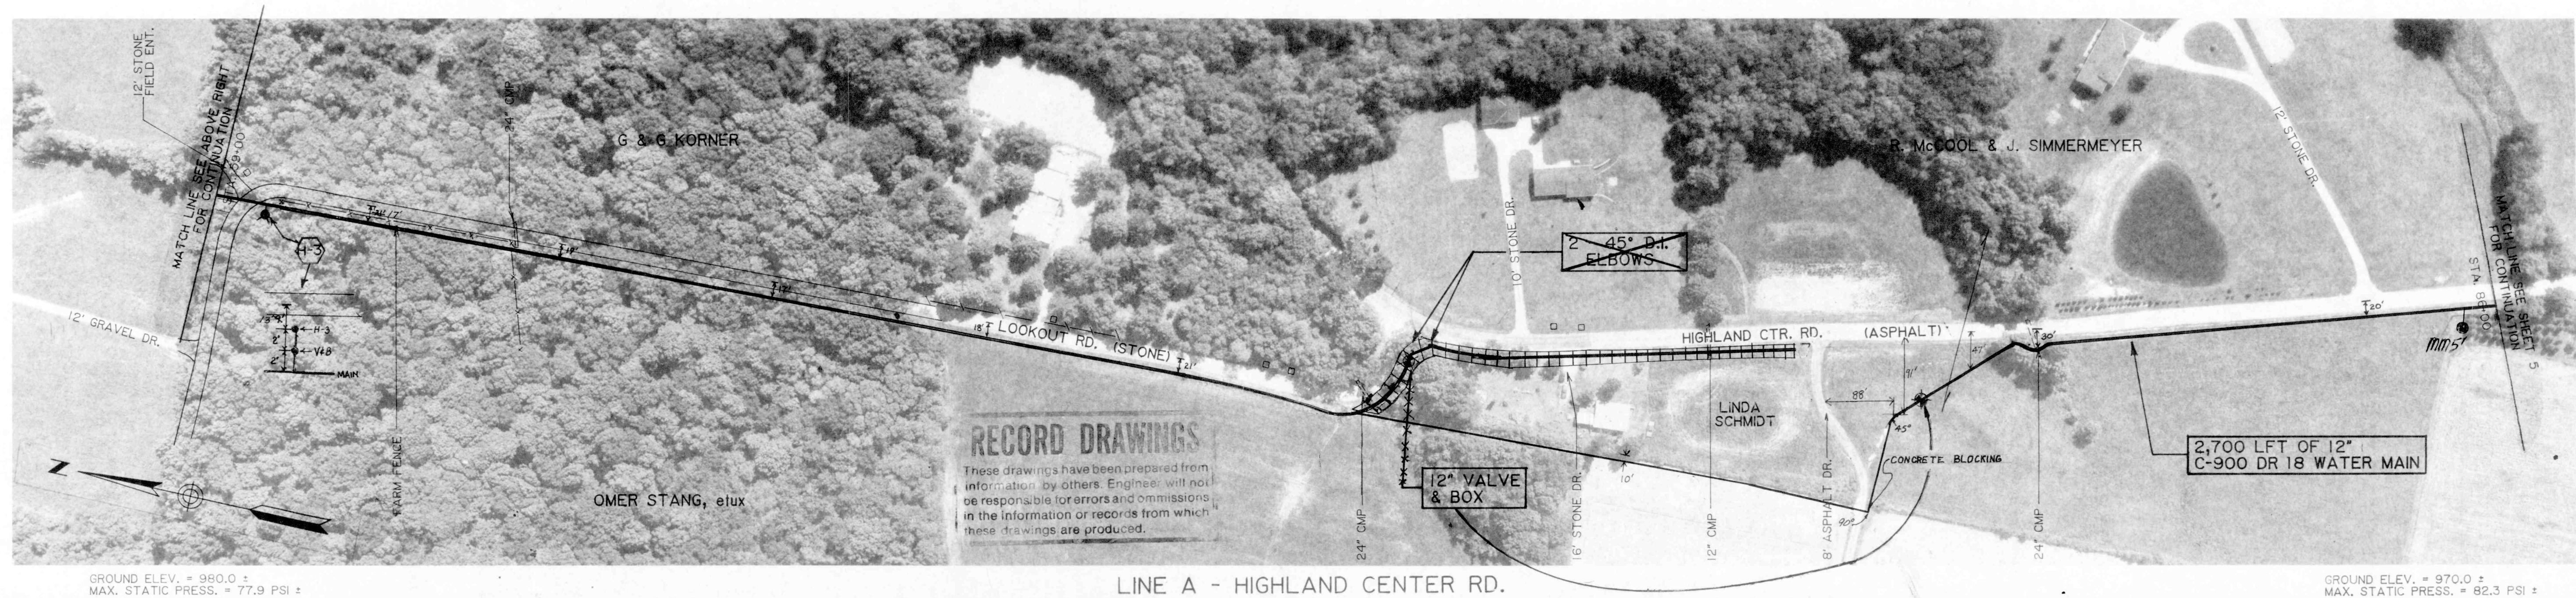

GROUND ELEV. = 980.0 ±  
MAX. STATIC PRESS. = 77.9 PSI ±

GROUND ELEV. = 970.0 ±  
MAX. STATIC PRESS. = 82.3 PSI ±

LINE A - HIGHLAND CENTER RD.

|   |   |   |   |
|---|---|---|---|
| <b>CONTRACT "A"</b><br><b>WATER MAINS</b><br><b>LINE "A"</b>                                          |   | <b>ELROD WATER COMPANY, INC.</b><br><b>DIVISION "E"</b><br><b>WATERWORKS SYSTEM IMPROVEMENTS</b>                                 |   |
| SCALE: 1" = 100'<br>DATE: OCT. 14, 1993<br>PROJECT NO.: 37391.04<br>DRAWN BY: CLG<br>APPROVED BY: DGC | NOT PUBLISHED<br>ALL RIGHTS RESERVED<br>EXCEPT FOR USES EXPRESSLY<br>PERMITTED IN WRITING, INFOR-<br>MATION SHOWN OR INCLUDED<br>IN THIS DOCUMENT IS SOLELY<br>THE PROPERTY OF M.D.<br>WESSLER & ASSOCIATES, INC. | M.D. WESSLER<br>and<br>ASSOCIATES<br>CONSULTING ENGINEERS<br>6219 South East Street, Suite A<br>Indianapolis, Indiana 46227-2148 | NO. 2<br>DATE 10/3/94<br>BY CLG<br>REVISIONS<br>CORRECTED PROP. OWNERS<br>CHANGED PIPE TYPES, ADDED LINE & PRV STATION. |
| SHEET A4<br>OF 45                                                                                     |   | PHOTOGRAPHY BY ACCU-AR SURVEYS, INC., SEYMOUR, INDIANA                                                                           |   |