



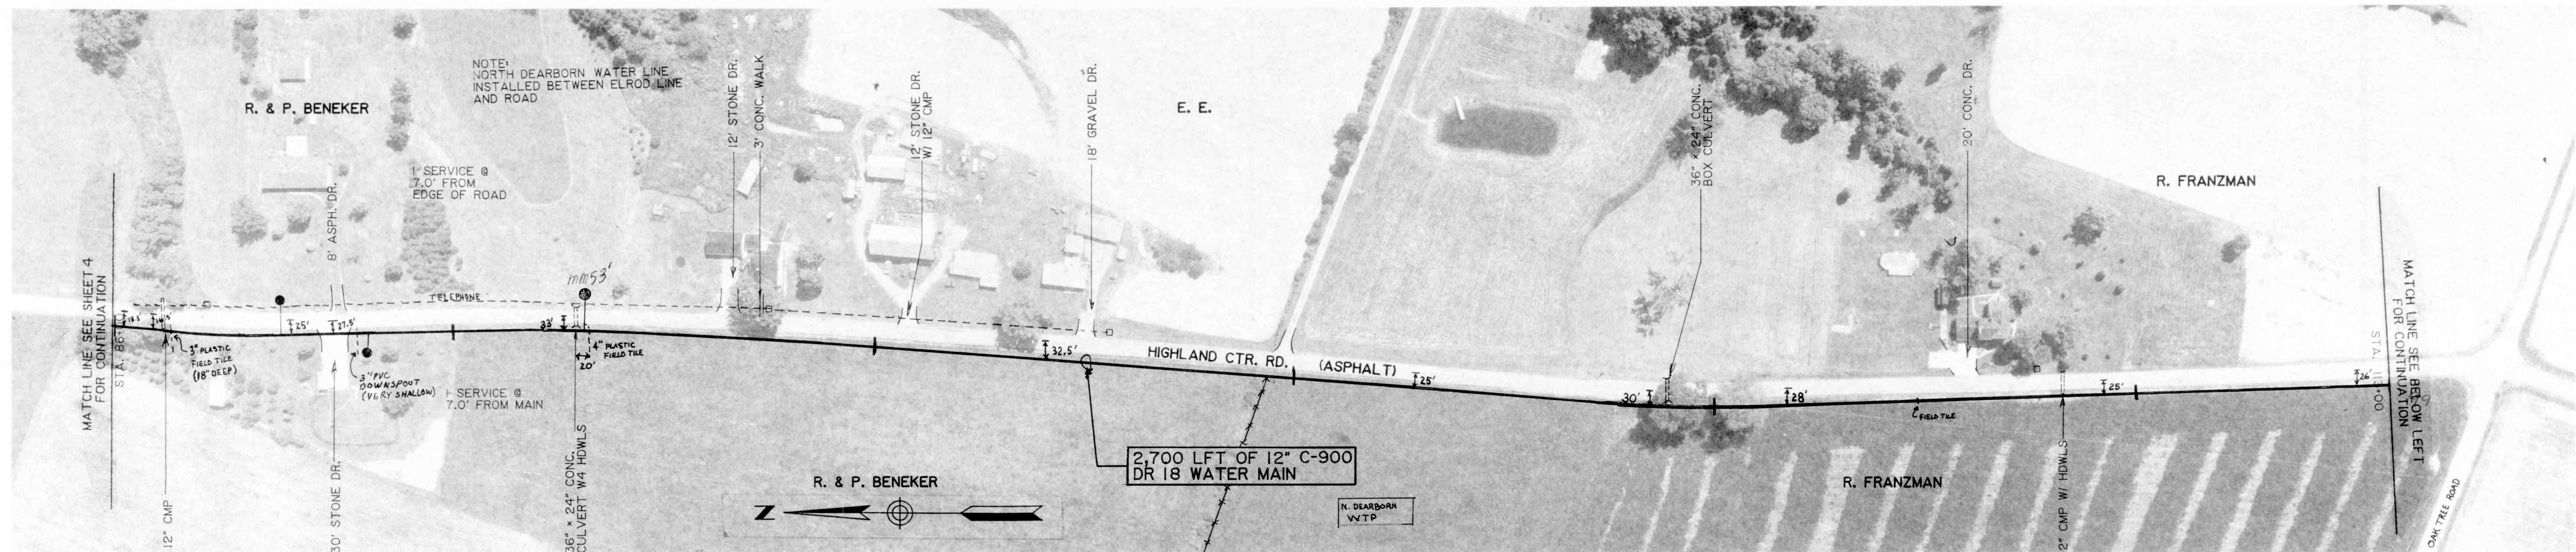

GROUND ELEV. = 970.0 ±
MAX. STATIC PRESS. = 82.3 PSI ±

LINE A HIGHLAND CENTER RD.


GROUND ELEV. = 993.0 ±
MAX. STATIC PRESS. = 72.3 PSI ±

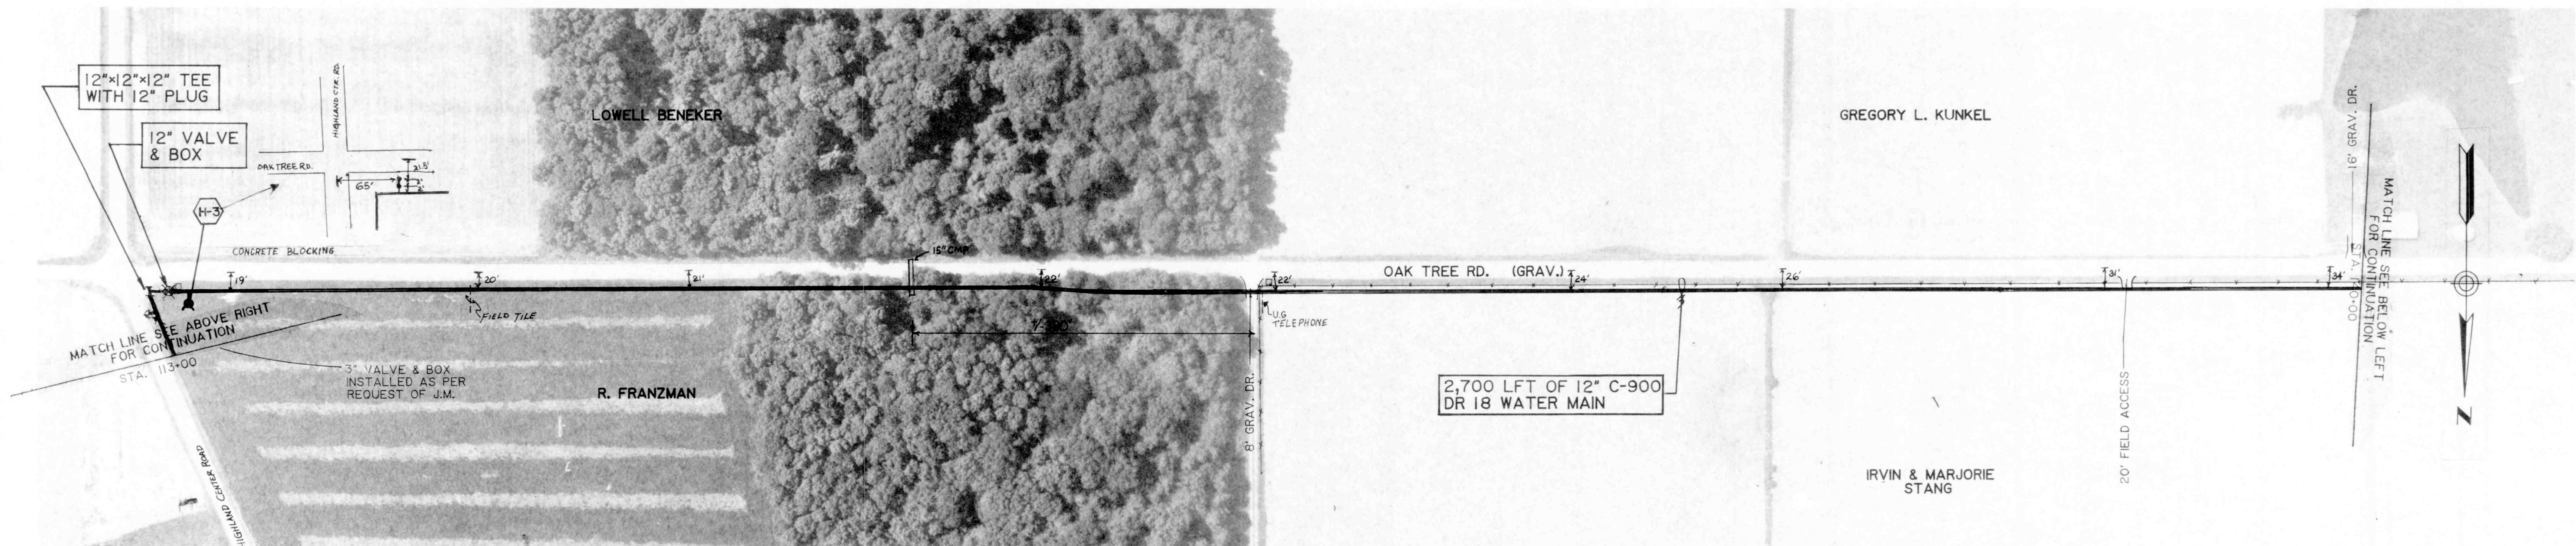

GROUND ELEV. = 993.0 ±
MAX. STATIC PRESS. = 72.3 PSI ±

LINE A OAK TREE RD.

GROUND ELEV. = 990.0 ±
MAX. STATIC PRESS. = 73.6 PSI ±

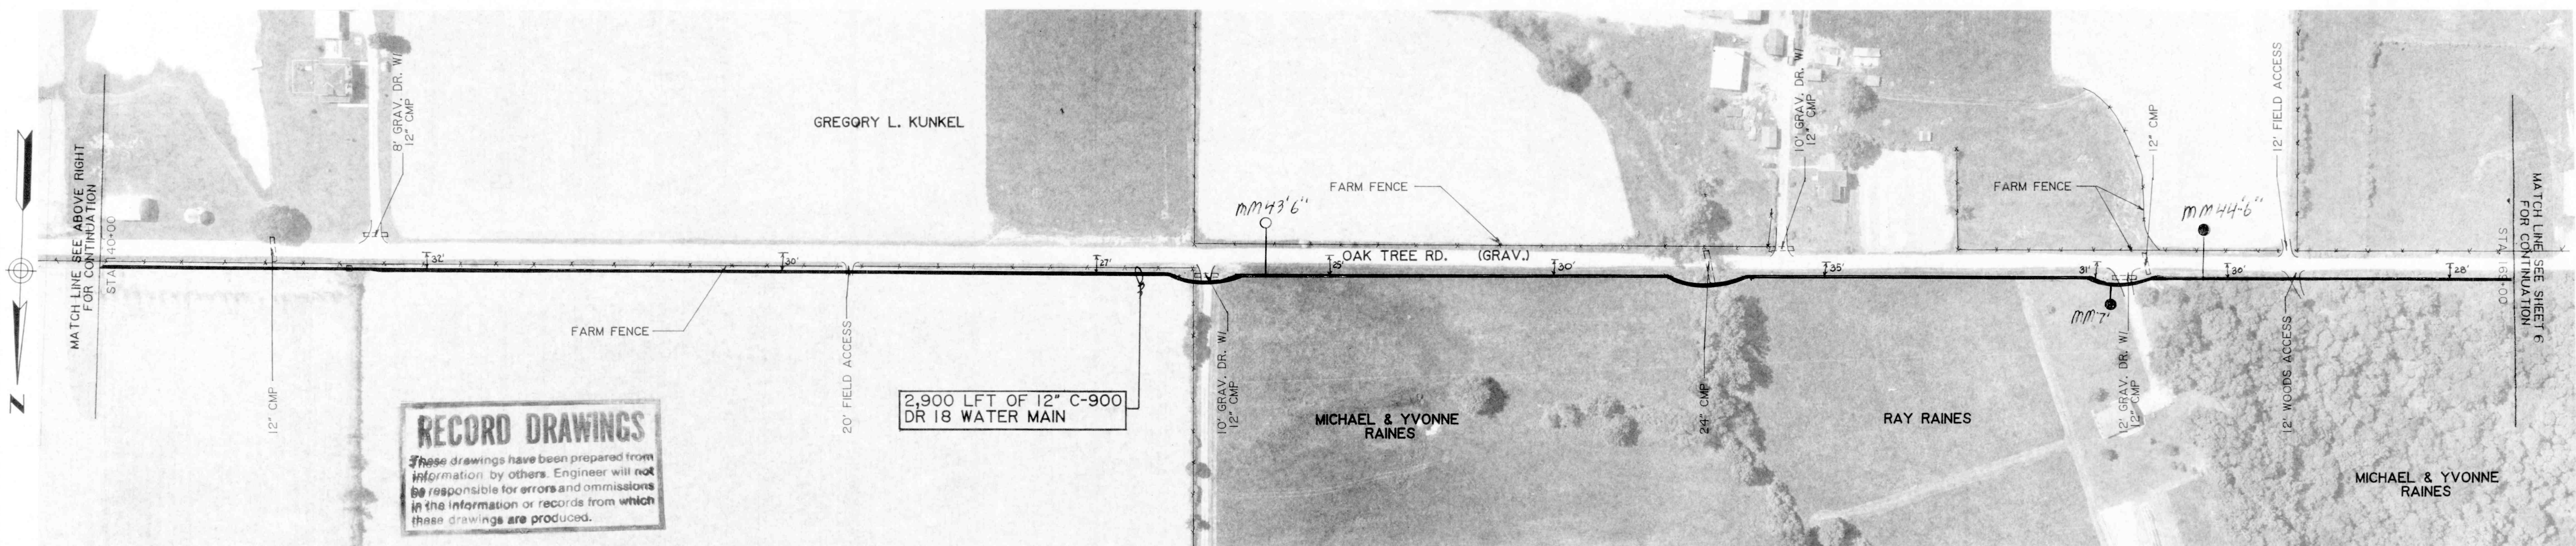

GROUND ELEV. = 990.0 ±
MAX. STATIC PRESS. = 73.6 PSI ±

LINE A OAK TREE RD.

GROUND ELEV. = 970.0 ±
MAX. STATIC PRESS. = 82.3 PSI ±

CONTRACT "A"
WATER MAINS
LINE "A"

ELROD WATER COMPANY, INC.
DIVISION "E"

WATERWORKS SYSTEM IMPROVEMENTS

M.D. WESSLER and ASSOCIATES
CONSULTING ENGINEERS
8219 South East Street, Suite A
Indianapolis, Indiana 46227-2148

NO.	DATE	BY	REVISIONS
2	10/3/94	CLG	CORRECTED PROP. OWNERS
1	3/4/94	CLG	CHANGED PIPE TYPES

SCALE: 1" = 100'

DATE: OCT. 14, 1993

PROJECT NO.: 37391.04

DRAWN BY: CLG

APPROVED BY: DGC

NOT PUBLISHED
ALL RIGHTS RESERVED

EXCEPT FOR USES EXPRESSLY
PERMITTED IN WRITING, INFOR-
MATION SHOWN OR INCLUDED
IN THIS DOCUMENT IS SOLELY
THE PROPERTY OF M.D.
WESSLER & ASSOCIATES, INC.

SEAL
13334
STATE OF INDIANA
PROFESSIONAL ENGINEER

PHOTOGRAPHY BY ACCU-LAR SURVEYS, INC., SEYMOUR, INDIANA

SHEET A5

OF 45