



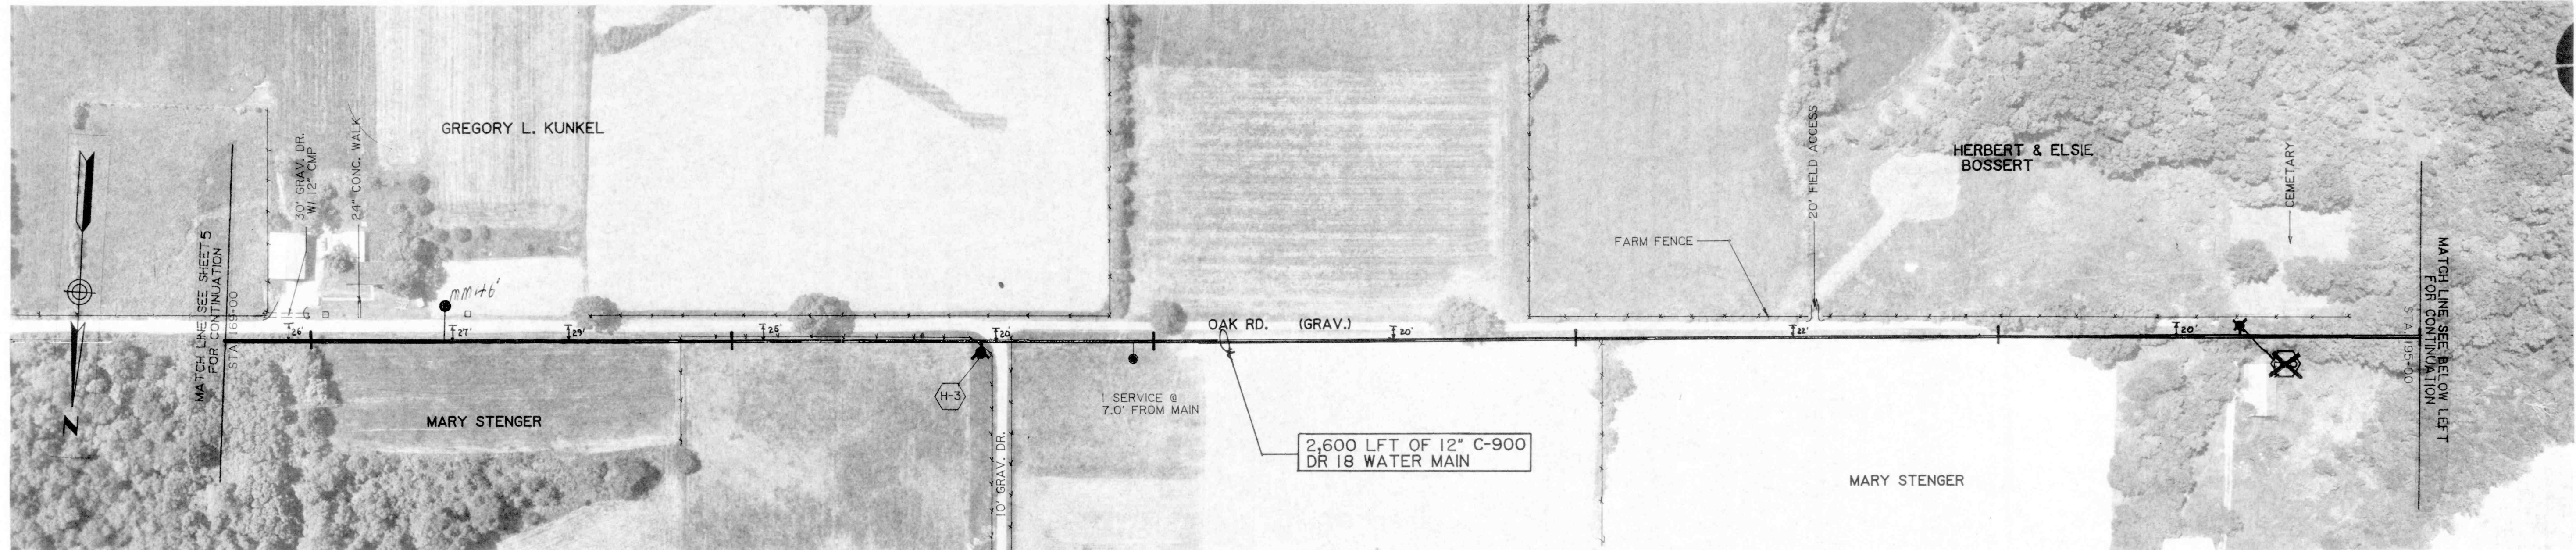

GROUND ELEV. = 970.0 ±
MAX. STATIC PRESS. = 82.3 PSI ±

LINE A OAK TREE RD.

GROUND ELEV. = 980.0 ±
MAX. STATIC PRESS. = 77.9 PSI ±

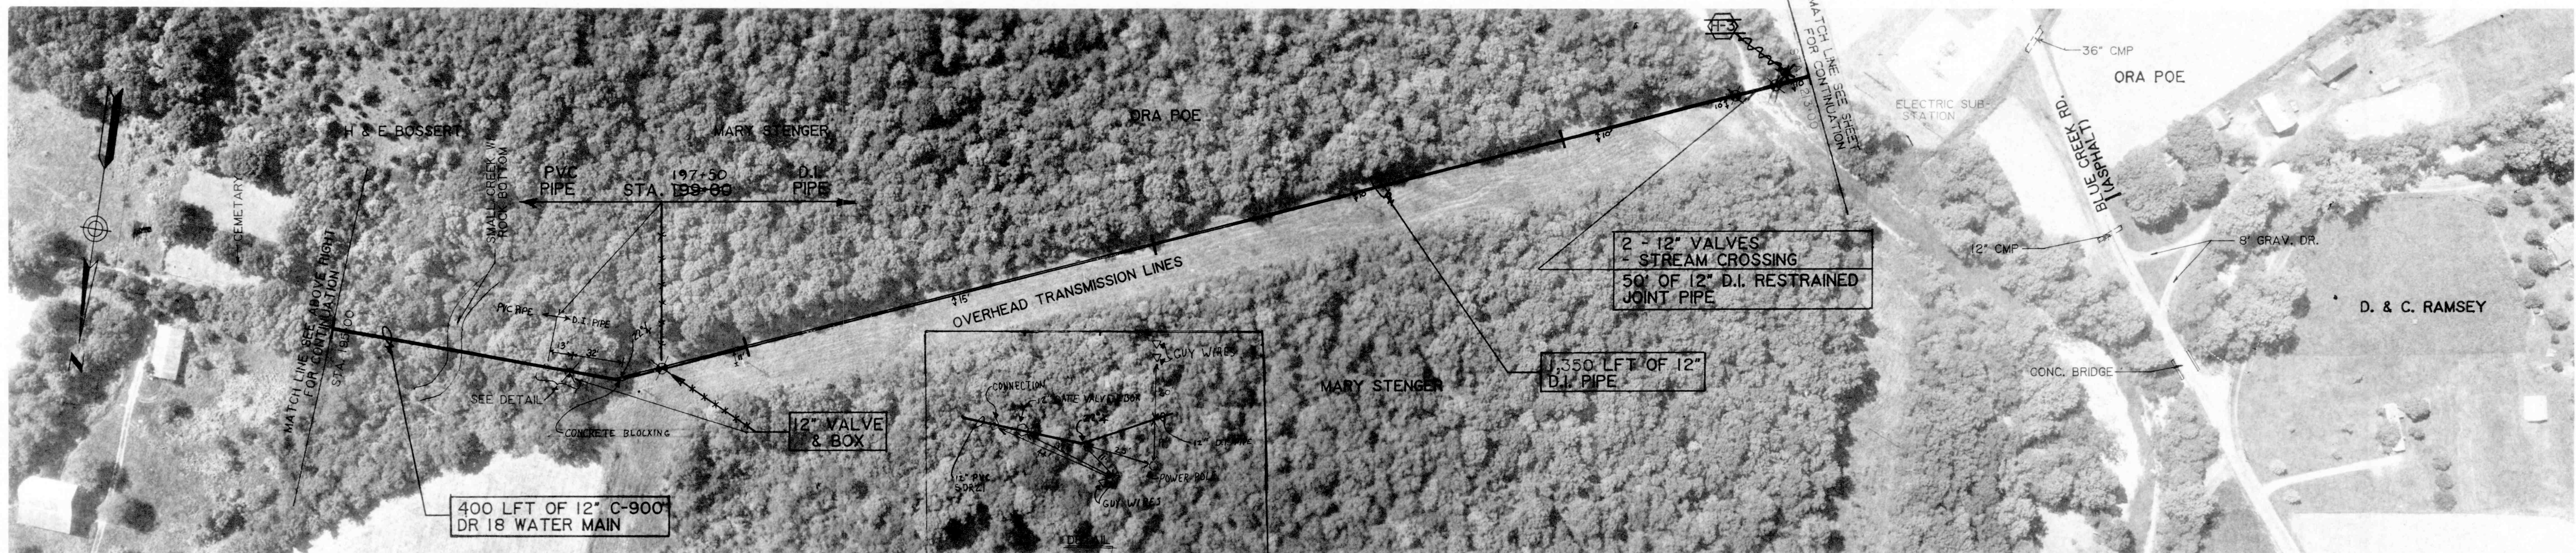


GROUND ELEV. = 980.0 ±
MAX. STATIC PRESS. = 77.9 ±

GROUND ELEV. = 960.0 ±
MAX. STATIC PRESS. = 86.6 PSI ±

LINE A EASEMENT

GROUND ELEV. = 670.0 ±
MAX. STATIC PRESS. = 212.2 PSI ±

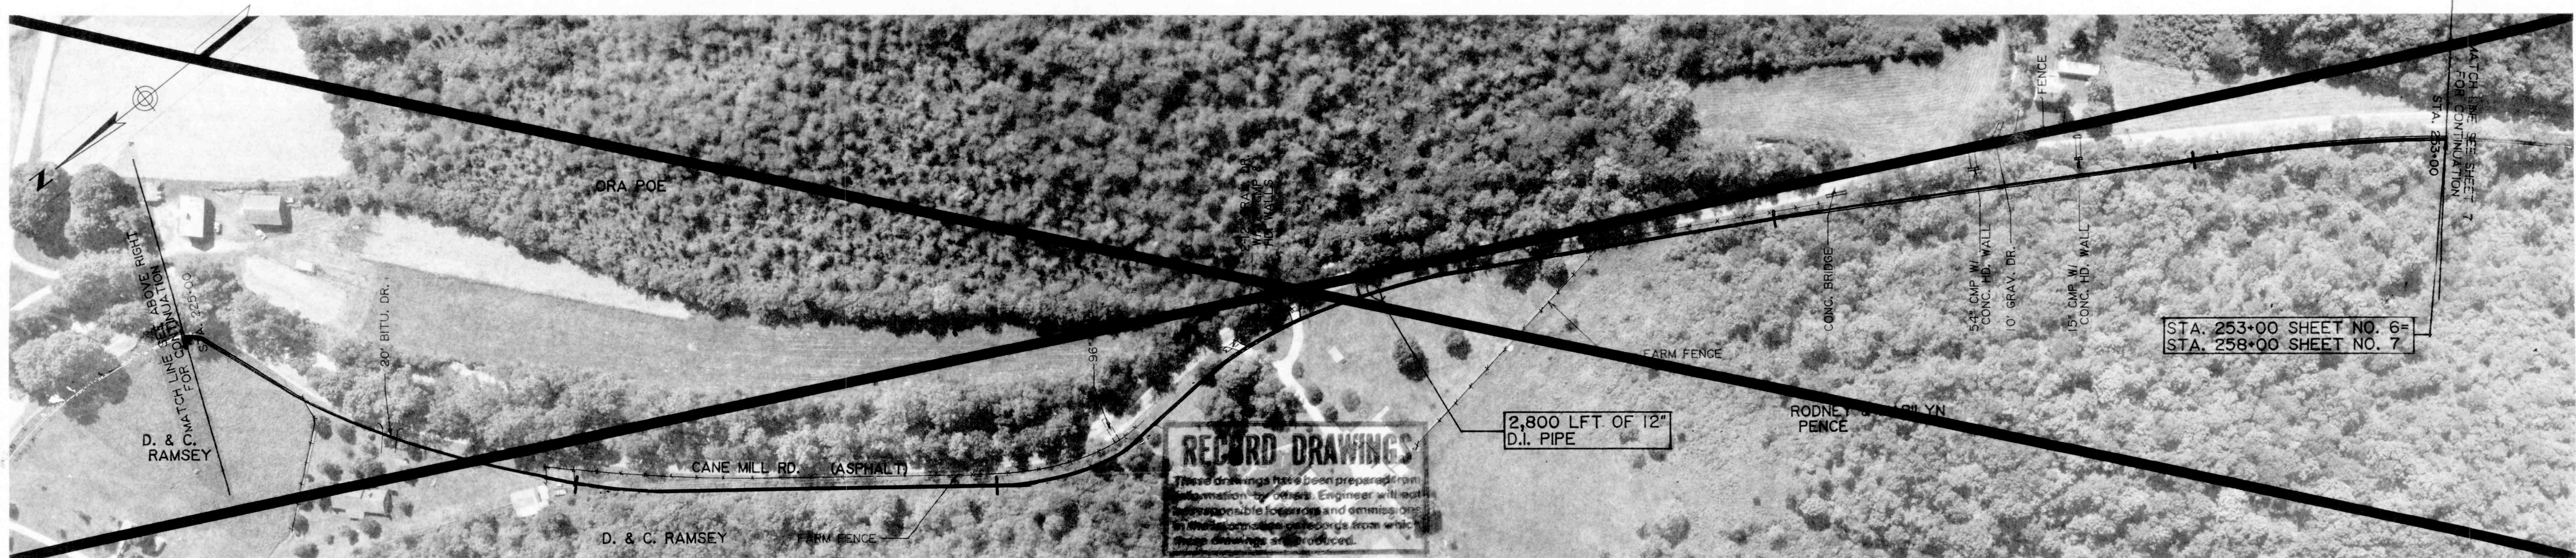

GROUND ELEV. = 670.0 ±
MAX. STATIC PRESS. = 212.2 PSI ±

GROUND ELEV. = 710.0 ±
MAX. STATIC PRESS. = 194.8 PSI ±

LINE A CANE MILL RD.

GROUND ELEV. = 730.0 ±
MAX. STATIC PRESS. = 186.2 PSI ±

GROUND ELEV. = 760.0 ±
MAX. STATIC PRESS. = 173.2 PSI ±

CONTRACT "A"
WATER MAINS
LINE "A"

ELROD WATER COMPANY, INC.
DIVISION "E"
WATERWORKS SYSTEM IMPROVEMENTS

M.D. WESSLER
and
ASSOCIATES
CONSULTING ENGINEERS

6219 South East Street, Suite A
Indianapolis, Indiana 46227-2148

SCALE: 1" = 100'
DATE: OCT. 14, 1993
PROJECT NO.: 37391.04
DRAWN BY: CLG
APPROVED BY: DCC

NOT PUBLISHED
ALL RIGHTS RESERVED
EXCEPT FOR USES EXPRESSLY
PERMITTED IN WRITING, INFOR-
MATION SHOWN OR INCLUDED
IN THIS DOCUMENT IS SOLELY
THE PROPERTY OF M.D.
WESSLER & ASSOCIATES, INC.

