
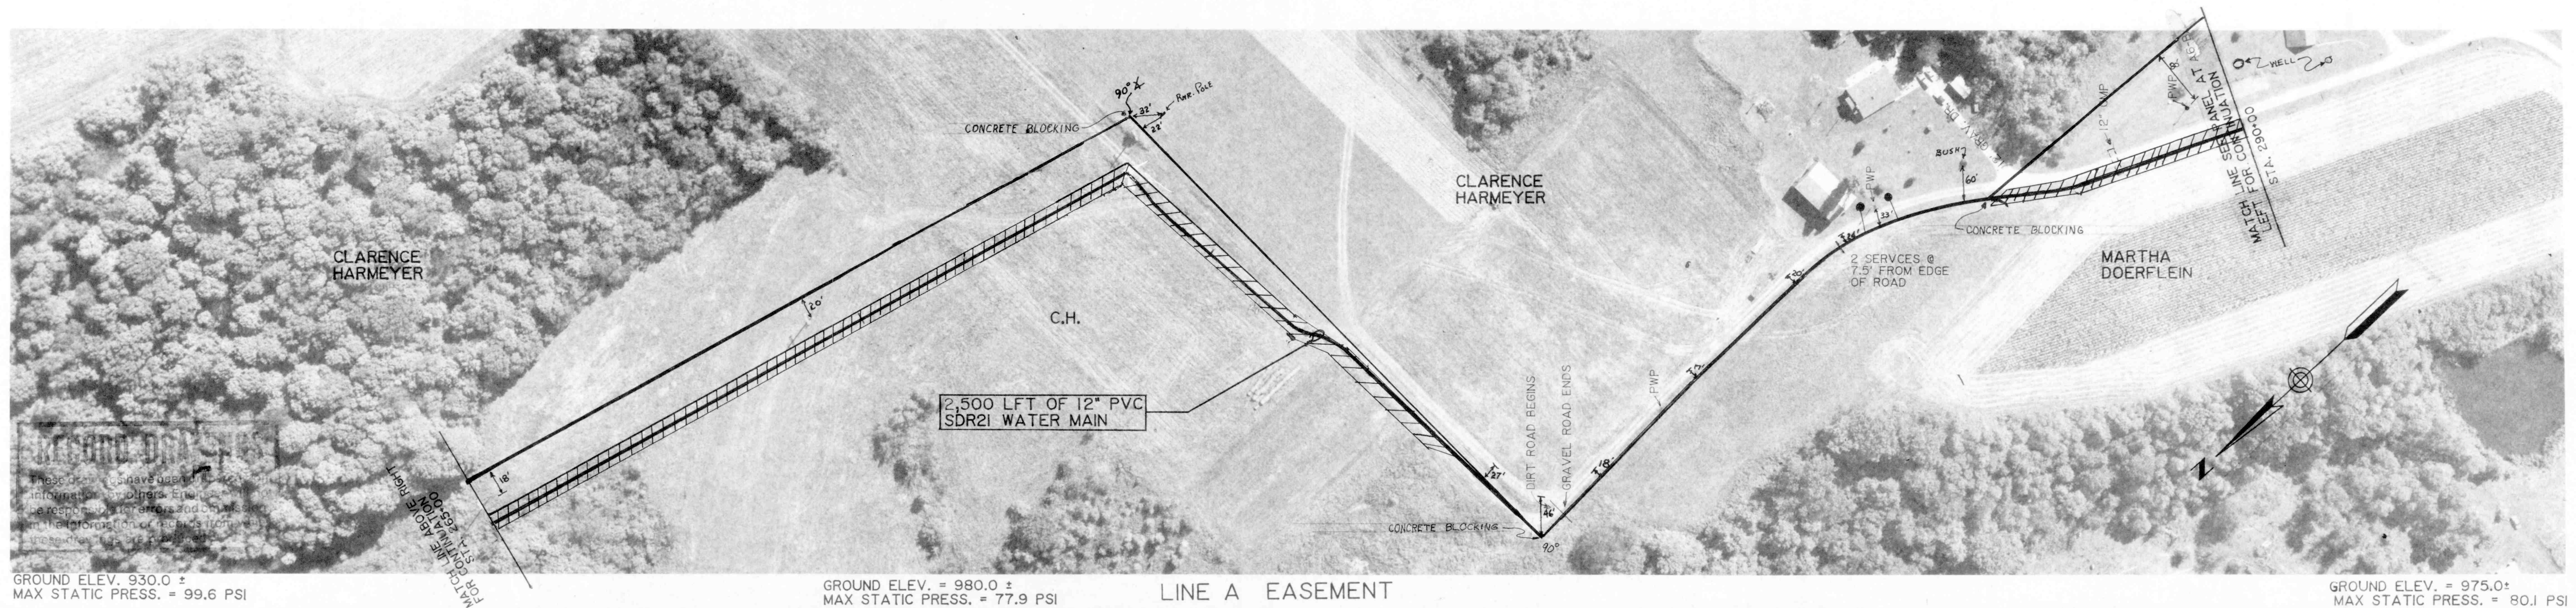
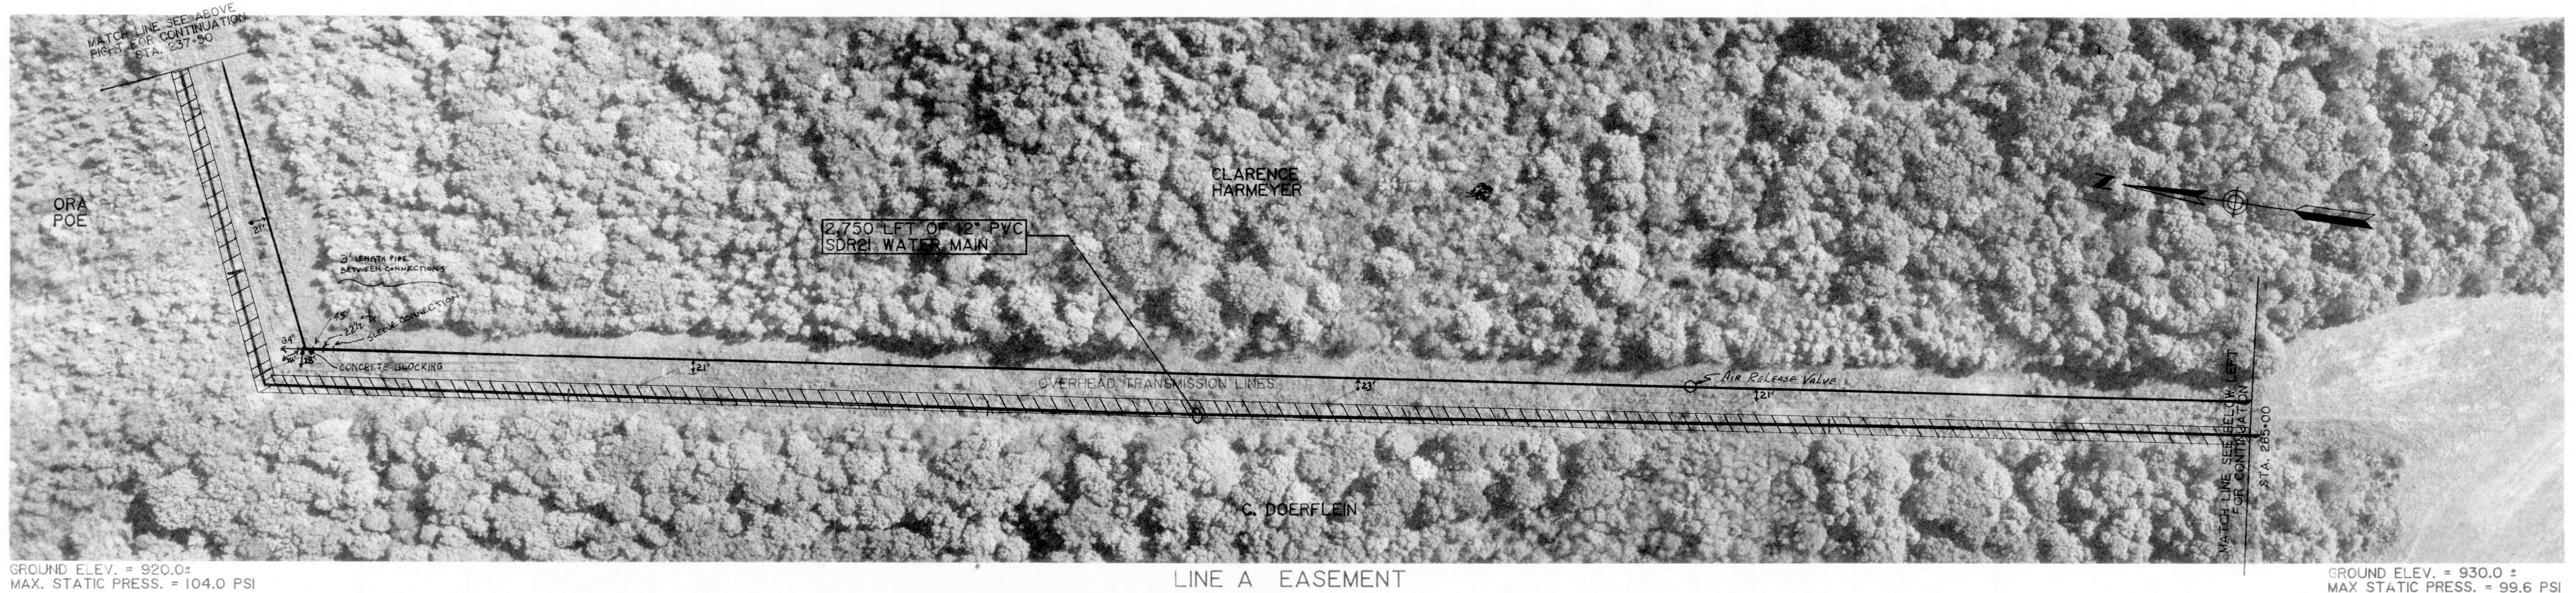


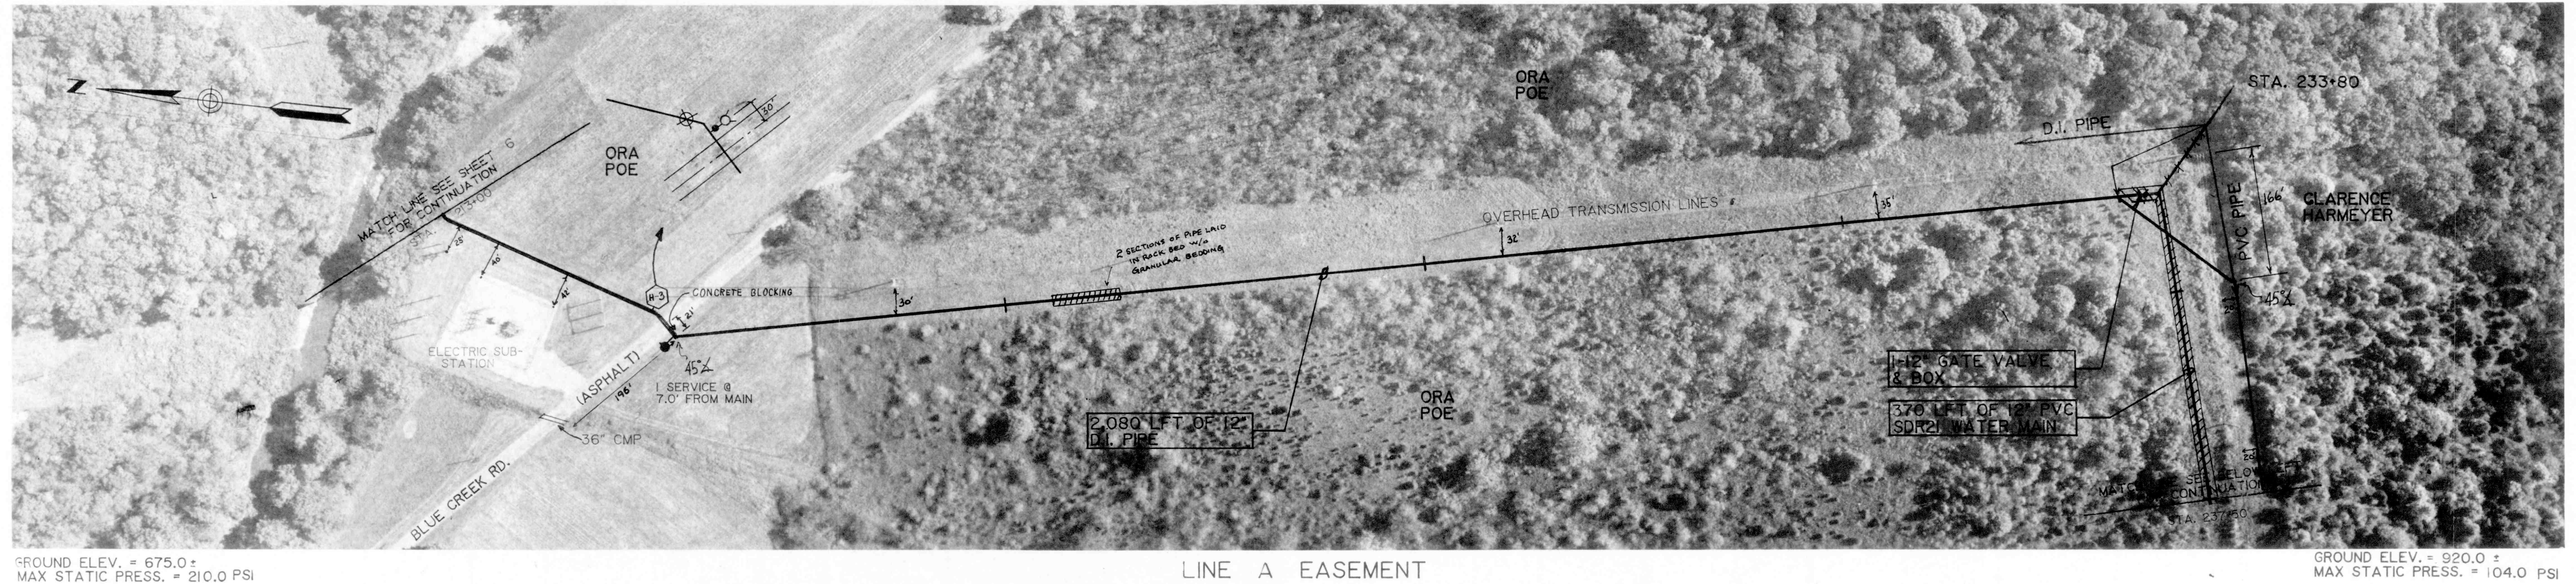

CONTRACT "A"
WATER MAINS

ELROD WATER COMPANY, INC.
DIVISION "E"
WATERWORKS SYSTEM IMPROVEMENTS

M.D. WESSLER and ASSOCIATES
CONSULTING ENGINEERS
6219 South East Street, Suite A
Indianapolis, Indiana 46227-2148

SCALE: 1" = 100'
DATE: 3/31/94
PROJECT NO.: 37391.04
DRAWN BY: CLG
APPROVED BY: MAW

NOT PUBLISHED
ALL RIGHTS RESERVED
EXCEPT FOR USES EXPRESSLY
PERMITTED IN WRITING, INFOR-
MATION SHOWN OR INCLUDED
IN THIS DOCUMENT IS SOLELY
THE PROPERTY OF M.D.
WESSLER & ASSOCIATES, INC.



SHEET A6-A
OF 45

PHOTOGRAPHY BY ACO-AIR SURVEYS, INC., SEYMOUR, INDIANA