




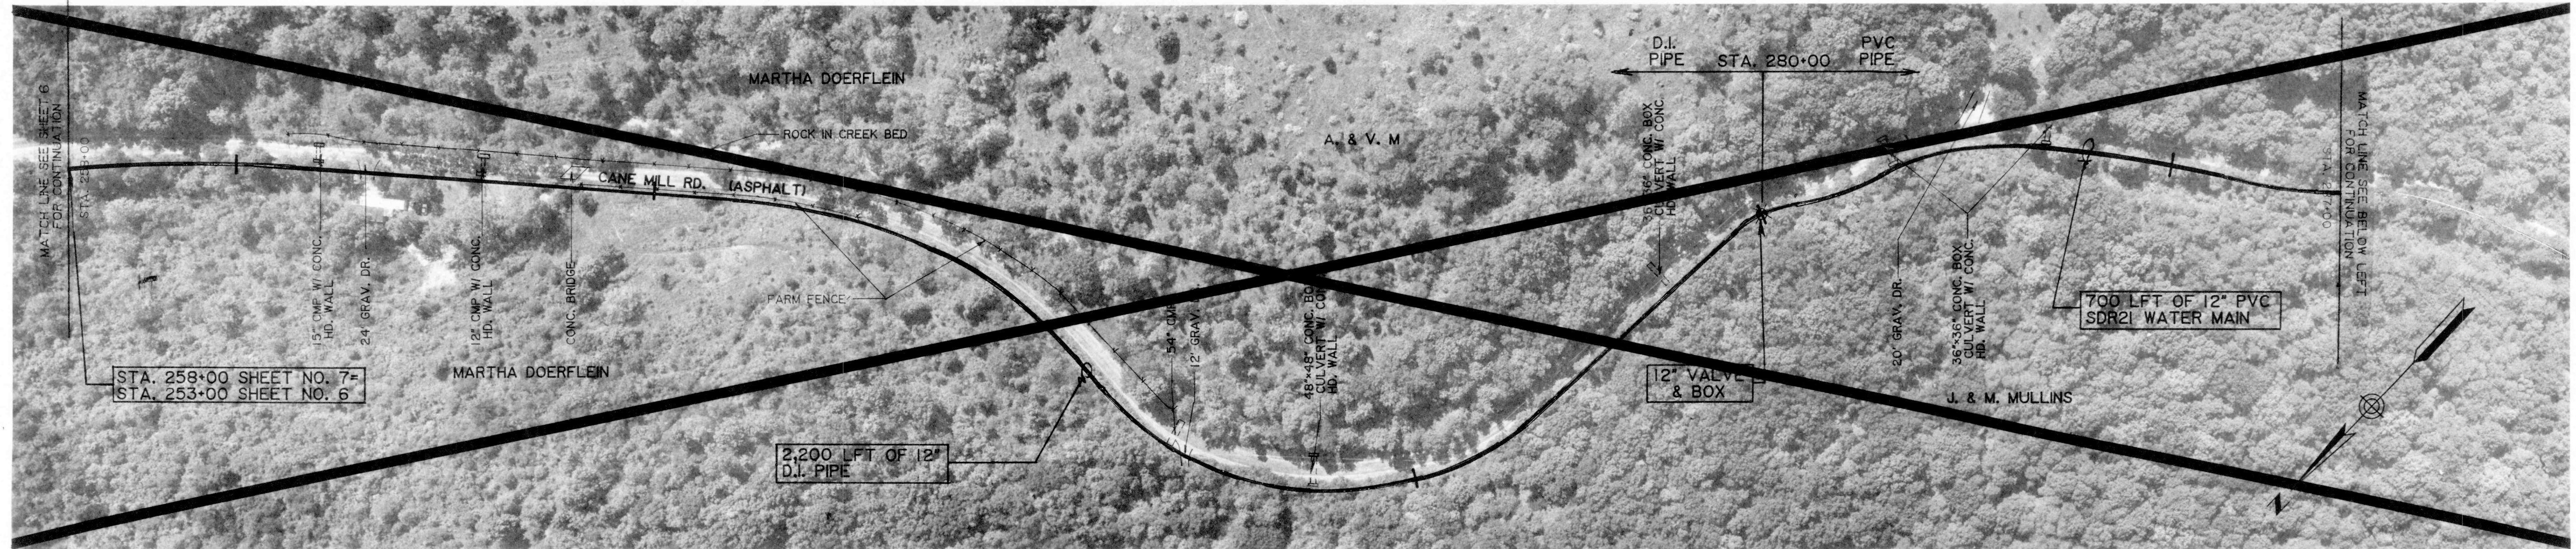


LINE A CANE MILL RD.

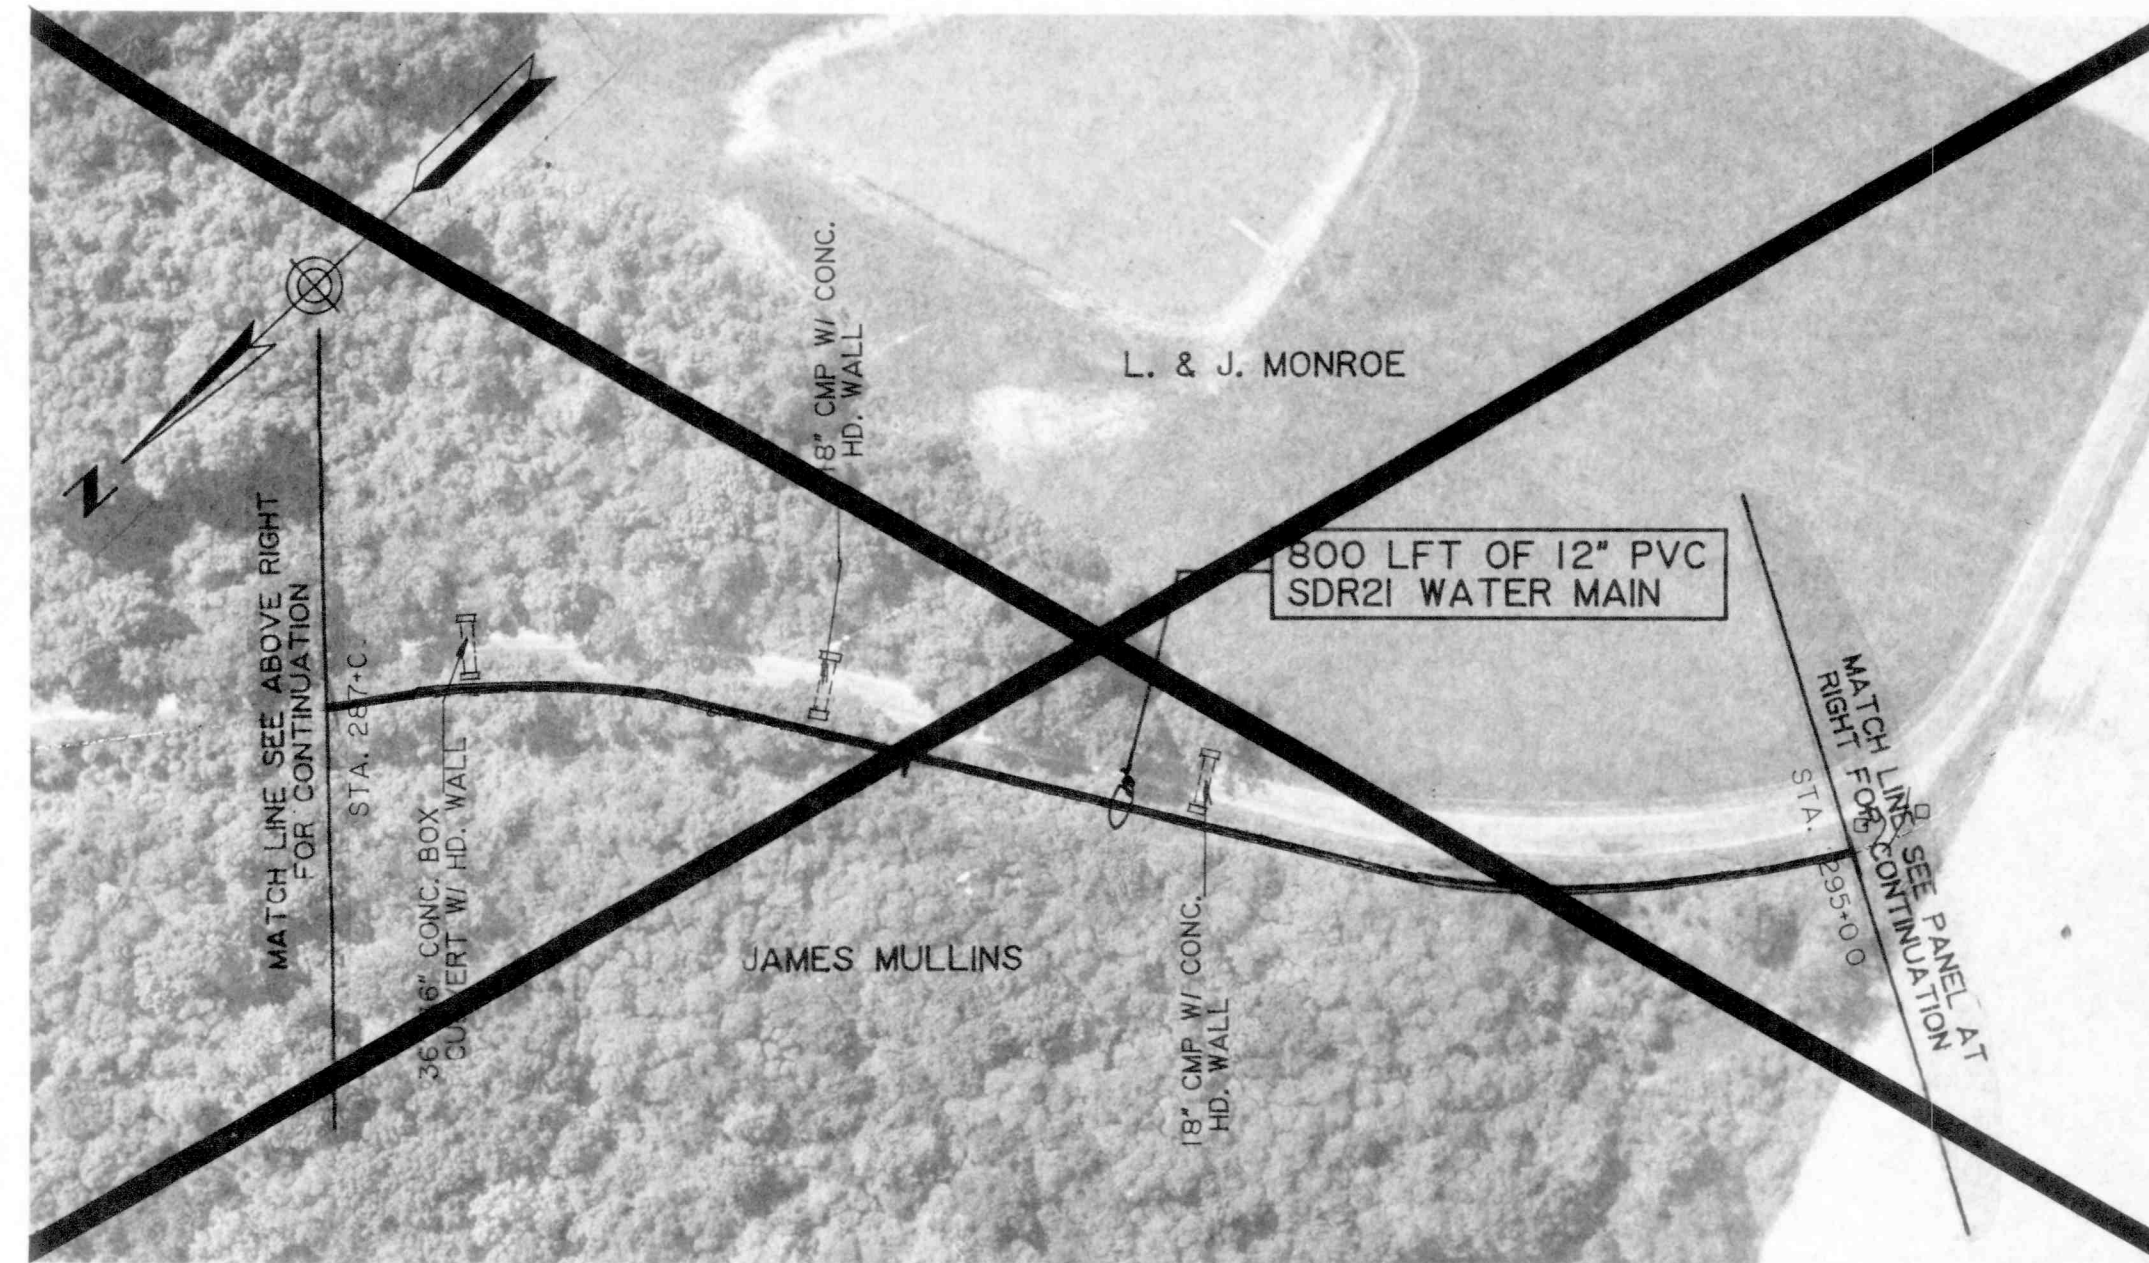

LINE A CANE MILL RD.

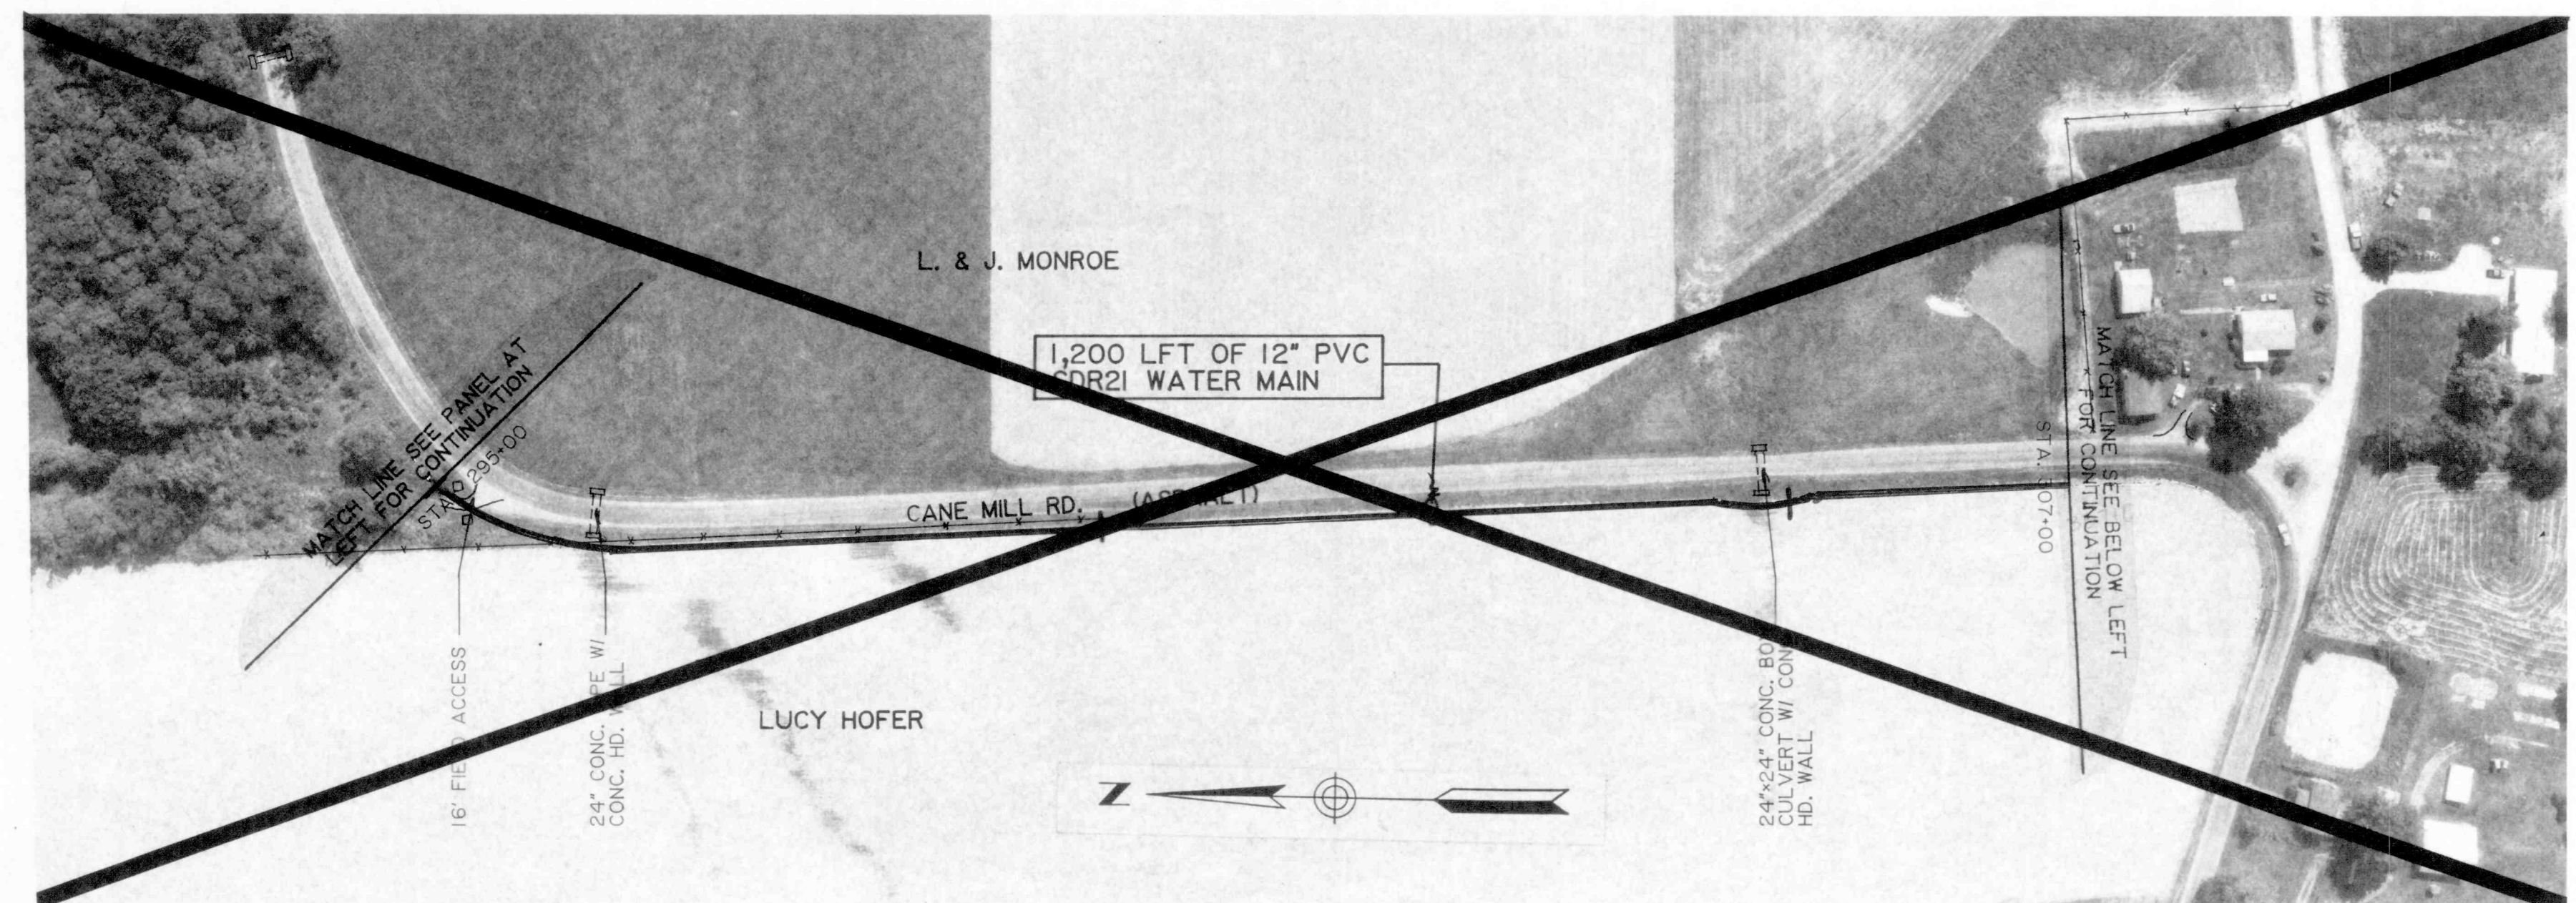

LINE A CANE MILL RD.

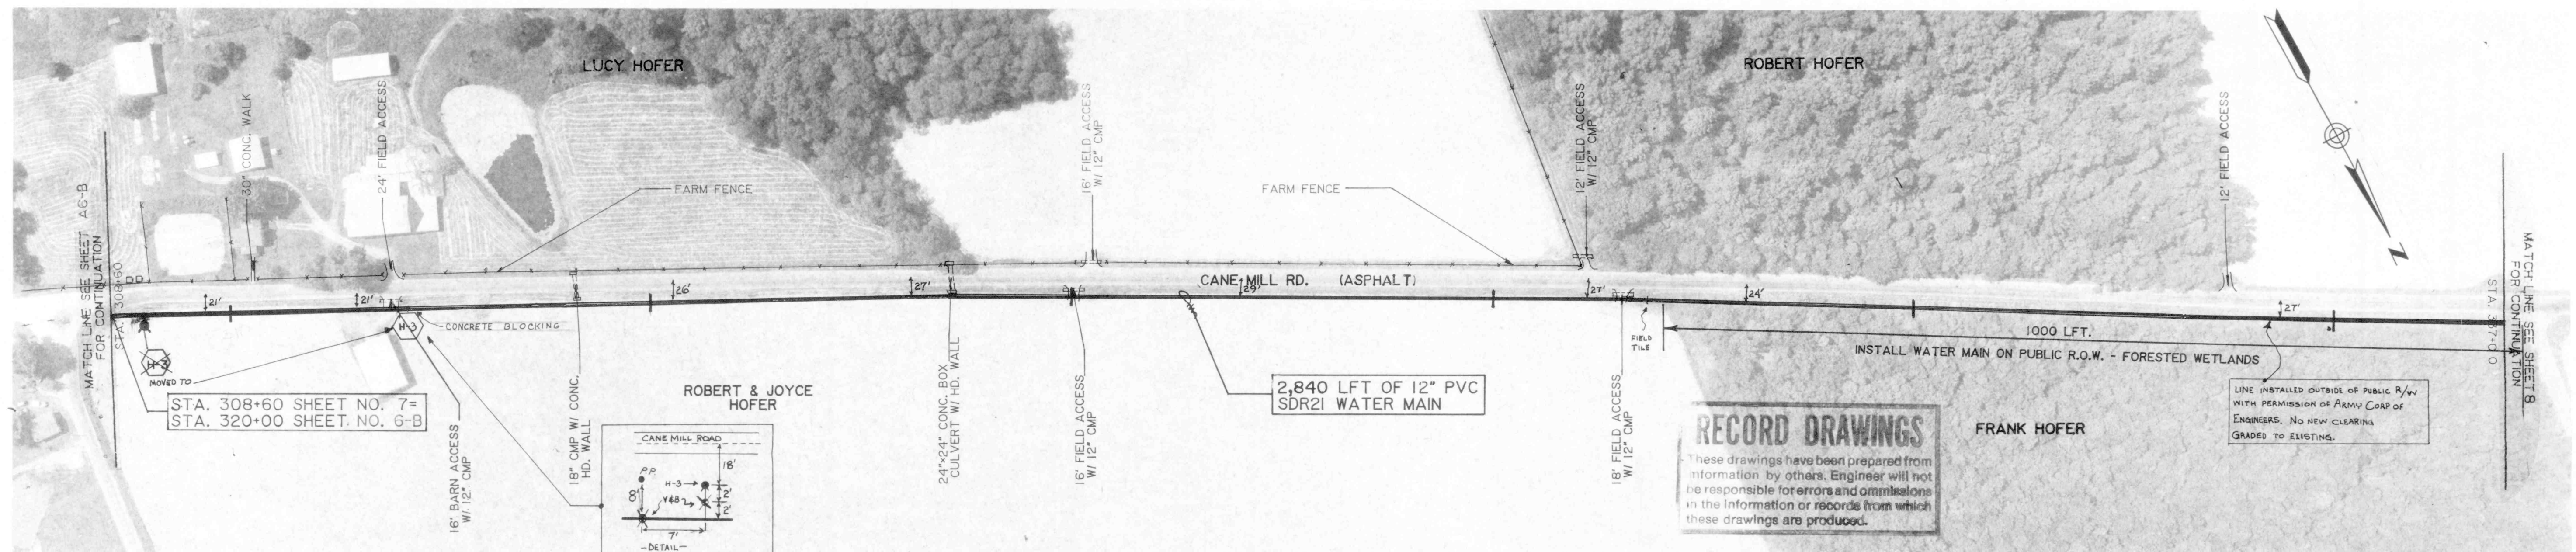

LINE A CANE MILL RD.

CONTRACT "A"
WATER MAINS
LINE "A"
ELROD WATER COMPANY, INC.
DIVISION "E"
WATERWORKS SYSTEM IMPROVEMENTS

M.D. WESSLER and ASSOCIATES
CONSULTING ENGINEERS
6219 South East Street, Suite A
Indianapolis, Indiana 46227-2148

SCALE: 1" = 100'
DATE: OCT. 14, 1993
PROJECT NO.: 37391.04
DRAWN BY: CLG
APPROVED BY: DGC

NOT PUBLISHED
ALL RIGHTS RESERVED
EXCEPT FOR USES EXPRESSLY PERMITTED IN WRITING, INFORMATION SHOWN OR INCLUDED IN THIS DOCUMENT IS SOLELY THE PROPERTY OF M.D. WESSLER & ASSOCIATES, INC.

DAVID G. CORT
REGISTERED PROFESSIONAL ENGINEER
NO. 13334
STATE OF INDIANA

David G. Cort

SHEET A7
OF 45