SEE SHEET NO. 602 FOR MORE DETAILS

CONC.

12" SDR-21 PVC

WATER MAIN -

CHARLES A. OR EDNA ECKSTEIN

10833 ST. NICHOLAS RD.

SUNMAN, IN 47041

DB. 141 PG. 402

(2 EA.) 12" RJDI

114 BENDS

12"x12"x12" RJDI TEE AND 12" GATE VALVE SPADES RD.

JOSEPHINE McCONNELL 10519 N SPADES RD

SUNMAN, IN 47041

DB. 215 PG. 680

-R/W-

-EXISTING 8"

CHARLES A. OR EDNA ECKSTEIN WATER MAIN 10833 ST. NICHOLAS RD.


SUNMAN, IN 47041

DB. 141 PG. 402

10594



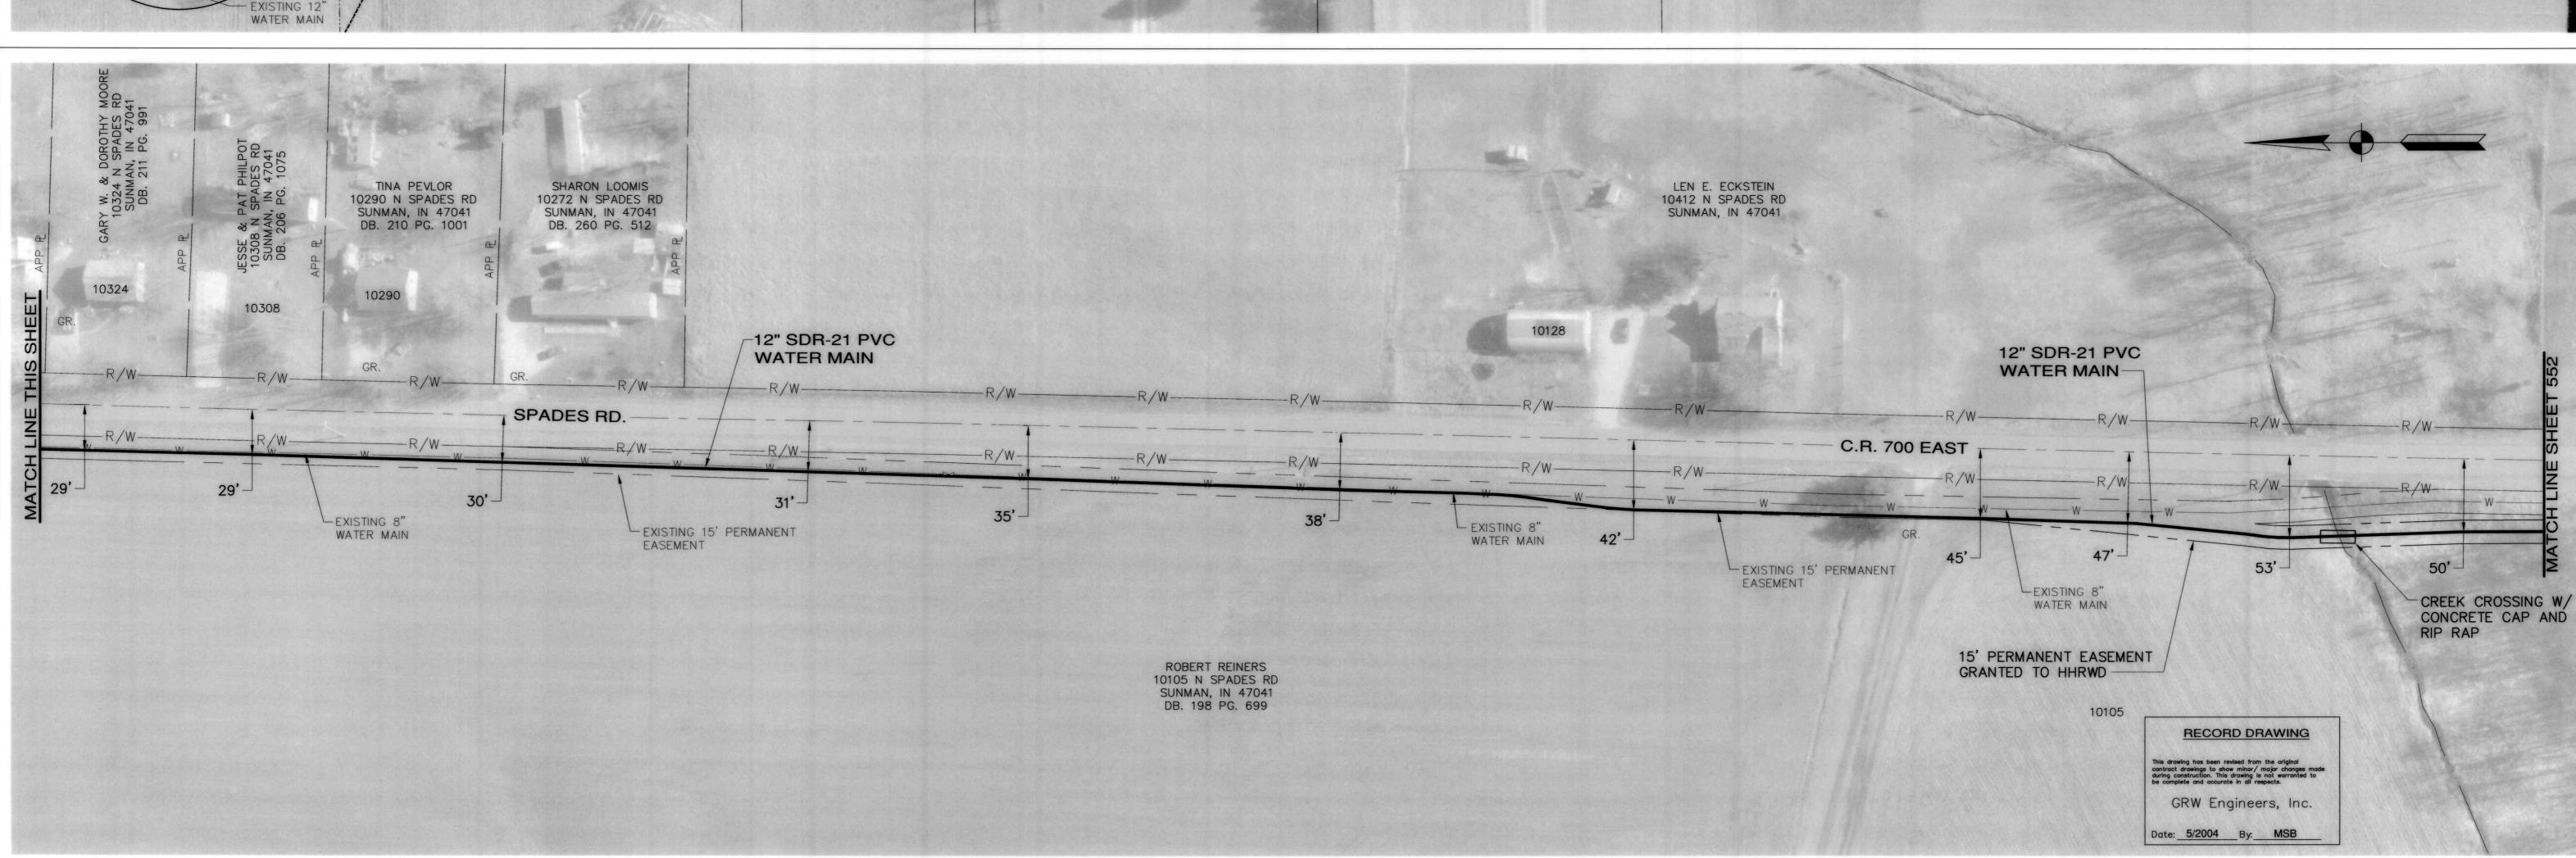

REVISIONS

-EXISTING 8"

WATER MAIN

RUTH BAKER

26008 GEORGETOWN RD

LOWLIG, IN DB. 200 PG. 48

GRW PROJECT NO. 2745-04

KENNETH F. & KAREN J. HOYNTZ

10542 N SPADES RD

SUNMAN, IN 47041 DB. 196 PG. 720

EXISTING 15' PERMANENT

MARIEL CLUSTERMAN

10483 N SPADES RD

SUNMAN, IN 47041

DB. 202 PG. 288

EASEMENT

LEN & MARCIA ECKSTEIN

10412 N SPADES RD

SUNMAN, IN 47041

EVERETT CLARK

59 DRYFORK RD

MADISON, IN 47250 DB. 211 PG. 938

10362

-12" SDR-21 PVC

WATER MAIN

C.R. 700 EAST

EASEMENT

EXISTING 15' PERMANENT

ROBERT REINERS

10105 N SPADES RD

SUNMAN, IN 47041

DB. 198 PG. 699

DENNIS M. DEE 10350 N SPADES RD

SUNMAN, IN 47041 DB. 234 PG. 897

-EXISTING 8"

DRAWN:

BJD

GRW Engineers, Inc.

Engineers, Architects, Planners

INDIANAPOLIS, INDIANA LOUISVILLE & LEXINGTON, KENTUCKY CINCINNATI, OHIO NASHVILLE, TENNESSEE ARLINGTON, TEXAS

★ 19300607 **★**

FILE NAME:

CHECKED:

APPROVED:

SHEET507.DWG

JULY 2002

SHEET NO.

SCALE:

1" = 50'

WATER MAIN

10330