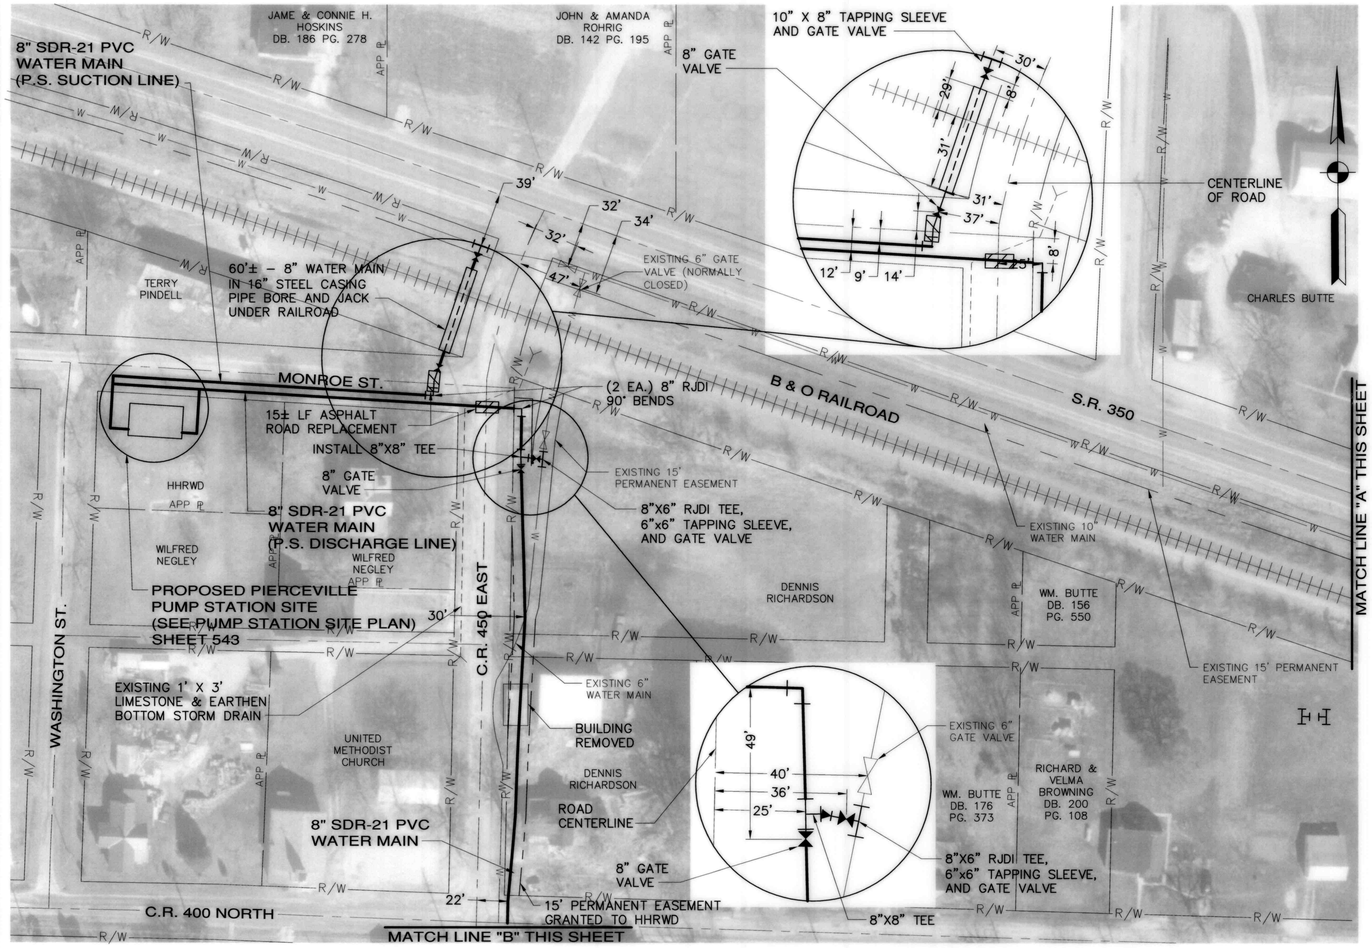


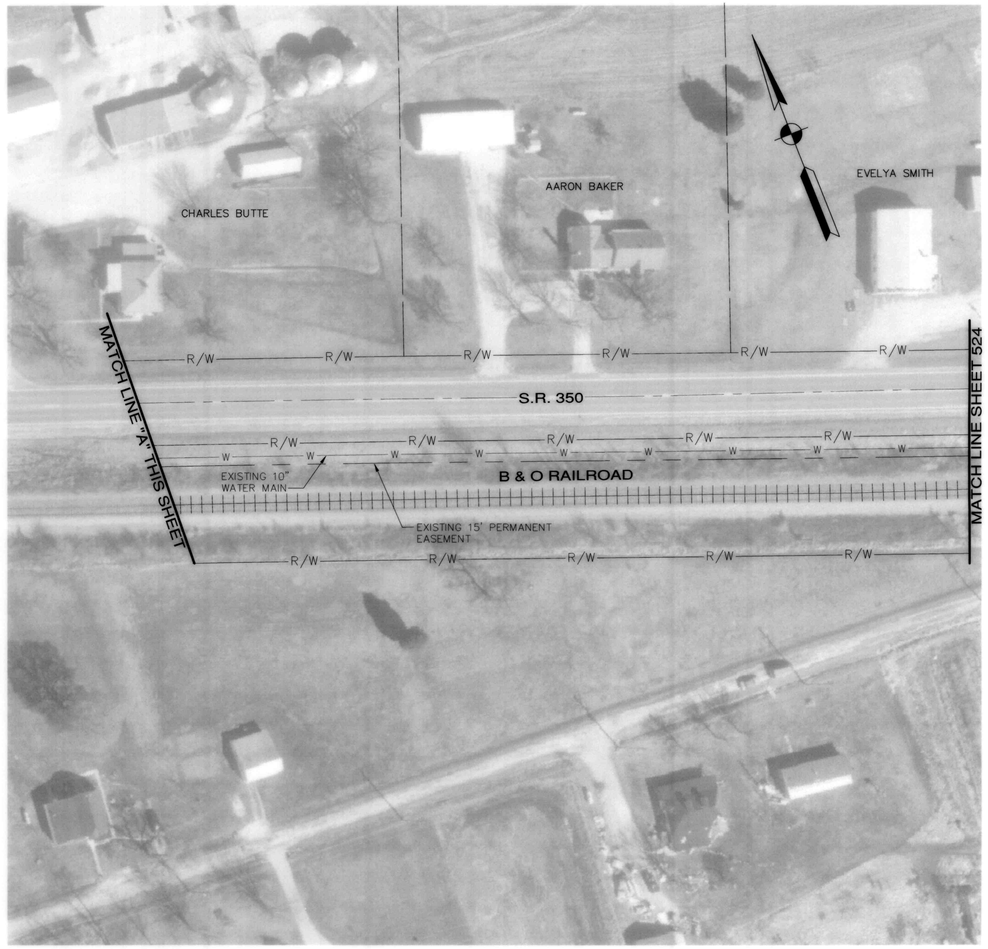


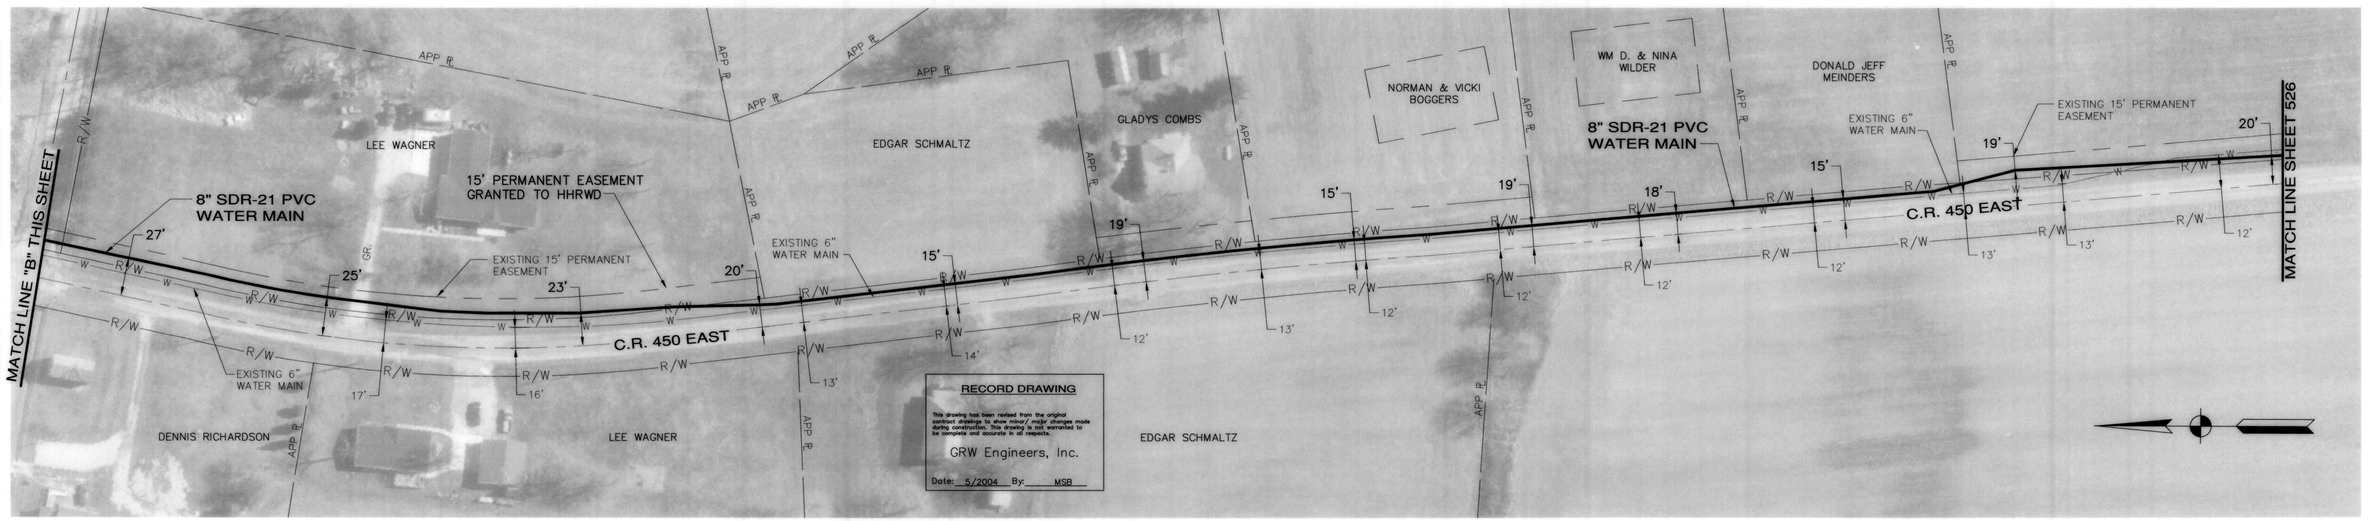


NOTES:

1). THE UTILITIES AND THEIR LOCATION SHOWN ON PLANS ARE APPROXIMATE. CONTRACTOR SHALL VERIFY ALL UTILITIES IN THE FIELD AND NOTIFY ALL UTILITY COMPANIES PRIOR TO INSTALLATION OF THE WATER LINE.
2). ALL PIPING SHALL BE CLASS 200 PVC UNLESS OTHERWISE NOTED.
3). 48" MINIMUM COVER REQUIRED OVER TOP OF WATER LINE.
4). THE LOCATION OF AIR RELEASE VALVES IS APPROXIMATE. VALVES SHALL BE LOCATED AND INSTALLED BY THE CONTRACTOR AT THE HIGH POINT ALONG THE WATER LINE.

| NO. | DESCRIPTION | DATE | BY |
|---|---|---|---|
| 1 | AS-BUILT REVISIONS | 5/2004 | MSB |

REVISIONS

# HOOSIER HILLS REGIONAL WATER DISTRICT

DIVISION "F" WATERWORKS SYSTEM IMPROVEMENTS
CONTRACT F-1
S.R 350 / C.R. 450 EAST

GRW PROJECT NO. 2745-04

GREGORY A. WRIGHT REGISTERED No. 19300607 STATE OF INDIANA PROFESSIONAL ENGINEER

GRW Engineers, Inc.
Engineers, Architects, Planners
INDIANAPOLIS, INDIANA
LOUISVILLE & LEXINGTON, KENTUCKY
CINCINNATI, OHIO
NASHVILLE, TENNESSEE
ARLINGTON, TEXAS

| | |
|---|---|
| DRAWN: BJD | DATE: JULY 2002 |
| FILE NAME: SHEET528.DWG | SCALE: 1" = 50' |
| CHECKED: | SHEET NO. 525 |
| APPROVED: | |

I:\2745\dwg\F-1\Record Dwgs\Sheet 525.dwg, 11/8/2004 9:27:05 AM