



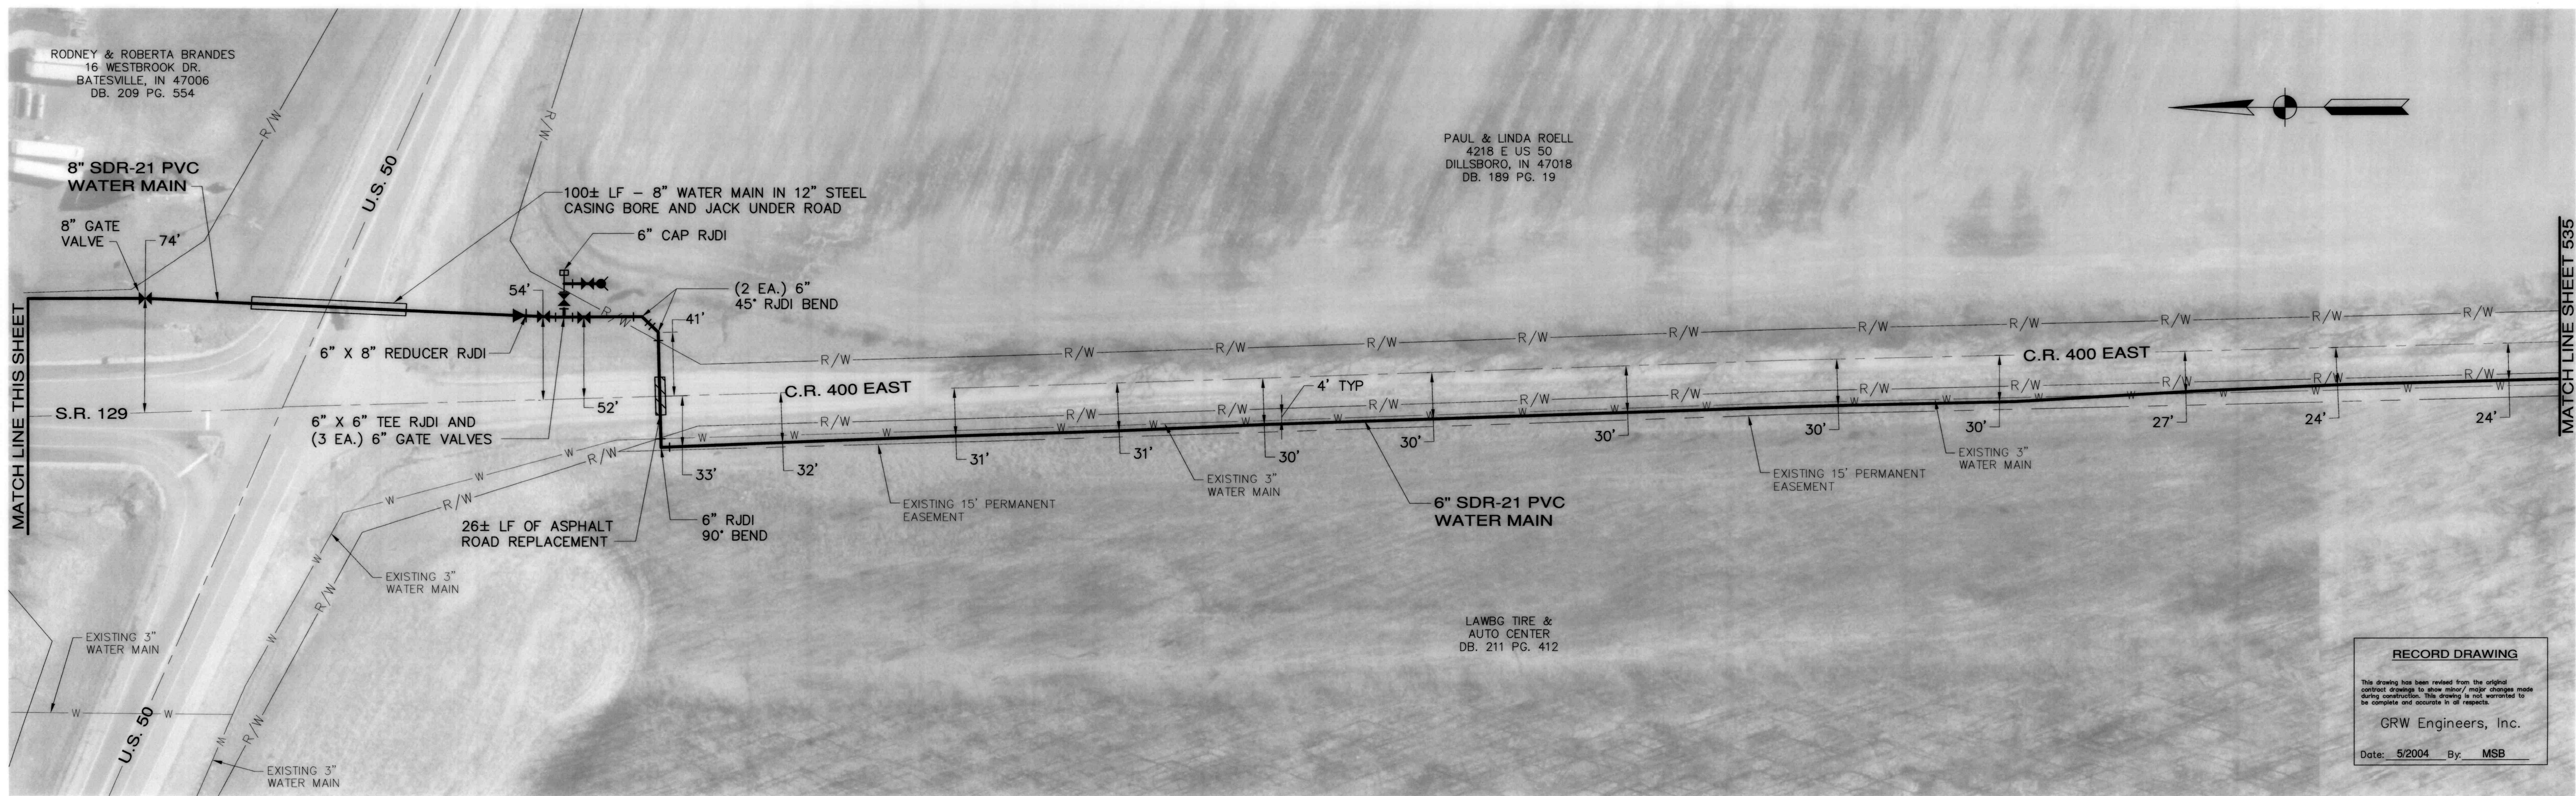

- NOTES:
- 1). THE UTILITIES AND THEIR LOCATION SHOWN ON PLANS ARE APPROXIMATE. CONTRACTOR SHALL VERIFY ALL UTILITIES IN THE FIELD AND NOTIFY ALL UTILITY COMPANIES PRIOR TO INSTALLATION OF THE WATER LINE.
 - 2). ALL PIPING SHALL BE CLASS 200 PVC UNLESS OTHERWISE NOTED.
 - 3). 48" MINIMUM COVER REQUIRED OVER TOP OF WATER LINE.
 - 4). THE LOCATION OF AIR RELEASE VALVES IS APPROXIMATE. VALVES SHALL BE LOCATED AND INSTALLED BY THE CONTRACTOR AT THE HIGH POINT ALONG THE WATER LINE.

NO.	DESCRIPTION	DATE	BY
1	AS-BUILT REVISION	5/2004	MSB
REVISIONS			

HOOSIER HILLS REGIONAL
WATER DISTRICT
DIVISION "F" WATERWORKS SYSTEM IMPROVEMENTS
CONTRACT F-1
S.R. 129 / C.R. 400 EAST
GRW PROJECT NO. 2745-04

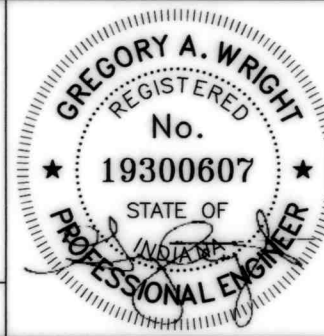

GRW
GRW Engineers, Inc.
Engineers, Architects, Planners
INDIANAPOLIS, INDIANA
LOUISVILLE & LEXINGTON, KENTUCKY
CINCINNATI, OHIO
NASHVILLE, TENNESSEE
ARLINGTON, TEXAS

DRAWN: BJD	DATE: JULY 2002
FILE NAME: SHEETS34.DWG	SCALE: 1" = 50'
CHECKED:	SHEET NO.
APPROVED:	534