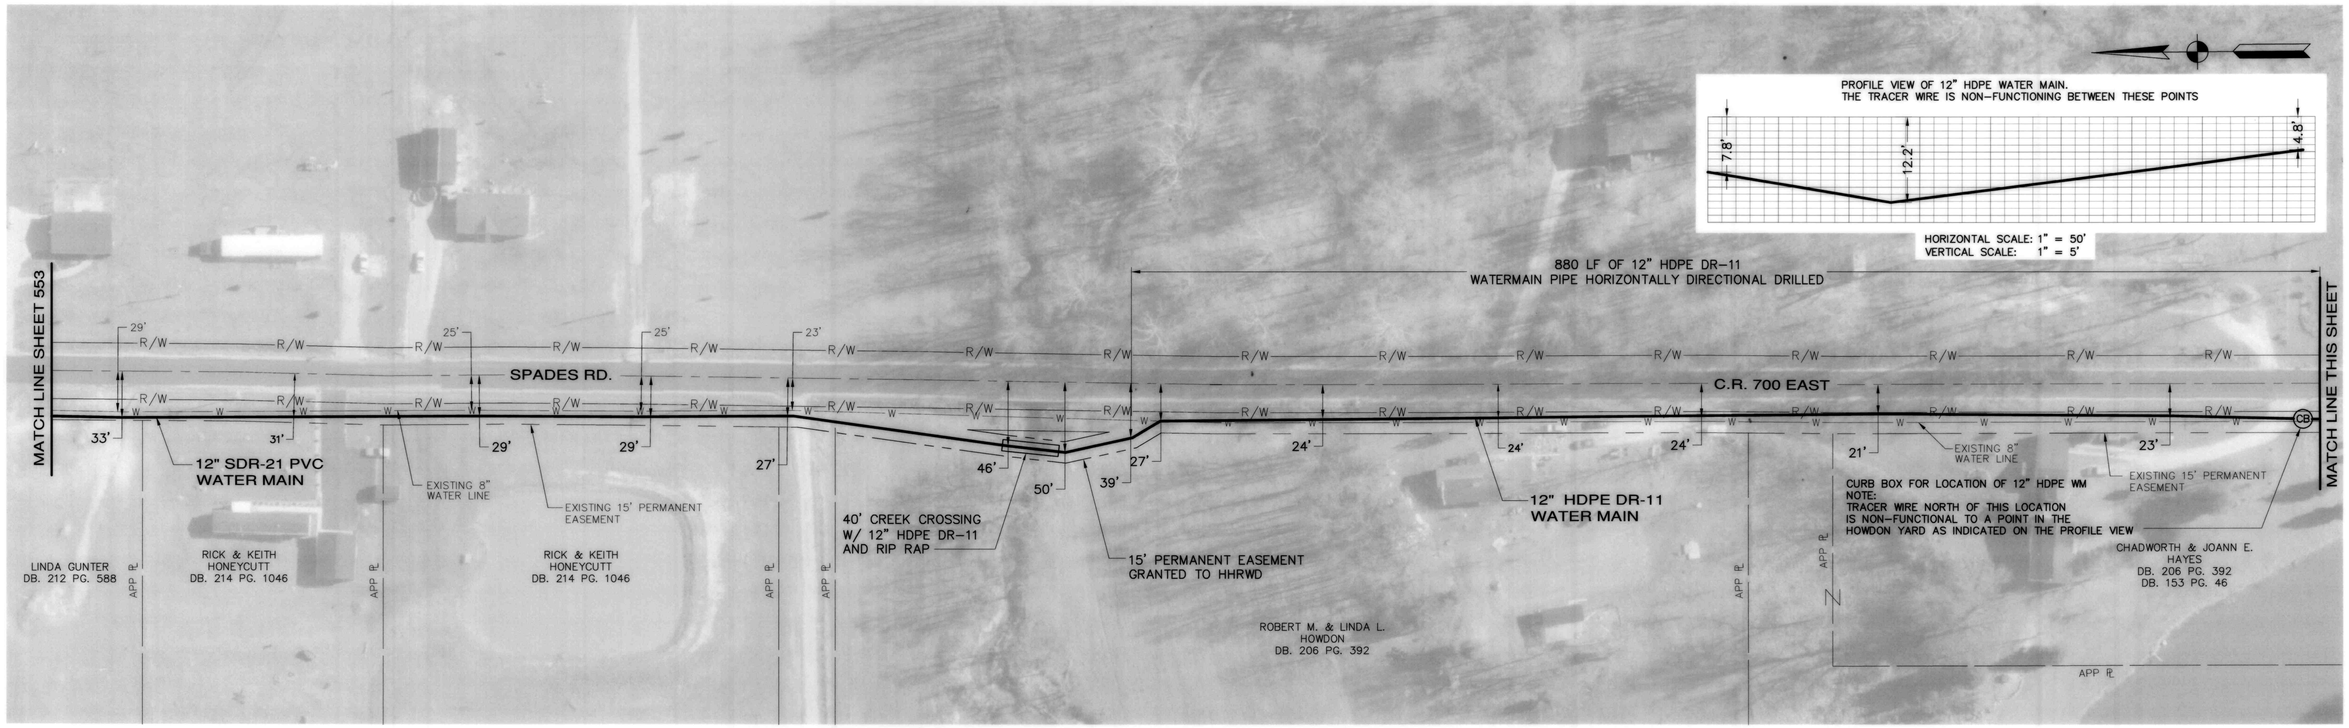

RECORD DRAWING

This drawing has been revised from the original contract drawings to show minor/ major changes made during construction. This drawing is not warranted to be complete and accurate in all respects.

GRW Engineers, Inc.

Date: 5/2004 By: MSB

NOTES:

1). THE UTILITIES AND THEIR LOCATION SHOWN ON PLANS ARE APPROXIMATE. CONTRACTOR SHALL VERIFY ALL UTILITIES IN THE FIELD AND NOTIFY ALL UTILITY COMPANES PRIOR TO INSTALLATION OF THE WATER LINE.
2). ALL PIPING SHALL BE CLASS 200 PVC UNLESS OTHERWISE NOTED.
3). 48" MINIMUM COVER REQUIRED OVER TOP OF WATER LINE.
4). THE LOCATION OF AIR RELEASE VALVES IS APPROXIMATE. VALVES SHALL BE LOCATED AND INSTALLED BY THE CONTRACTOR AT THE HIGH POINT ALONG THE WATER LINE.

NO.	DESCRIPTION	DATE	BY
1	AS-BUILT REVISIONS	5/2004	MSB

REVISIONS

HOOSIER HILLS REGIONAL WATER DISTRICT

DIVISION "F" WATERWORKS SYSTEM IMPROVEMENTS
CONTRACT F-1
C.R. 700 EAST (SPADES RD.)

GRW PROJECT NO. 2745-04

GREGORY A. WRIGHT REGISTERED No. 19300607 STATE OF INDIANA PROFESSIONAL ENGINEER

GRW Engineers, Inc.
Engineers, Architects, Planners
INDIANAPOLIS, INDIANA
LOUISVILLE & LEXINGTON, KENTUCKY
CINCINNATI, OHIO
NASHVILLE, TENNESSEE
ARLINGTON, TEXAS

DRAWN: GCR	DATE: JULY 2002
FILE NAME: SHEET554.DWG	SCALE: 1" = 50'
CHECKED:	SHEET NO. 554
APPROVED:	

I:\2745\dwg\F-1\Record Dwgs\Sheet 554.dwg, 11/8/2004 10:24:43 AM