
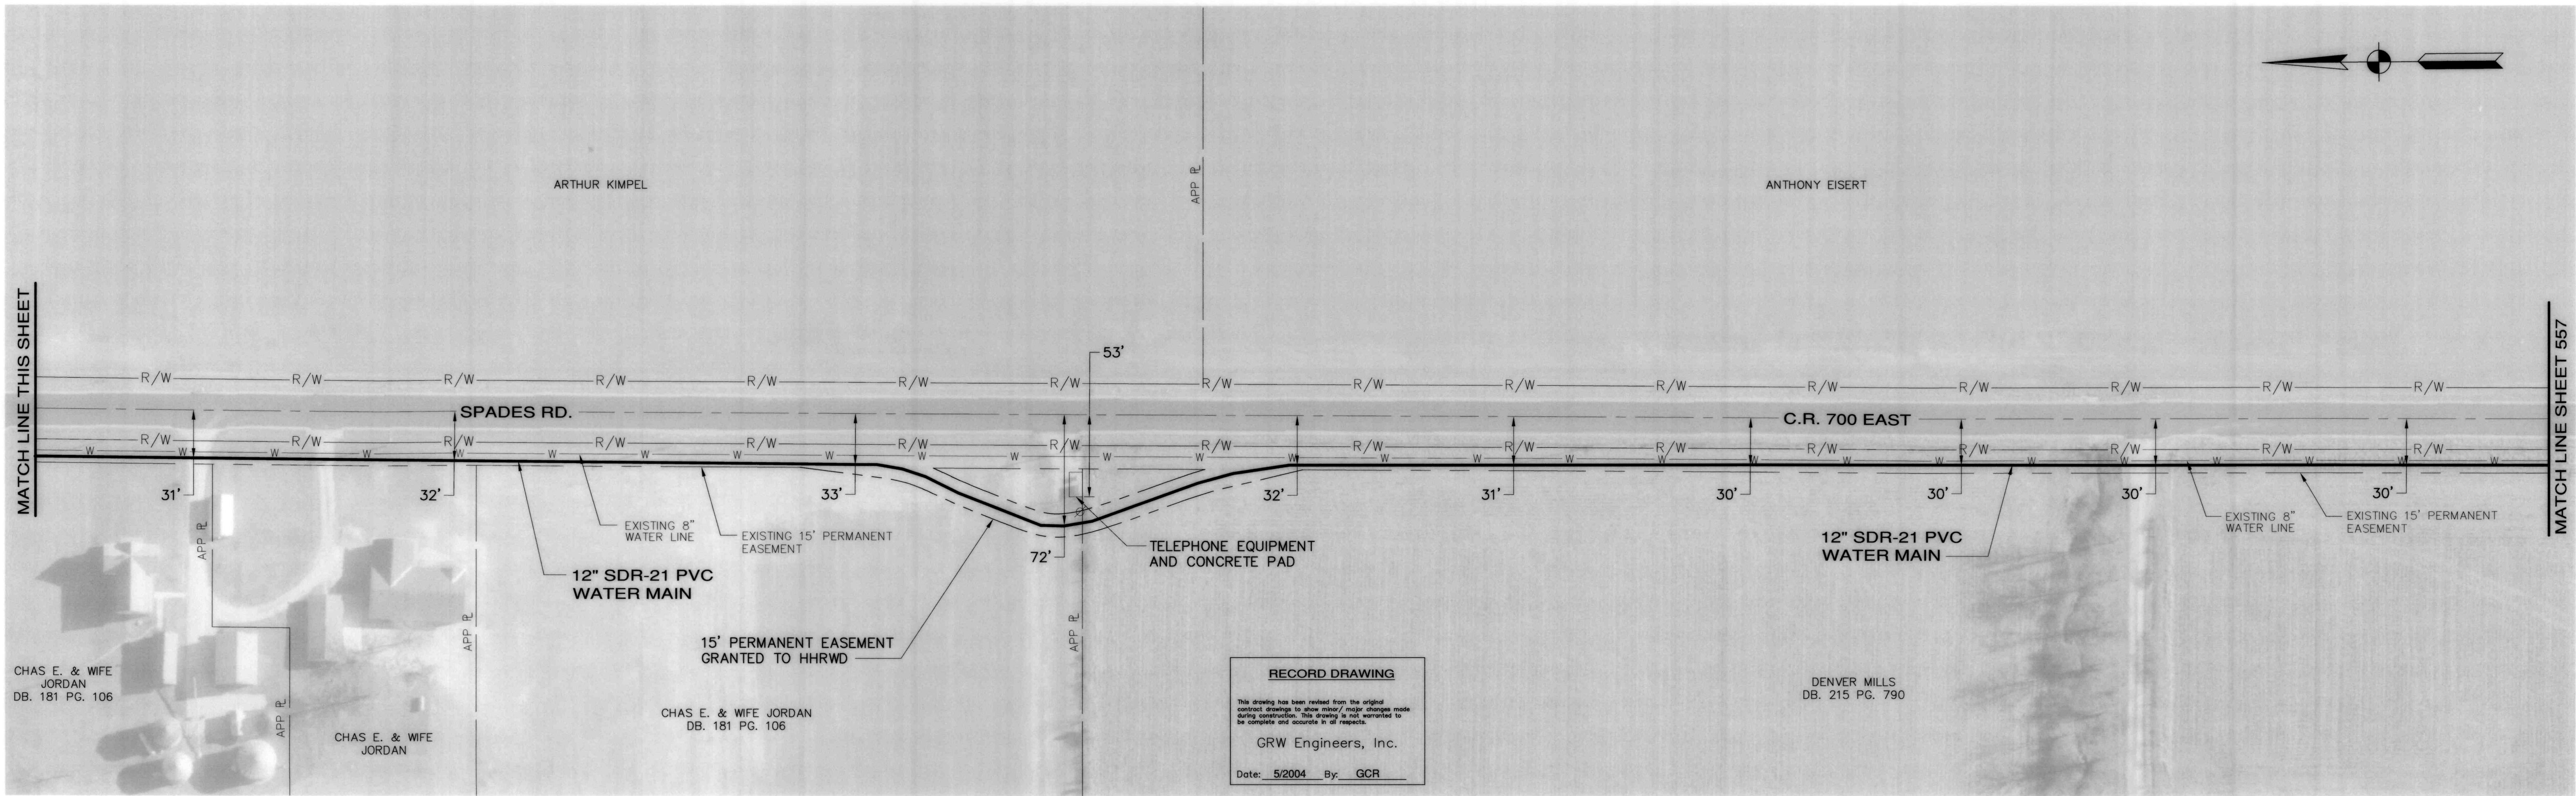


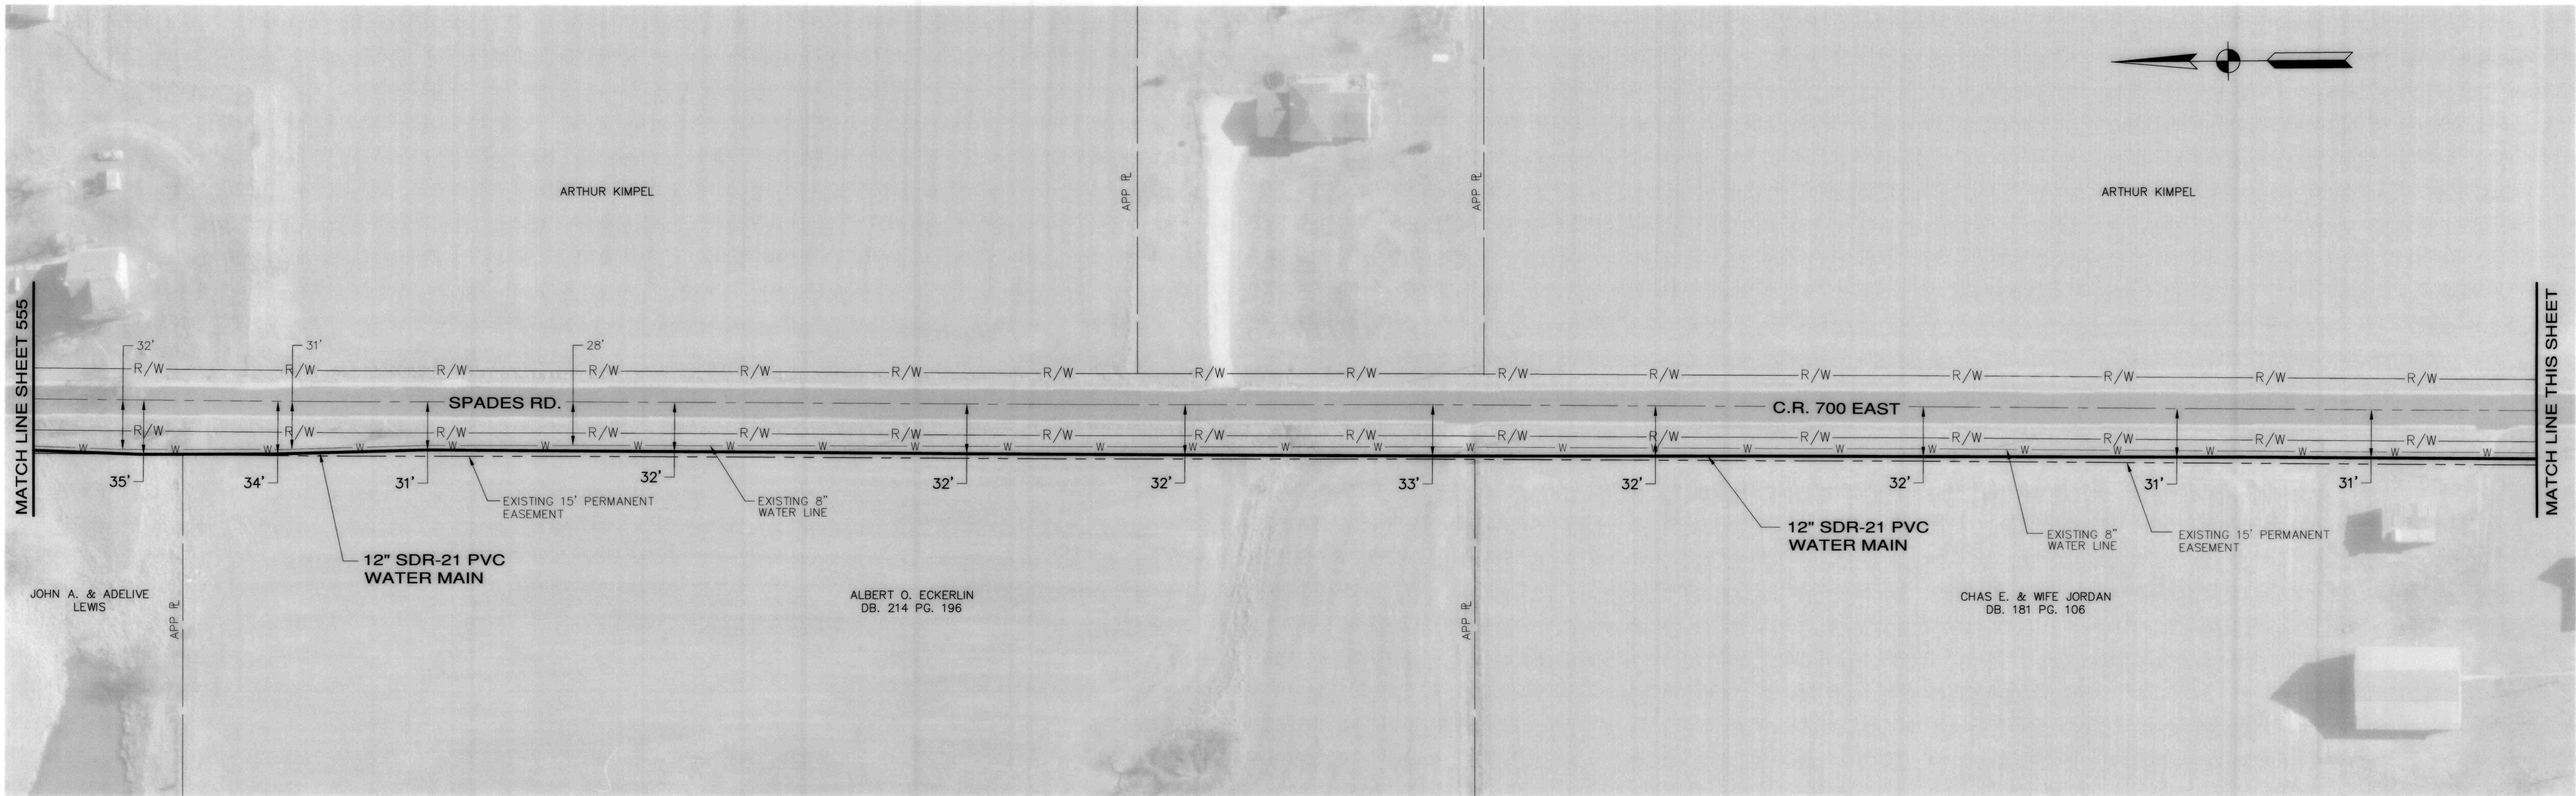

- NOTES:
- 1). THE UTILITIES AND THEIR LOCATION SHOWN ON PLANS ARE APPROXIMATE. CONTRACTOR SHALL VERIFY ALL UTILITIES IN THE FIELD AND NOTIFY ALL UTILITY COMPANIES PRIOR TO INSTALLATION OF THE WATER LINE.
  - 2). ALL PIPING SHALL BE CLASS 200 PVC UNLESS OTHERWISE NOTED.
  - 3). 48" MINIMUM COVER REQUIRED OVER TOP OF WATER LINE.
  - 4). THE LOCATION OF AIR RELEASE VALVES IS APPROXIMATE. VALVES SHALL BE LOCATED AND INSTALLED BY THE CONTRACTOR AT THE HIGH POINT ALONG THE WATER LINE.

| REVISIONS |                    |        |     |
|-----------|--------------------|--------|-----|
| NO.       | DESCRIPTION        | DATE   | BY  |
| 1         | AB-BUILT REVISIONS | 5/2004 | GCR |

HOOSIER HILLS REGIONAL  
WATER DISTRICT  
DIVISION "F" WATERWORKS SYSTEM IMPROVEMENTS  
CONTRACT F-1  
C.R. 700 EAST (SPADES RD.)

GRW PROJECT NO. 2745-04



**GRW Engineers, Inc.**  
Engineers, Architects, Planners  
INDIANAPOLIS, INDIANA  
LOUISVILLE & LEXINGTON, KENTUCKY  
CINCINNATI, OHIO  
NASHVILLE, TENNESSEE  
ARLINGTON, TEXAS

|                            |                    |
|----------------------------|--------------------|
| DRAWN:<br>GCR              | DATE:<br>JULY 2002 |
| FILE NAME:<br>SHEET556.DWG | SCALE:<br>1" = 50' |
| CHECKED:                   | SHEET NO.          |
| APPROVED:                  | 556                |