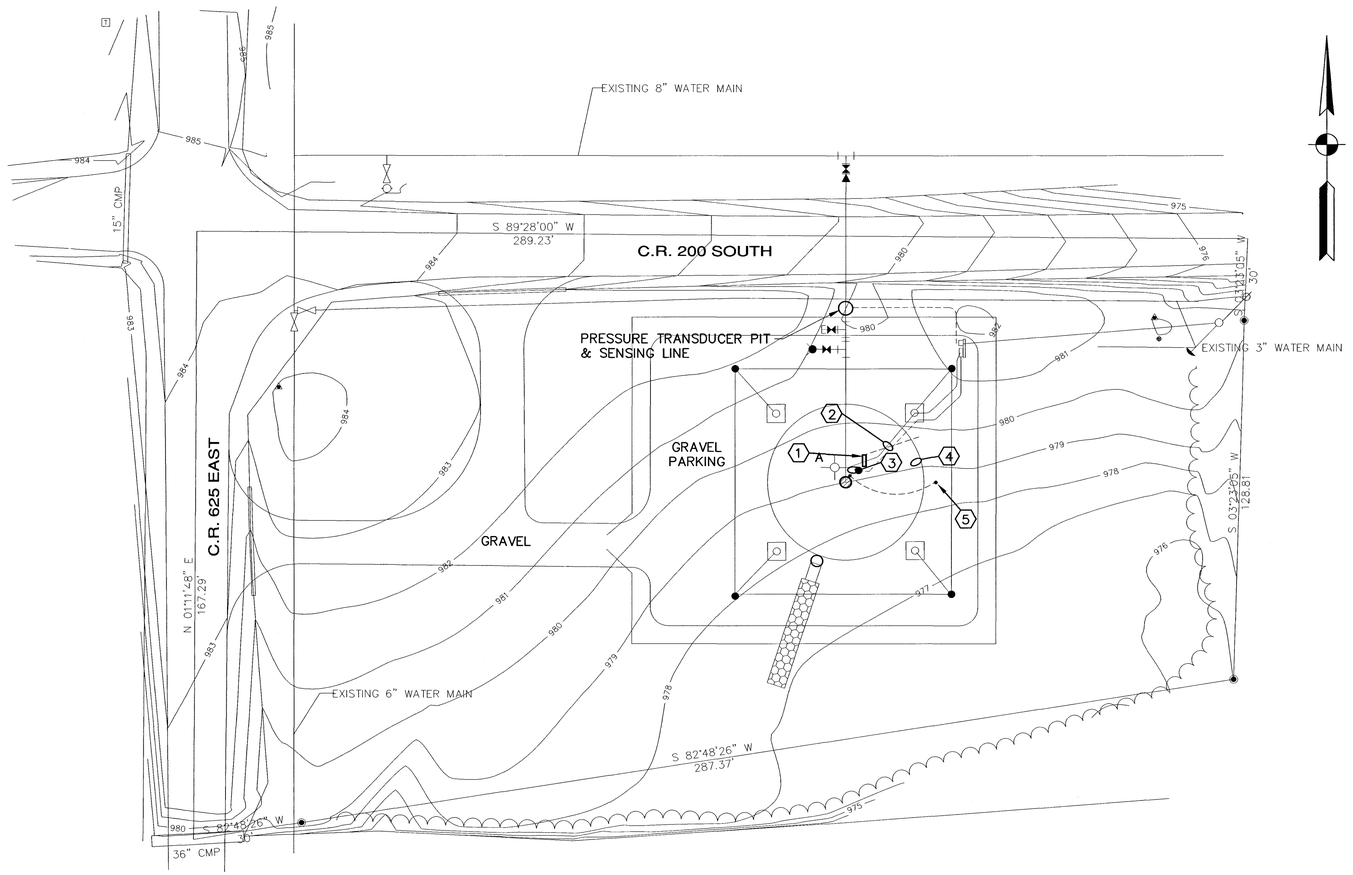

PLAN NOTES

1. I & C RTU PANEL (F-2 CONTRACT) MOUNTED TO EQUIPMENT RACK. OPPOSITE SIDE OF POWER EQUIPMENT(F3 CONTRACT).
2. 1" CONDUIT, UNDERGROUND, WITH 4-20MADC ANALOG INSTRUMENT CABLE FROM PRESURE TRANSMITTER. PRESSURE TRANSMITTER TO BE LOOP POWERED (F-2 CONTRACT).
3. 2" CONDUIT, UNDERGROUND, WITH RF ANTENNA CABLE (F-2 CONTRACT).
4. 2" GRS CONDUIT ON TANK STRUCTURE, WITH RF ANTENNA CABLE (F-2 CONTRACT).
5. RADIO TELEMETRY MAST AND ANTENNA AT TOP OF TANK STRUCTURE WITH LIGHTNING PROTECTION AERIAL AND DOWN-LINE TO STRUCTURAL STEEL (F-2 CONTRACT).

SOUTH MILAN TANK I AND C SITE PLAN

SCALE : 1"=20'

NOTES:

J. W. SIMS & ASSOCIATES
ENGINEERING COMPANY
1545 COUNTRY CLUB ROAD
INDIANAPOLIS, INDIANA 46234
(317) 209-4035 (FAX) 209-4038

NO.	DESCRIPTION	DATE	BY
1	AS-BUILT REVISION	5/2004	GCR

REVISIONS

HOOSIER HILLS REGIONAL WATER DISTRICT
DIVISION "F" WATERWORKS SYSTEM IMPROVEMENTS
CONTRACT F-2
BASE BID
SOUTH MILAN TANK I AND C SITE PLAN

GRW PROJECT NO. 2745 JWSA PROJECT NO. 2001-05

JOSEPH W. SIMS REGISTERED NO 860165 STATE OF INDIANA PROFESSIONAL ENGINEER

GRW Engineers, Inc.
Engineers, Architects, Planners
INDIANAPOLIS, INDIANA
LOUISVILLE & LEXINGTON, KENTUCKY
CINCINNATI, OHIO
NASHVILLE, TENNESSEE
ARLINGTON, TEXAS

DRAWN: JMS, JWS	DATE: NOVEMBER, 2001
FILE NAME: F2-E9_REVISED.DWG	SCALE: 1"=20'
CHECKED: JWS	SHEET NO. E9/590
APPROVED: JWS	

I:\2745\dwg\SIMS - IDEM Elec Submittal\FINAL SET NO-3 July 3, 2002 Set of Dwgs and Specs\FINAL F2 ELEC DWGS\F2As-Built_Drawings\F2-E9_REVISED.dwg, 11/15/2004 11:27:16 AM