- 2. CONTRACTOR SHALL BE RESPONSIBLE FOR INVESTIGATION WORK TO DETERMINE IF DEFLECTION OF THE WATER MAIN WILL BE REQUIRED TO GUARANTEE AN 18" MINIMUM VERTICAL SEPARATION OR A 10' MINIMUM HORIZONTAL SEPARATION BETWEEN STORM SEWER LINES, SANITARY SEWER LINES AND THE PROPOSED WATER MAIN. PRIOR TO ANY COMPROMISE OF THESE REQUIREMENTS, WRITTEN APPROVAL SHALL BE OBTAINED FROM THE ENGINEER AND OWNER
- ALL FITTINGS NOTED AN "RJDI" SHALL BE RESTRAINED JOINT DUCTILE IRON BENDS WITH RESTRAINED PIPE LENGTHS IDENTIFIED THIS SHEET. THOSE FITTINGS NOT NOTED AS "RJDI" SHALL EITHER BE RESTRAINED AS IDENTIFIED ON THIS SHEET OR BLOCKED WITH CONCRETE PER DETAILS SHEET.
- 4. TO MINIMIZE STRESS TO TREE SPECIMENS IN THE AREA OF CONSTRUCTION, THE WATER TRENCH SHOULD BE OPEN FOR A MINIMUM AMOUNT OF TIME AND THE ROOTS ON THE TRENCH SIDE OF THE TREE SHALL BE SEVERED IN A CLEAN CUT MANNER. THE CONTRACTOR SHALL MAKE EVERY EFFORT TO AVOID TOTAL REMOVAL OF TREES BY DEFLECTING PIPE IF POSSIBLE.
- 5. THE OWNER ASSUMES NO RESPONSIBILITY FOR THE LACK OF LOCATION OR MISSED LOCATION OF EXISTING UTILITIES. THE LOCATIONS, SIZES, AND INVERTS OF THE EXISTING UTILITIES SHOWN ON THESE PLANS ARE APPROXIMATE. THE CONTRACTOR SHALL NOTIFY ALL UTILITY COMPANIES AND VERIFY ALL UTILITIES IN THE FIELD PRIOR TO CONSTRUCTION. THE CONTRACTOR SHALL BE RESPONSIBLE FOR SCHEDULING UTILITY WORK, INCLUDING POLE RELOCATION, AS REQUIRED TO MEET THE PROJECT SCHEDULE.
- IT IS THE CONTRACTOR'S RESPONSIBILITY TO AVOID EXISTING UTILITIES AND PERFORM ANY REQUIRED REPAIRS. IN ADDITION TO ALL UTILITY LINES. THE CONTRACTOR SHALL BE RESPONSIBLE FOR ANY DAMAGE AND REPAIRS TO BURIED FIBER OPTIC CABLE, FIELD DRAINAGE TILES, AND PRIVATE IRRIGATION SYSTEMS. THE CONTRACTOR SHALL NOTIFY THE OWNER/ENGINEER WHEN UTILITIES OR OTHER SUBSURFACE LINES ARE DAMAGED. INDIANA UNDERGROUND UTILITIES PROTECTION SERVICE SHALL BE NOTIFIED AT LEAST 72 HOURS PRIOR TO BEGINNING ANY WORK. INDIANA UNDERGROUND UTILITIES PROTECTION SERVICE TELEPHONE IS 811. THE CONTRACTOR SHALL REFER TO APPLICABLE SECTIONS OF THE CONTRACT SPECIFICATIONS RELATIVE TO THE ABOVE.
- 7. CONTRACTOR SHALL NOTIFY RESPECTIVE UTILITY COMPANIES AT LEAST FOUR DAYS PRIOR TO INSTALLATION OF WATER MAIN. CONTRACTOR IS RESPONSIBLE FOR ALL COSTS INCURRED SUPPORTING POLES.
- CONTRACTOR SHALL CLEAN STREETS OF CONSTRUCTION DEBRIS DAILY TO THE SATISFACTION OF THE RIPLEY COUNTY ENGINEER, OWNER AND ENGINEER. CONTRACTOR SHALL FURTHER ENSURE THAT AT LEAST ONE LANE OF TRAFFIC SHALL BE OPEN AT ALL TIMES DURING CONSTRUCTION ALONG ROADWAYS UNLESS THE CONTRACTOR HAS WRITTEN APPROVAL AND AN APPROVED TRAFFIC MAINTENANCE PLAN FROM RIPLEY COUNTY. CONTRACTOR SHALL NOT AT ANY TIME CLOSE ANY LANE OF A STATE HIGHWAY.
- FULL DEPTH, COMPACTED GRANULAR BACKFILL SHALL BE REQUIRED PER HHRWD STANDARDS WHEN CENTERLINE OF WATER MAIN TRENCH IS WITHIN 5 FT. OF THE EDGE OF PAVEMENT FOR ROADWAYS ALONG THE WATER MAIN ROUTE.
- 10. CONTRACTOR SHALL REMOVE AND REPLACE ALL DRIVEWAY CULVERTS AFFECTED BY WATER MAIN CONSTRUCTION WITH NEW CMP DRIVEWAY CULVERT PIPING. CONTRACTOR SHALL ALSO PROVIDE STATE, CITY, AND/OR COUNTY APPROVED END SECTIONS ON EACH REPLACED CULVERT. THE CONTRACTOR SHALL OBTAIN THE ACTUAL INVERT ELEVATIONS OF EACH CULVERT TO BE REMOVED AND SUPPLY ELEVATION TO THE R.P.R. THE CONTRACTOR SHALL THEN PLACE THE NEW DRIVEWAY CULVERT AS CLOSE AS POSSIBLE TO THE FORMER INVERT ELEVATIONS AND PROVIDE POSITIVE DRAINAGE OF THE RECONSTRUCTED DITCH LINE.
- 11. THE OWNER HAS OBTAINED THE IDEM, RIPLEY COUNTY & IDNR PERMITS. THE CONTRACTOR IS RESPONSIBLE FOR ALL OTHER PERMITS NECESSARY TO COMPLETE THE PROJECT. INCLUDING ALL TRAFFIC CONTROL PERMITS.
- 12. THE DRAWINGS DEPICT SOME AREAS OF WATER MAIN INSTALLATION TO BE INSTALLED USING HDPE PIPE VIA DIRECTIONALLY DRILLING METHODS. THE OWNER & ENGINEER RESERVES THE RIGHT TO ADD OR SUBTRACT AREAS ALONG ALL WATER MAIN ROUTES TO HAVE THE WATER MAIN INSTALLED USING HDPE PIPE VIA DIRECTIONAL DRILLING METHODS. THESE AREAS MAY INCLUDE UNDER DRIVEWAYS, FRONT YARDS, UTILITY CONGESTION AREAS, CREEKS, ETC.
- 13. THE CONTRACTOR SHALL REVIEW THE EASEMENT CONDITIONS LIST ON FILE AT THE OWNER'S OFFICE AND ADHERE TO ANY & ALL CONDITIONS.
- 14. ALL EASEMENTS SHOWN ON THE DRAWINGS HAVE BEEN OR ARE IN THE PROCESS OF BEING ACQUIRED. ALL OTHER AREAS WHERE EASEMENTS ARE NOT SHOWN, THE OWNER IS ATTEMPTING TO ACQUIRE THOSE EASEMENTS. SHOULD THESE EASEMENTS BE OBTAINED PRIOR TO ACTUAL INSTALLATION, THE ENGINEER WILL DIRECT THE CONTRACTOR TO PLACE THE WATER MAIN ON THE EASEMENT. ALL PIPE AND FITTINGS WILL BE PAID FOR AS SET FORTH IN THE UNIT PRICE CONTRACT. NO ADDITIONAL PAYMENT FOR RE-LOCATION OF THE WATER MAIN WILL BE ALLOWED.
- 15. CONTRACTOR SHALL KEEP ALL EXISTING WATER MAINS IN SERVICE UNLESS NOTED ON PLANS.
- 16. FIRE HYDRANTS SHOWN ON PLANS ARE FOR GENERAL VICINITY INFORMATION ONLY. CONTRACTOR SHALL COORDINATE LOCATIONS WITH OWNER. CONTRACTOR SHALL INSTALL FITTINGS AS NECESSARY TO INSTALL FIRE HYDRANTS WITHIN EASEMENT OR RIGHT-OF-WAY AND AVOID EXISTING UTILITIES. ADDITIONAL FITTINGS SHALL BE CONSIDERED AS PART OF THE FIRE HYDRANT ASSEMBLY.

EXISTING I FGEND

	(10 : 11	13 2232112			
	EXISTING	BENCHMARK	T	EXISTING	TELEPHONE MANHOL
	EXISTING	CATCH BASIN		EXISTING	PKNAIL FOUND
C	EXISTING	CABLE BOX		EXISTING	PINE TREE
	EXISTING	CONTROL POINT	Ø	EXISTING	POWER POLE
\triangle	EXISTING	SECTION CORNER	· •/•	EXISTING	RAILROAD FLASHER
\odot	EXISTING	DECIDUOUS TREE	\triangle	EXISTING	RAILROAD GATE
E	EXISTING	ELECTRICAL BOX	\odot	EXISTING	SHRUB
EM	EXISTING	ELECTRIC METER		EXISTING	TEMP BENCHMARK
ET	EXISTING	ELECTRIC TRANSFORMER	T	EXISTING	TELEPHONE BOX
\bigvee	EXISTING	FIRE HYDRANT	\bigcirc	EXISTING	TELEPHONE MARKER
•	EXISTING	FLAG POLE	Ø	EXISTING	TRAFFIC POLE
FO	EXISTING	FIBER OPTIC BOX	\bigcirc	EXISTING	VALVE VAULT
GM	EXISTING	GAS METER	M	EXISTING	WATER METER
Ĝ	EXISTING	GAS MARKER	\bowtie	EXISTING	WATER VALVE
\bigcirc	EXISTING	GAS PRESSURE VALVE	MH	EXISTING	MANHOLE
(S)	EXISTING	GAS STOP	E	EXISTING	ELECTRIC MANHOLE
G	EXISTING	GAS VALVE	FD	EXISTING	FIBER OPTIC MANHO
—(EXISTING	GUY WIRE	(22)	EXISTING	SANITARY MANHOLE
\bigoplus	EXISTING	GRAVE STONE	(MZ)	EXISTING	STEAM MANHOLE
**	EXISTING	LIGHT POLE	\bigcirc	EXISTING	STORM MANHOLE
M	EXISTING	MAILBOX	DI	DUCTILE	IRON
	-ROAD Q		RJDI	RESTRAIN	ED JOINT DUCTILE IR
	- EXISTING	DITCH	R/W	EXISTING	RIGHT-OF-WAY
——E——	- EXISTING	POWER/ELECTRIC		EXISTING	SANITARY SEWER
X	- EXISTING	FENCE		EXISTING	STORM SEWER
——— G ———	- EXISTING	NATURAL GAS	ctv	EXISTING	CABLE TV
T T T	- EXISTING	GUARDRAIL —	— т ——	EXISTING	TELEPHONE LINE
	- EXISTING	GRADE (PROFILE) —	FD	EXISTING	FIBER OPTIC LINE
	- EXISTING	PROPERTY LINE —	W	EXISTING	WATER SERVICE
+++++++	- EXISTING	RAILROAD —		EXISTING	WATER'S EDGE

	PRO	POSED	LEGEND		ı
ELEPHONE MANHOLE		PROPOSED	SANITARY MANHOLE		
KNAIL FOUND		PROPOSED	CURB INLET	NO.	
INE TREE		PROPOSED	STORM MANHOLE		
OWER POLE	\vdash	PROPOSED	11° BEND		COVERS
AILROAD FLASHER	$ \leftarrow $	PROPOSED	22° BEND	G-01 G-02	GENERA SPADES
AILROAD GATE	\checkmark	PROPOSED	45° BEND	G-02	SPADES
HRUB	႕	PROPOSED	90° BEND	795	SPADES
EMP BENCHMARK	٦	PROPOSED	CAP	796	E. C.R. 1
ELEPHONE BOX		PROPOSED (2 ACCESS	FIRE HYDRANT	797	E. C.R. 1
ELEPHONE MARKER	ഥ	PROPOSED	TEE	C-01	STANDA
RAFFIC POLE	 	PROPOSED	VERTICAL TEE	C-02	EROSIO
ALVE VAULT	H	PROPOSED	WATER VALVE		
ATER METER		PROPOSED	REDUCER		
ATER VALVE		- PROPOSED	DITCH		
ANHOLE		- PROPOSED	RIGHT-OF-WAY	ELEC	TRIC
LECTRIC MANHOLE		- TEMPORAR	Y EASEMENT	VECTREN ENERG ONE VECTREN SC P.O. BOX 209 EVANSVILLE, IN 47 (800) 382-5544	
IBER OPTIC MANHOLE		– PERMANEN	T EASEMENT		
ANITARY MANHOLE		- CONSTRUC	TION LIMITS		

PROPOSED SANITARY SEWER

SURFACE RESTORATION

GRANULAR BACKFILL

FLOWABLE BACKFILL

BORE AND JACK

DIRECTIONAL DRILL

PROPOSED STORM SEWER

INDEX OF DRAWINGS					
NO.	DESCRIPTION				
GENERAL					
	COVER SHEET				
G-01	GENERAL NOTES AND INDEX OF DRAWINGS				
G-02	SPADES ROAD DRAWING INDEX				
CIVIL					
795	SPADES ROAD & E. C.R. 1100 N LINE "W-1" B.O.P. STA. 0+00 TO STA. 24+00				
796	E. C.R. 1100 N LINE "W-1" STA. 24+00 TO STA. 54+00				
797	E. C.R. 1100 N LINE "W-1" STA. 54+00 TO E.O.P. STA. 76+12				
C-01	STANDARD DETAILS				
C-02	EROSION CONTROL DETAILS				

UTILITIES

QUARE 47702-0209

WATER HOOSIER HILLS REGIONAL WATER DISTRICT (812) 954-3200

CABLE TELEVISION QWEST COMMUNICATION

INSIGHT COMMUNICATION P.O.BOX 619 MONTICELLO, IN. 47960 CONTACT: JACK PARKER (574) 583-8430

(800) 530-1050

(800) 382-5544

ENTERPRISE PRODUCTS

FIBER OPTIC


ENHANCED TELECOMMUNICATIONS (877) 207-5070

TELEPHONE

CONTRACTOR TO VERIFY

RESTRAINED JOINT NOTES

- CONTRACTOR SHALL INSTALL RJDI FITTINGS FOR ALL HORIZONTAL AND VERTICAL BENDS. CONCRETE THRUST BLOCKING IS STRICTLY PROHIBITED. UNLESS OTHERWISE NOTED.
- 2. RESTRAINED LENGTHS SHALL BE CALCULATED USING THE MOST CURRENT VERSION OF EBAA IRON - RESTRAINT LENGTH CALCULATOR, ASSUMING 4' DEPTH OF BURY, A 2.0 FACTOR OF SAFETY, TYPE 3 TRENCH CONDITIONS, "CL" SOIL CLASSIFICATION, 150 PSI HYDROSTATIC TEST PRESSURES.
- 3. ALL WATER MAIN AND APPURTENANCES WITHIN RJDI LIMITS MUST BE RESTRAINED AT EACH JOINT. AT MINIMUM THE NEXT JOINT EACH WAY FROM A FITTING SHALL BE RESTRAINED. VALVES SHALL BE CONSIDERED DEAD ENDS AND SHALL BE RESTRAINED EACH WAY.
- 4. RESTRAINT LENGTHS FOR R.J.D.I. FITTINGS SHALL BE SUBMITTED WITH WATER MAIN PIPE SHOP DRAWINGS.

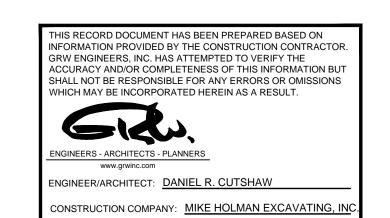

DATE: FEBRUARY 2014



Indiana Underground Plant Protection Service CALL TWO WORKING DAYS

BEFORE YOU DIG

IT'S THE LAW

issued, sealed, and signed by Daniel R. Cutshaw, Indiana Professional Engineer, No. 11200431, a April 15, 2013, shall not be used in lieu of a certified document.

This document, originally

IN IMPROVEME DISTRICT NOTE D. RE ENE R vi lín 、

G-6 - SPAI HOOSIER I

APRIL 2013

N.T.S.