


PRINTED: 11/17/2014 @ 4:21PM

FILE NAME: Y:\3916-HRRWD-Div-HRWorking Drawings\Civil\3DH-31916-773.dwg

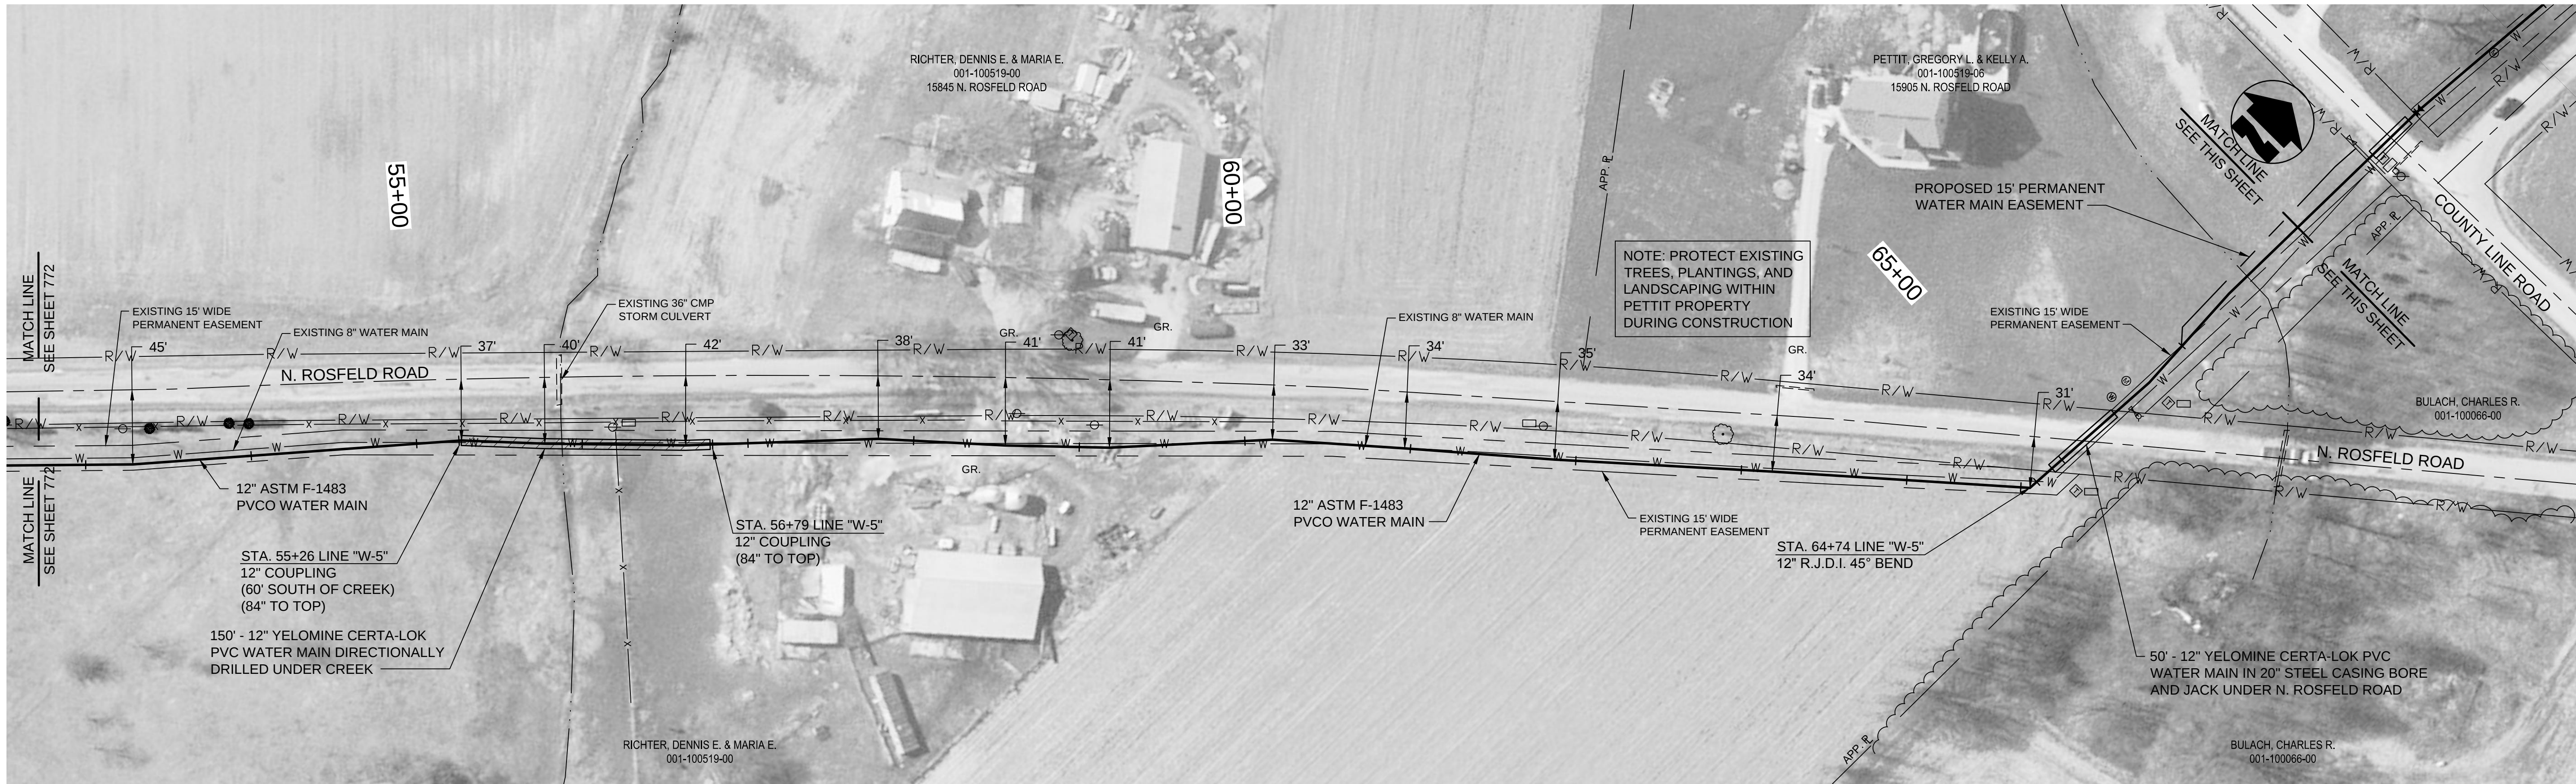

PLAN VIEW - STA. 53+00 TO STA. 67+00 LINE "W-5"




PLAN VIEW - STA. 67+00 TO STA. 82+00 LINE "W-5"

NOTES:

1. THE UTILITIES AND THEIR LOCATION SHOWN ON PLANS ARE APPROXIMATE. CONTRACTOR SHALL VERIFY ALL UTILITIES IN THE FIELD AND NOTIFY ALL UTILITY COMPANIES PRIOR TO INSTALLATION OF THE WATER LINE.
2. ALL PIPING SHALL BE CLASS 200 UNLESS OTHERWISE NOTED.
3. 48" MINIMUM COVER REQUIRED OVER TOP OF WATER LINE UNLESS OTHERWISE NOTED.

THIS RECORD DOCUMENT HAS BEEN PREPARED BASED ON INFORMATION PROVIDED BY THE CONSTRUCTION CONTRACTOR. GRW ENGINEERS, INC. HAS ATTEMPTED TO VERIFY THE ACCURACY AND/OR COMPLETENESS OF THIS INFORMATION BUT SHALL NOT BE RESPONSIBLE FOR ANY ERRORS OR OMISSIONS WHICH MAY BE INCORPORATED HEREIN AS A RESULT.	
	
ENGINEERS - ARCHITECTS - PLANNERS www.grwinc.com	
ENGINEER/ARCHITECT: CRAIG FARRELL	
CONSTRUCTION COMPANY: MIKE HOLMAN EXC., INC.	
DATE: 9/2014	

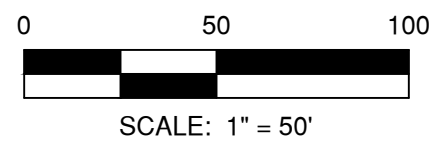

This document, originally issued, sealed, and signed by Daniel R. Cutshaw, Indiana Professional Engineer, No. 11200431, on April 15, 2013, shall not be used in lieu of a certified document.

GRW PROJECT NO. 3916-01

CLIENT PROJECT NO. H-3

ALL RIGHTS RESERVED. NO PART OF THIS DOCUMENT SHALL BE REPRODUCED IN WHOLE OR IN PART BY ANY MEANS, ELECTRONIC OR MECHANICAL, INCLUDING PHOTOCOPYING, RECORDING, OR BY ANY INFORMATION STORAGE AND RETRIEVAL SYSTEM, WITHOUT THE WRITTEN PERMISSION OF GRW ENGINEERS, INC.



ROSFELD ROAD & HORSESHOE BEND ROAD
CONTRACT H-3 - HORSESHOE BEND AREA
DIVISION H - WATERWORKS SYSTEM IMPROVEMENTS
HOOSIER HILLS REGIONAL WATER DISTRICT
RIPLEY AND FRANKLIN COUNTIES, INDIANA

NO.	REVISIONS DESCRIPTION	DATE	BY	DESIGNED	DRAWN	REVIEWED	APPROVED	SCALE CHECK
				ALW	JAJ	CJF	DRC	
1.	AS-BUILT REVISION	9/2014	JEC					THIS MARK SHOULD MEASURE EXACTLY 1" WHEN PLOTTED

DATE: APRIL 2013

SCALE:

1"=50'

SHEET NO.