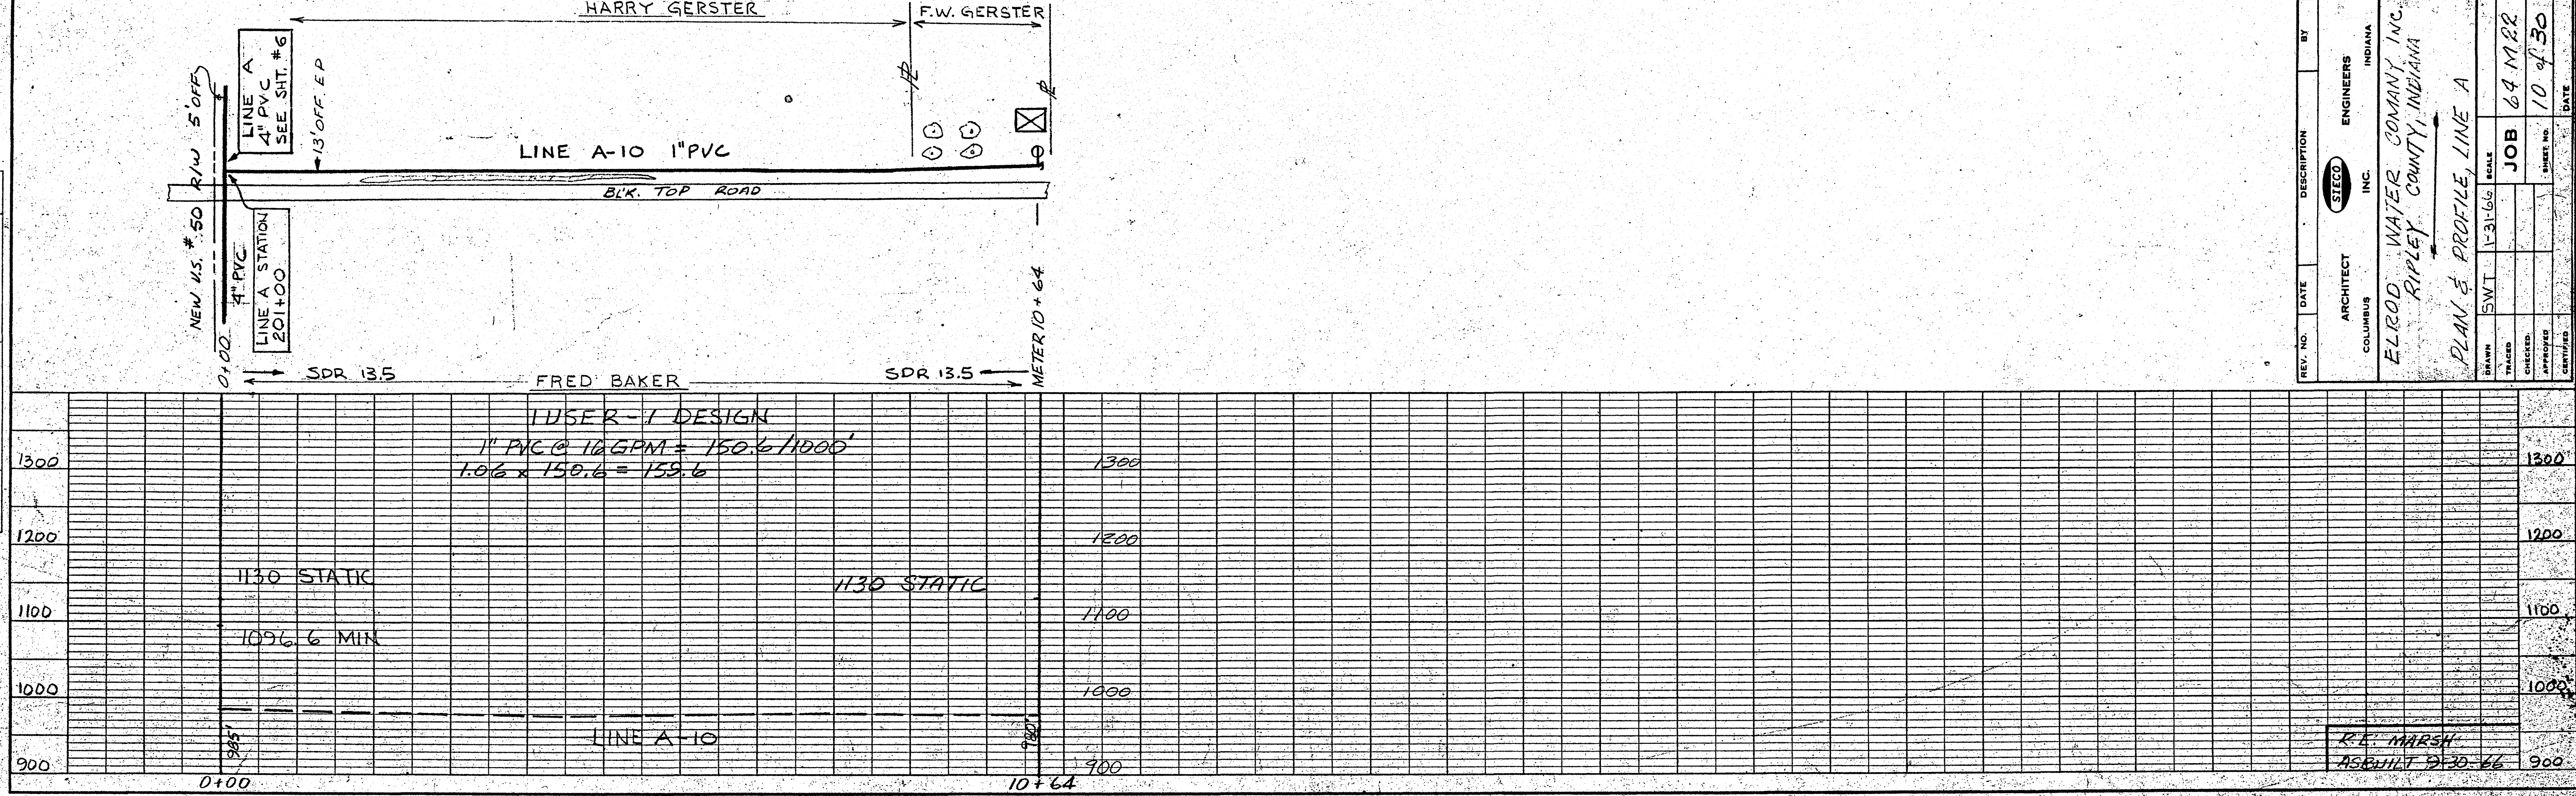


PROFILE		BY	DATE
NOTE BOOK	SURVEYED		
	PLOTTED		
	GRADES CHECKED		
	B. M.'S NOTED		
NO.	STRUCTURE NOTATIONS CHECKED		

[illegible]