
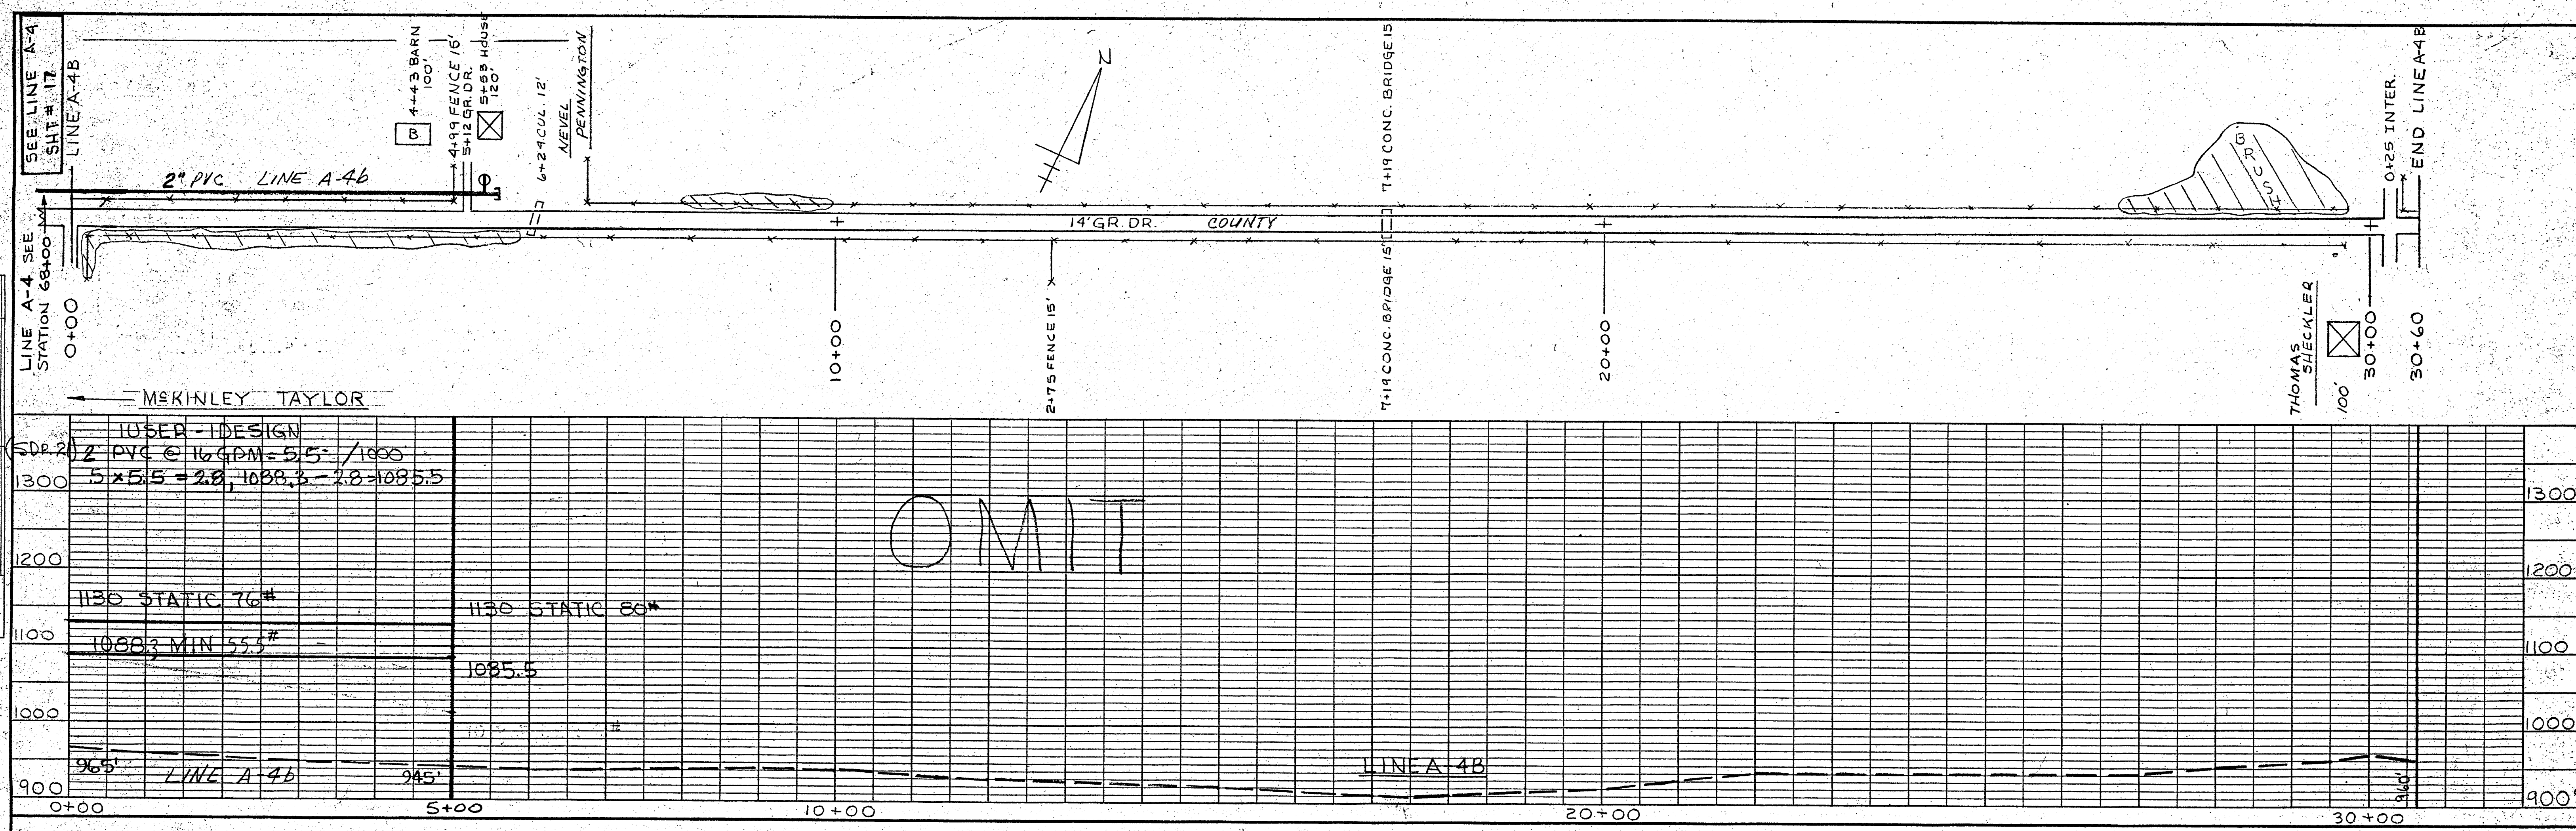


PROFILE	DATE	BY
NO.		
NOTE BOOK		
STRUCTURE NOTATION		

PLAN	DATE	BY
NO.		
NOTE BOOK		
STRUCTURE NOTATION		

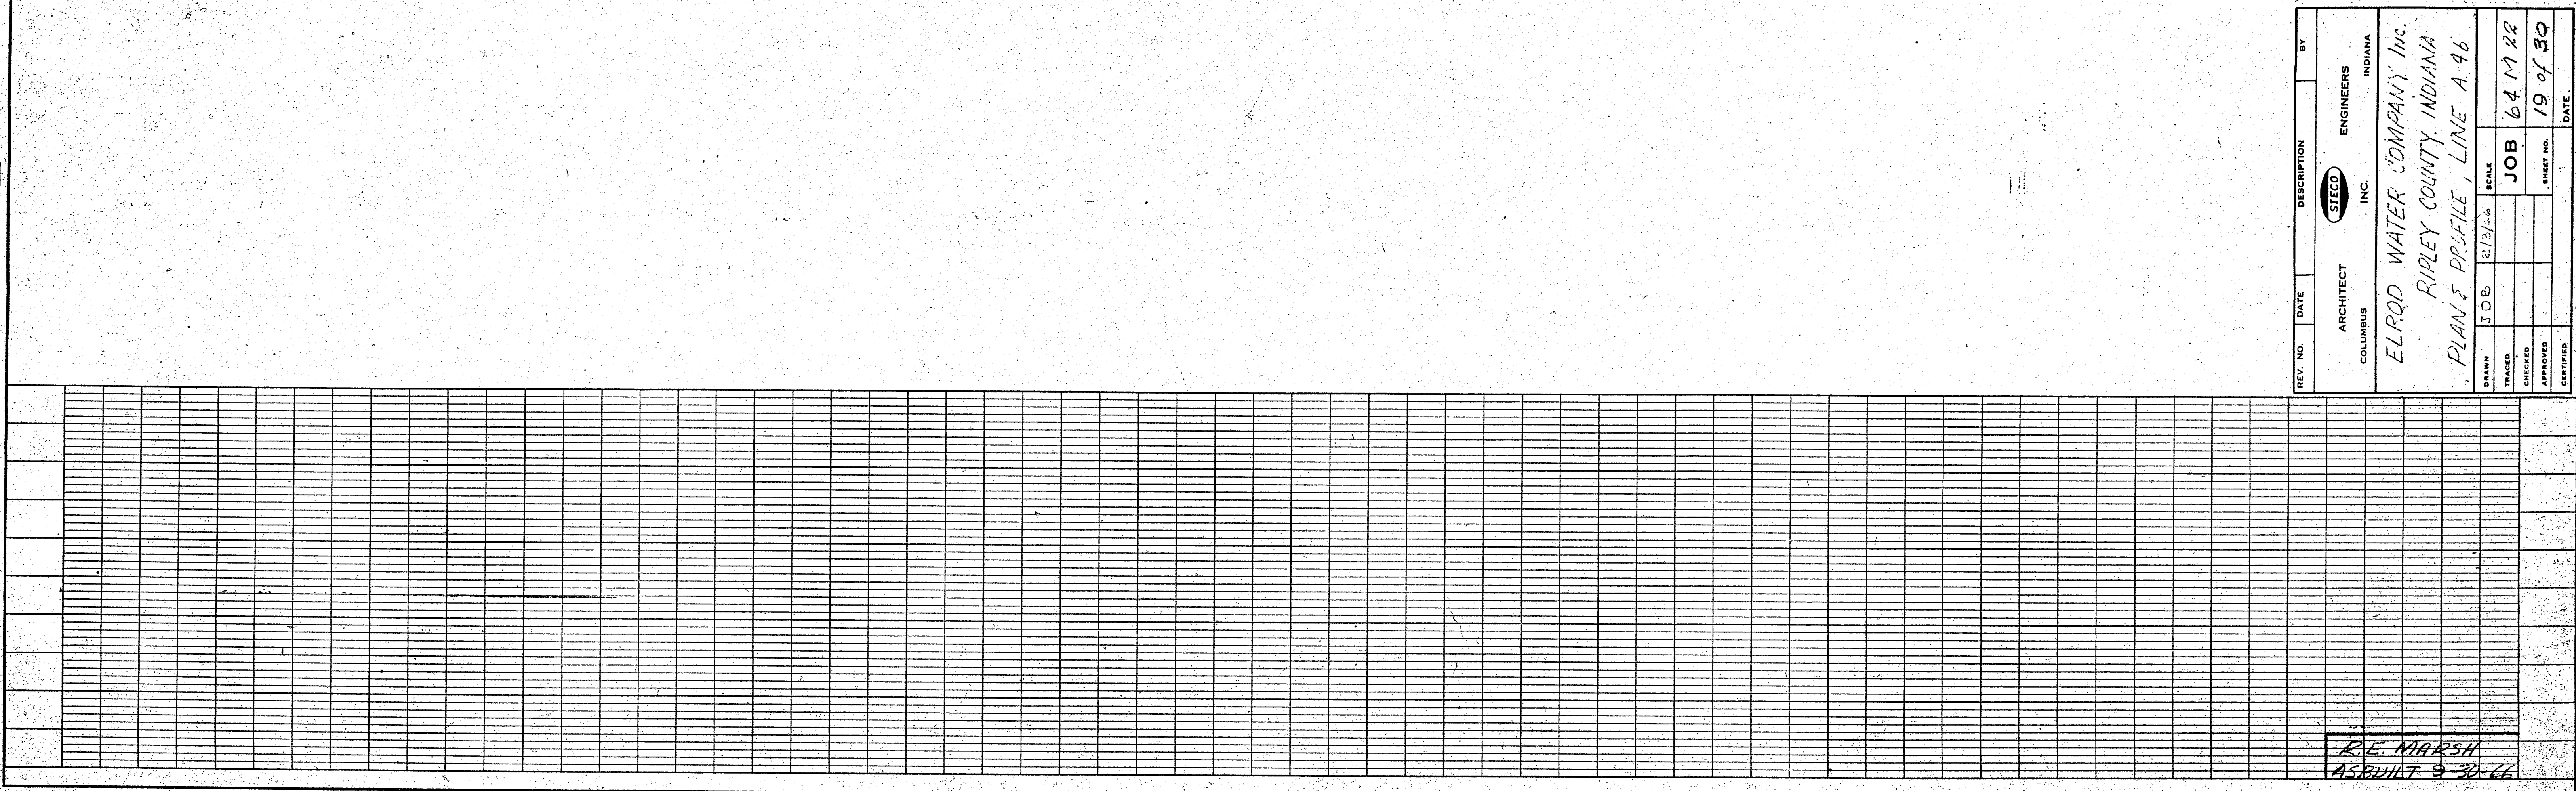

REV. NO.	DATE	DESCRIPTION	BY
1		ARCHITECT	ENGINEERS
2		COLUMBUS	INDIANA

ELRQD WATER COMPANY, INC.
RIPLEY COUNTY, INDIANA
PLAN & PROFILE, LINE A 46

DATE	SCALE	JOB	DATE
2/2/24	1"=40'	64 M 22	19 of 30

