


PLAN	DATE	BY	DATE
SURVEYED			
PLOTTED			
NOTE BOOK			
ALIGNMENT CHECKED			
RT. OF WAY CHECKED			
NO.			

PROFILE	DATE	BY	DATE
SURVEYED			
PLOTTED			
NOTE BOOK			
STRUCTURE NOTING SHEET			
NO.			

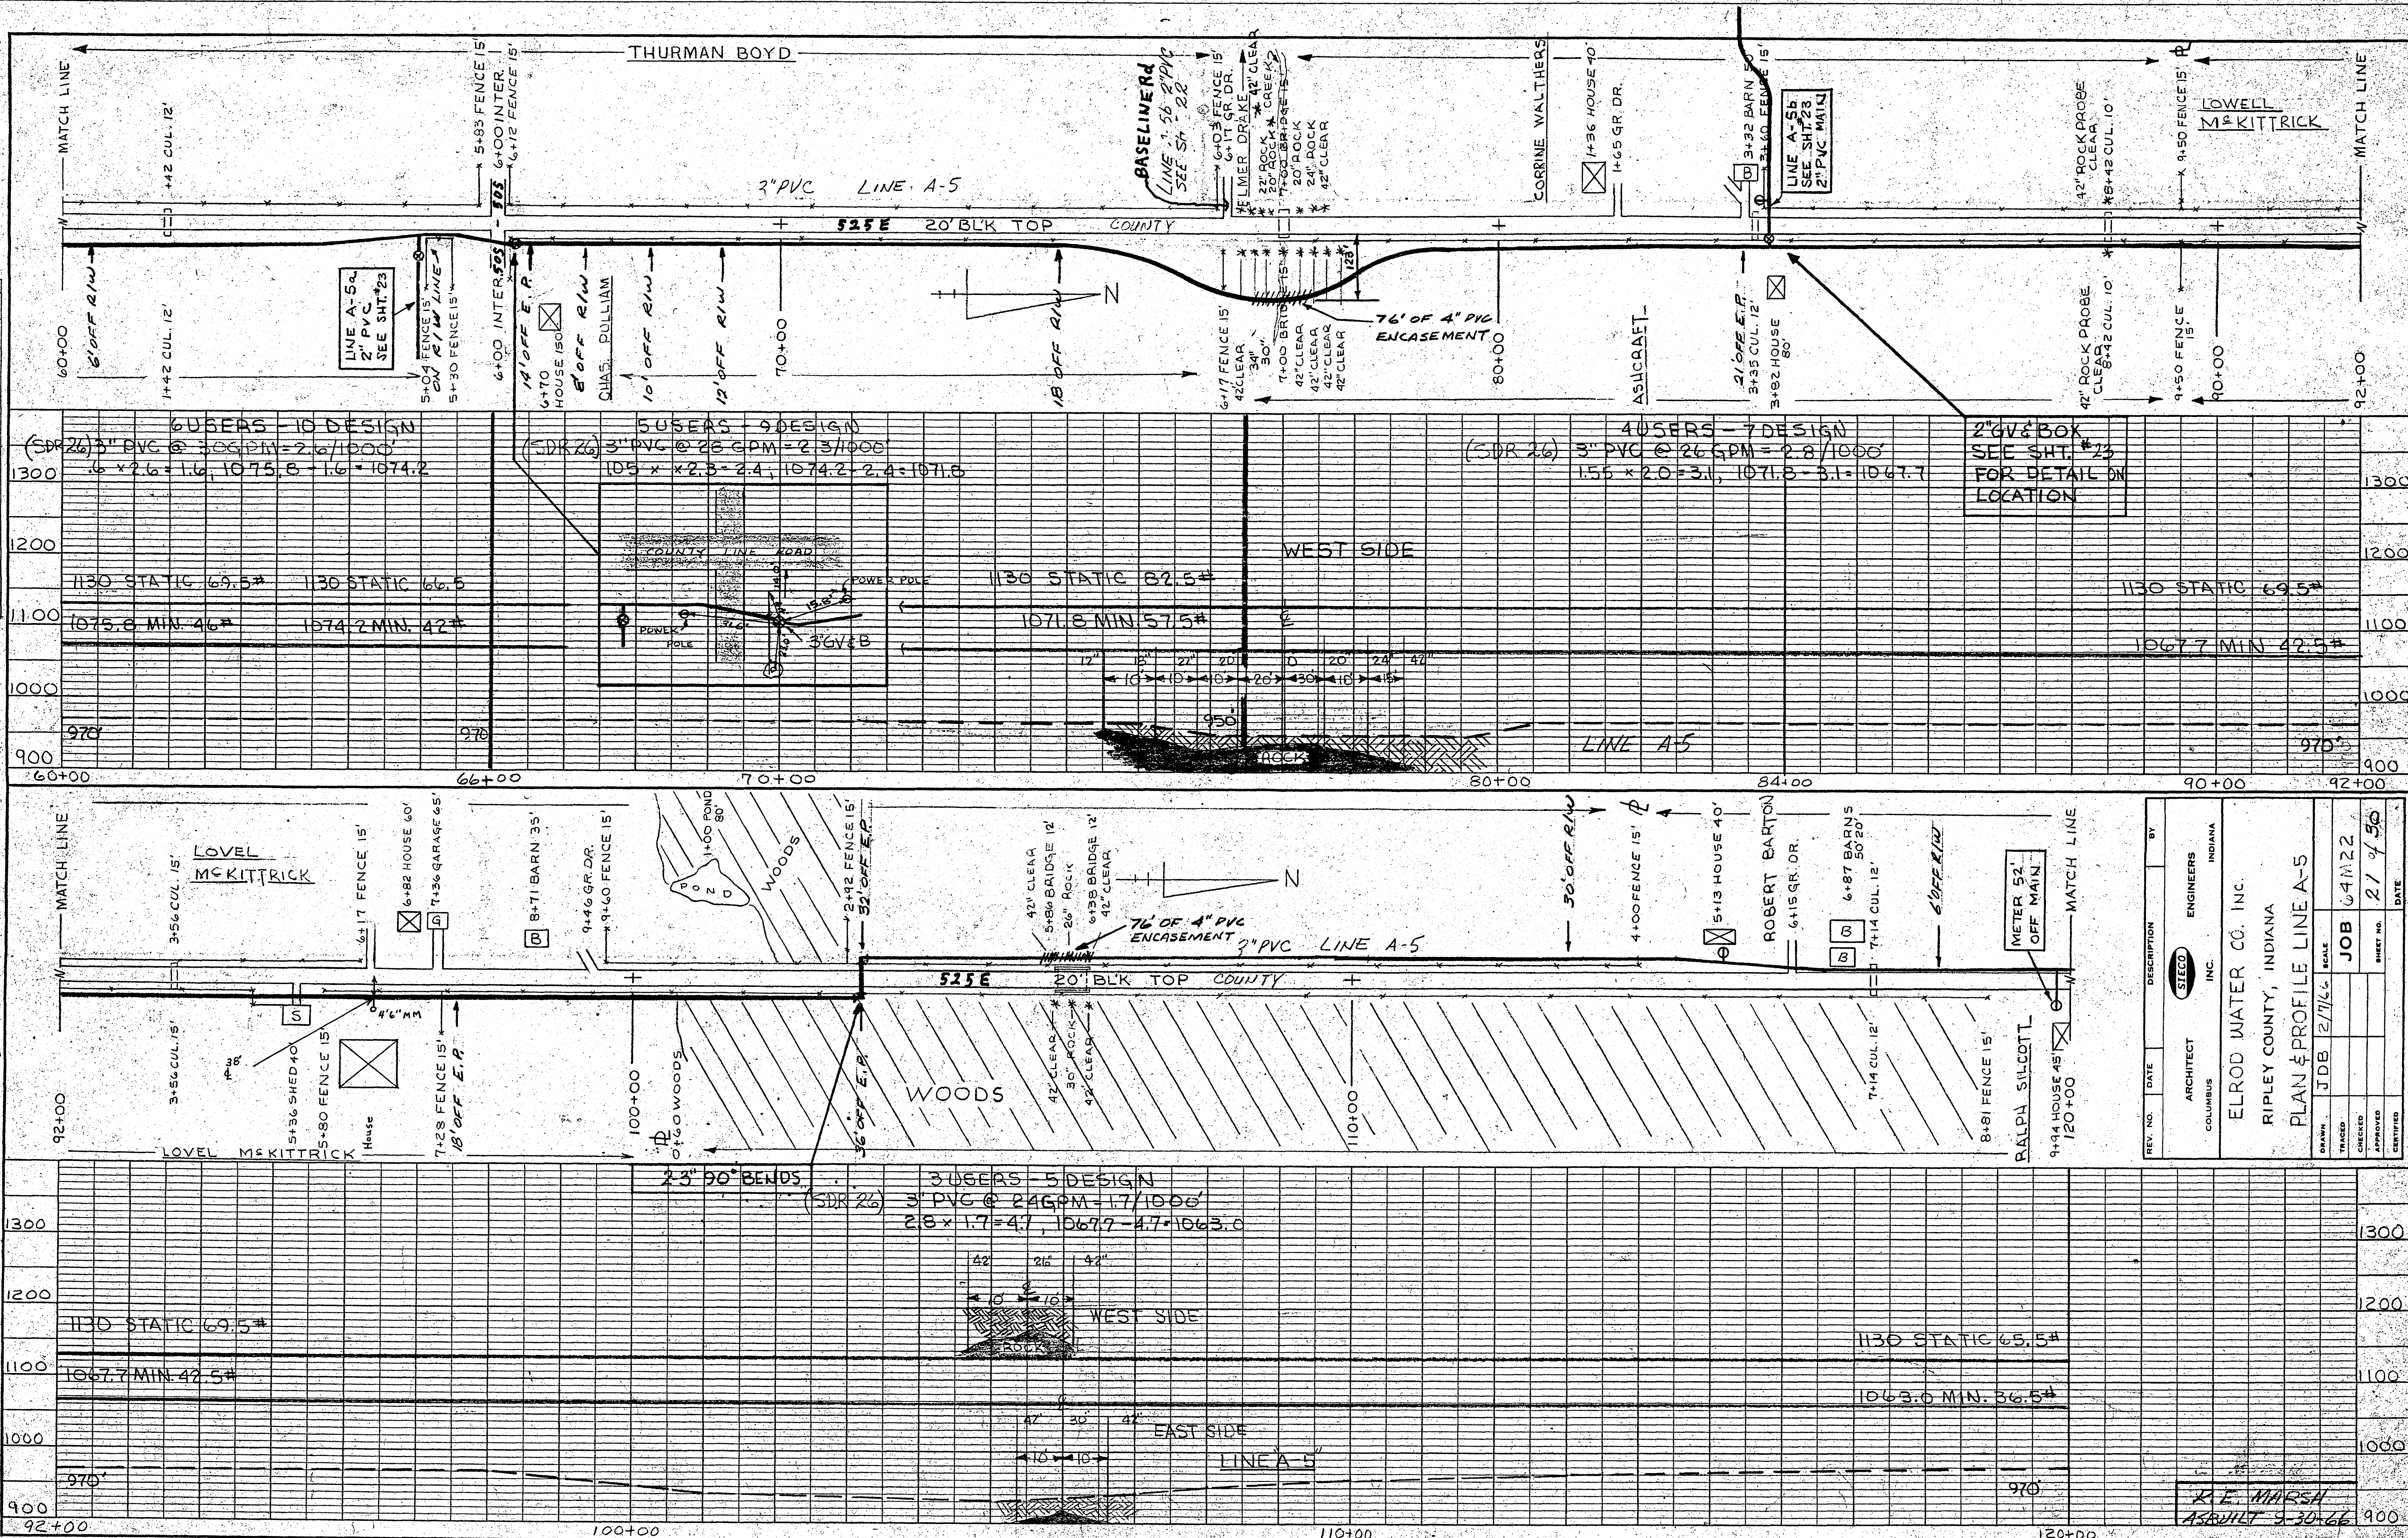

REV. NO.	DATE	DESCRIPTION	BY
