
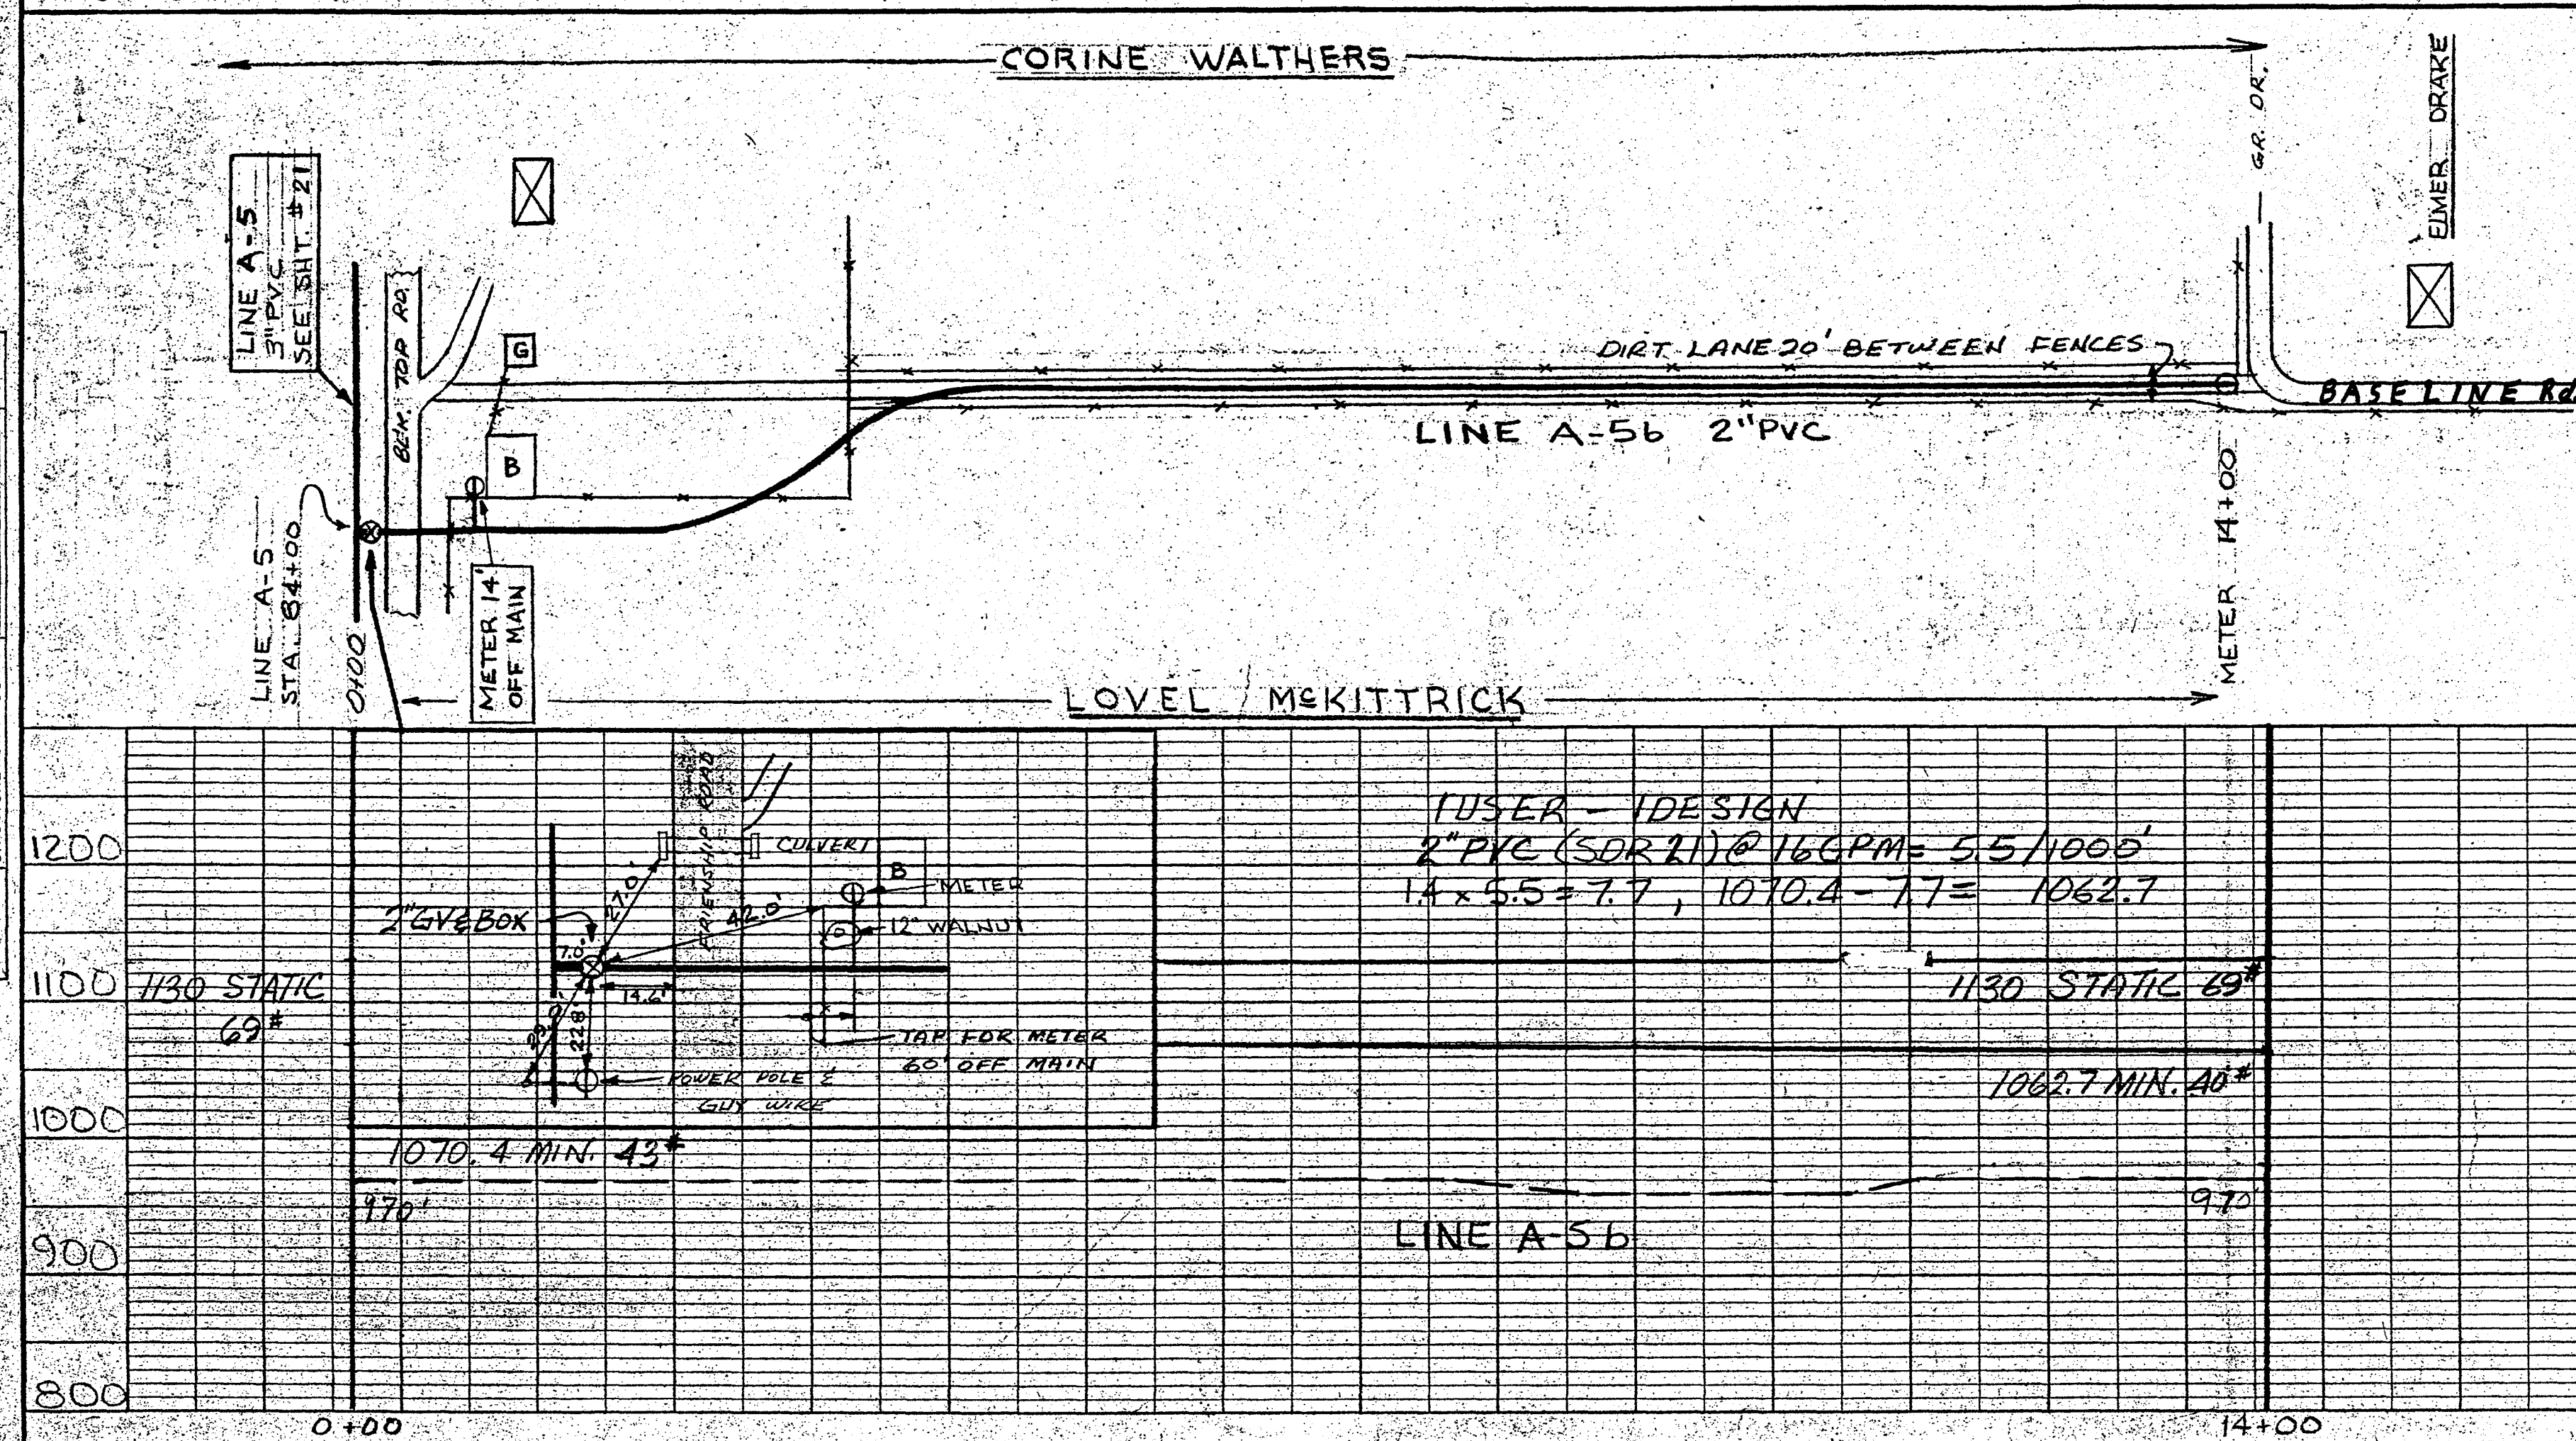


PLAN	DATE	BY
SURVEYED		
NOTED		
GRADES CHECKED		
RT. OF WAY CHECKED		
NO.		

PROFILE	DATE	BY
SURVEYED		
NOTED		
GRADES CHECKED		
STRUCTURE NOTATION		
NO.		

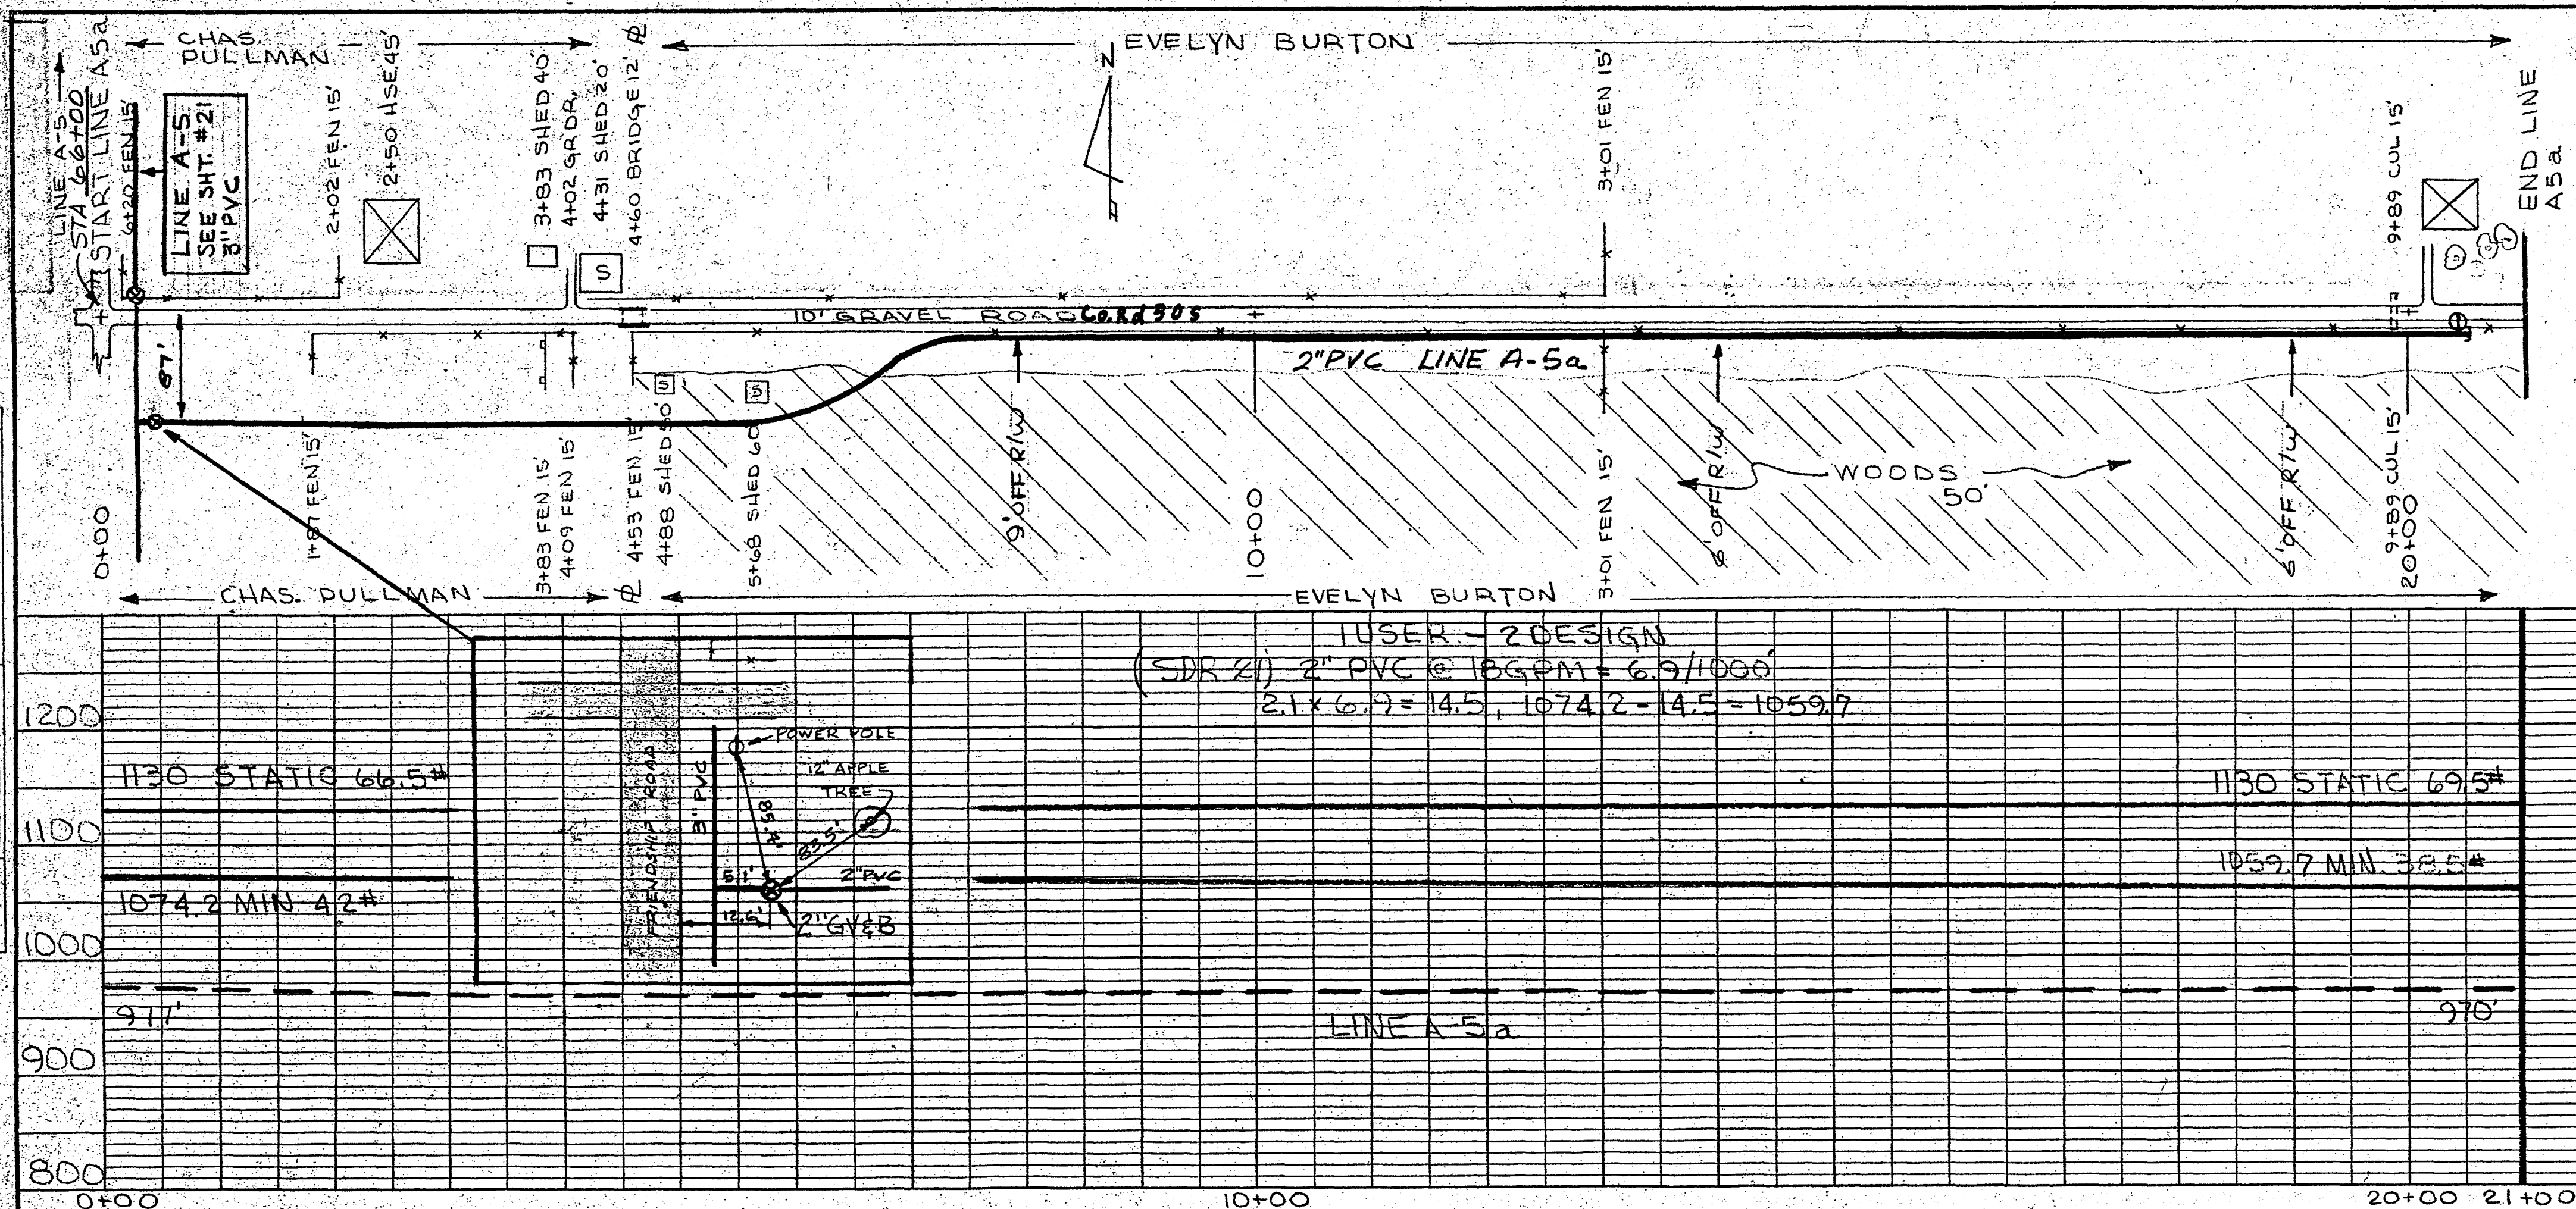

REV. NO.	DATE	DESCRIPTION	BY
1		ARCHITECT	ENGINEERS
2		COLUMBUS	INDIANA
3		INC.	
4			
5			
ELROD WATER COMPANY INC	ARCHITECT	ENGINEERS	INDIANA
RIPLEY COUNTY, INDIANA	COLUMBUS	INC.	
PLAN & PROFILE - LINE A-5a, A-5b			
DRAWN	S.W.T.	2-4-66	SCALE
TRACED			
CHECKED			
APPROVED			
CERTIFIED			
JOB	64M22		
SHEET NO.	23 of 30		
DATE			