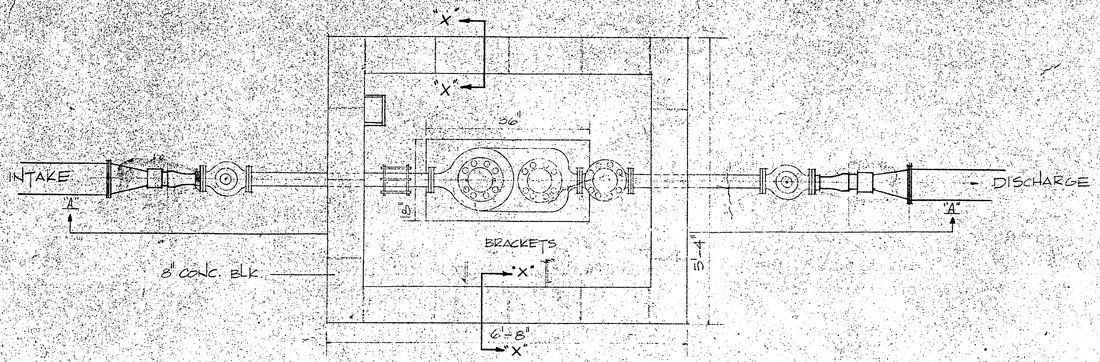

PLAN

COMPOUND METER — # 1

DIVISION "A" BID ITEM # 36

SEE SHT. # 3

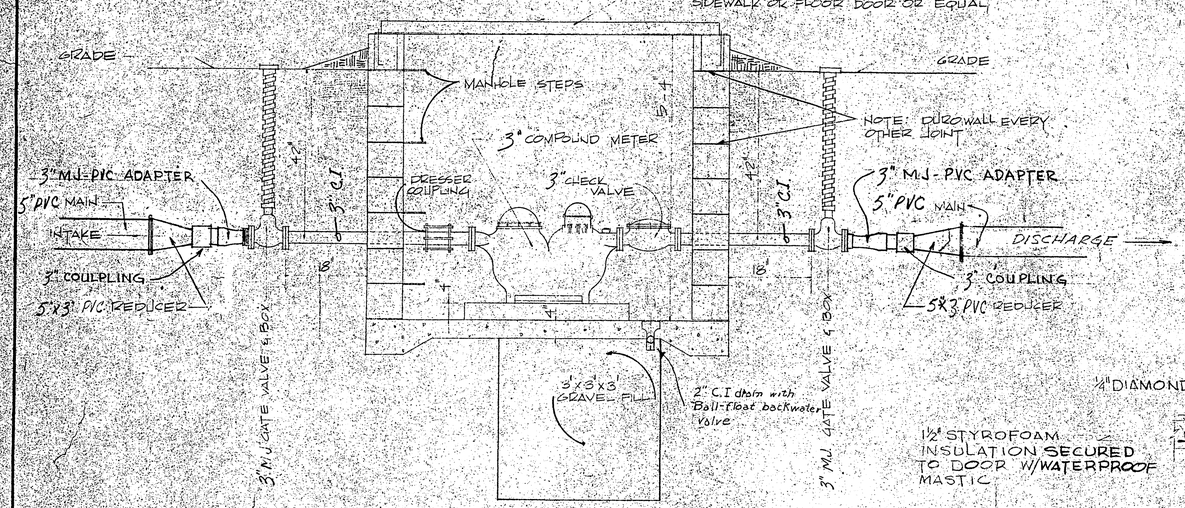

SECTION "A-A"

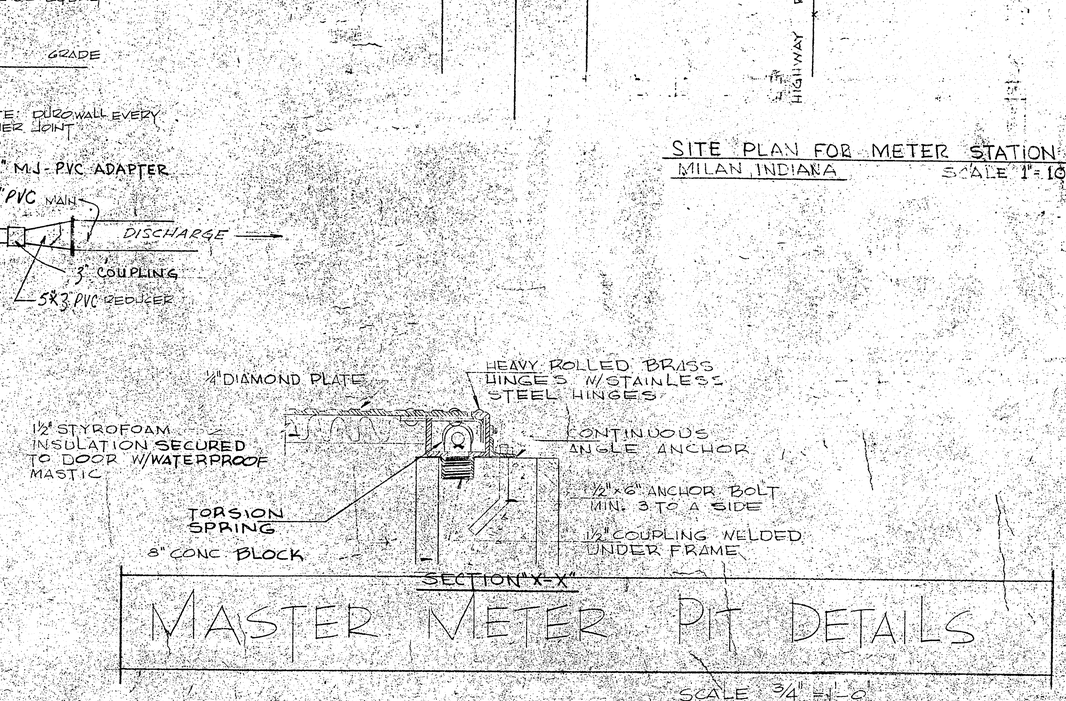

SECTION "X-X"

MASTER METER PIT DETAILS

SCALE 3/4" = 1'-0

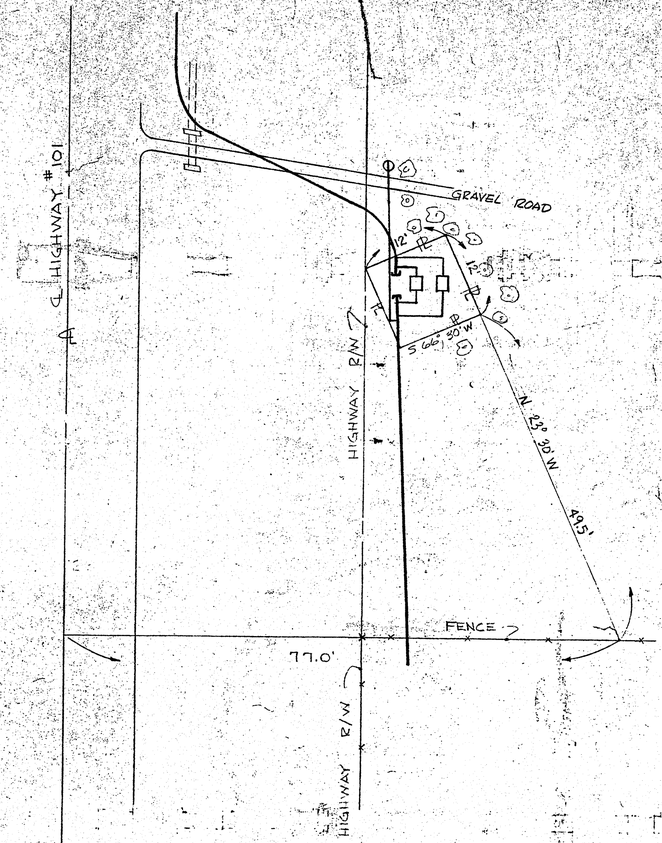

SITE PLAN FOR METER STATION
MILAN, INDIANA SCALE 1"=10.0

Note

Where finished grades permit, drains shall be carried to roadside ditch in C.I. or pvc & capped with rodent screen. Gravel fill may be eliminated if such drain condition can be established.

NOTES & SYMBOLS

REV. NO.	DATE	DESCRIPTION

ELROD WATER COMPANY, INC.
RIPLEY COUNTY, INDIANA
MASTER METER PIT DETAILS

SIECO, Inc.
architects
engineers
COLUMBUS
MADISON
BLOOMINGTON

JOB NO.	64M22
DWG.	3-1-66
DRAWN	J.F.S.
CHECKED	
CERTIFIED	
SCALE	AS NOTED
SHEET	26 OF 30

R.E. MARSH
AS BUILT 9-30-66