
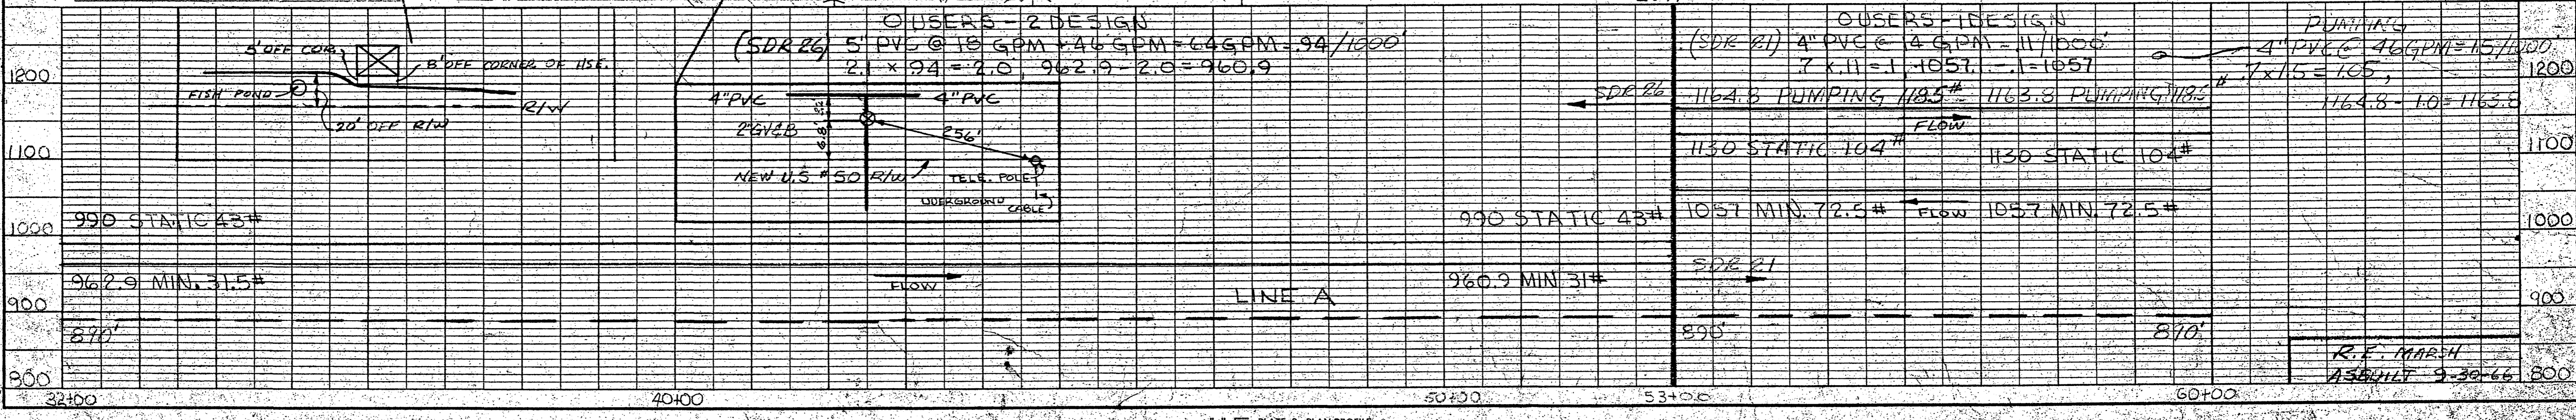
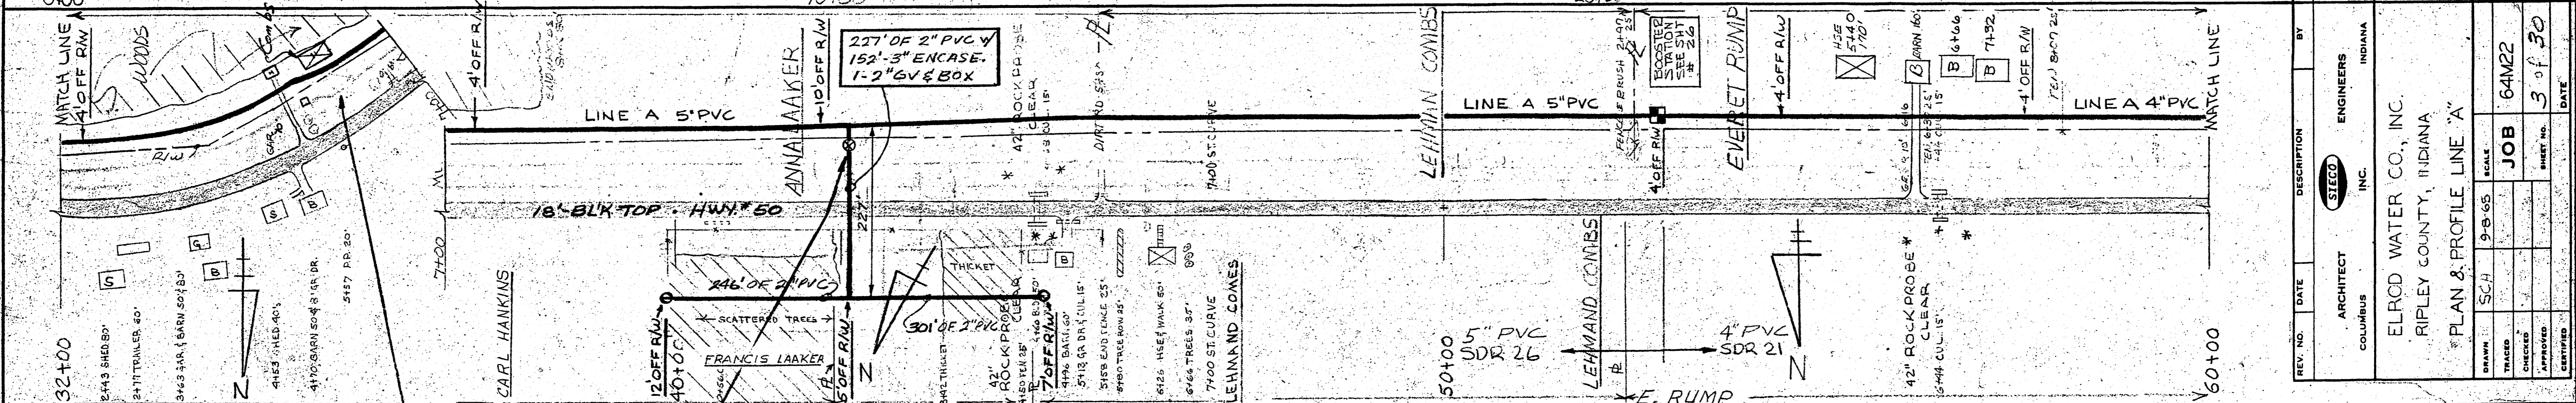
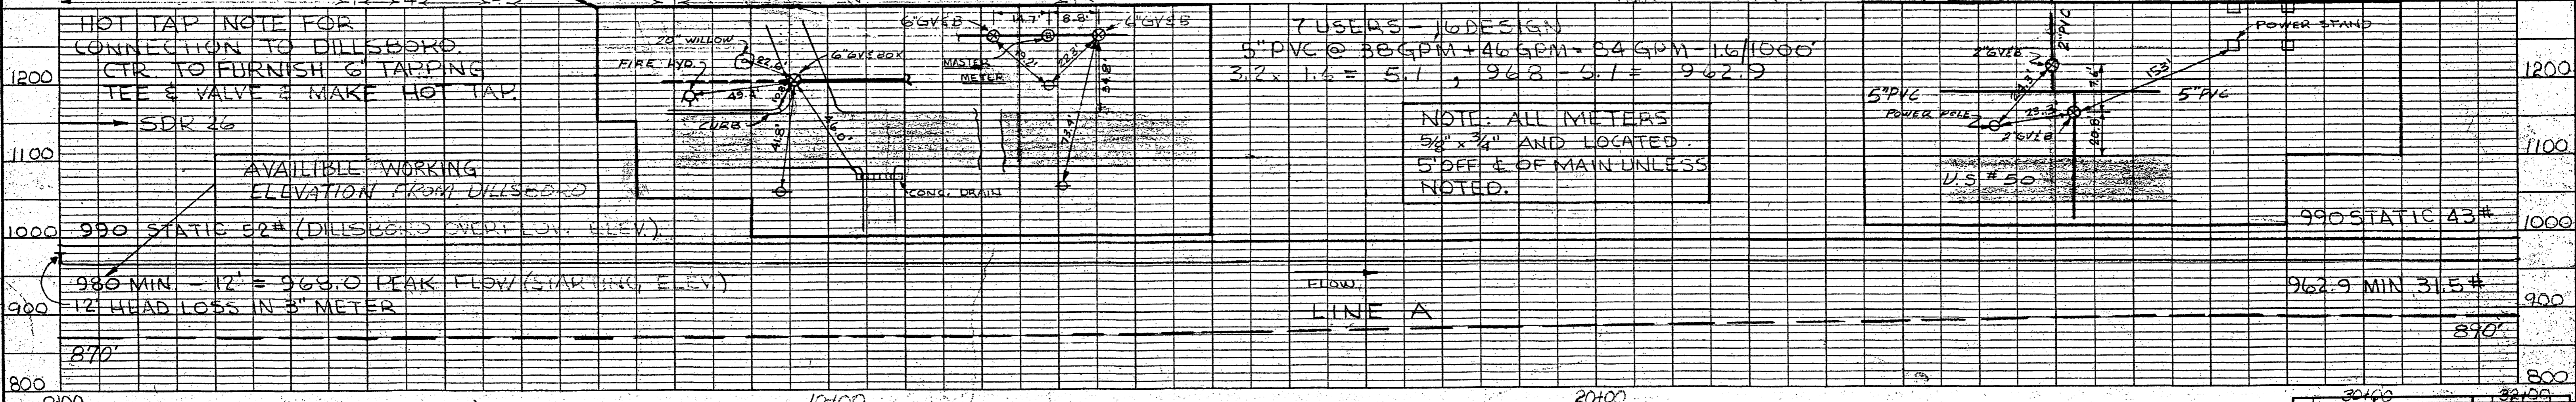


PLAN SURVEYED, PLOTTED, GRADES CHECKED, STRUCTURE NOTATIONS OK'D. DATE: BY: NO. OF WAY CHECKED:

PROFILE SURVEYED, PLOTTED, GRADES CHECKED, STRUCTURE NOTATIONS OK'D. DATE: BY: NO. OF WAY CHECKED:

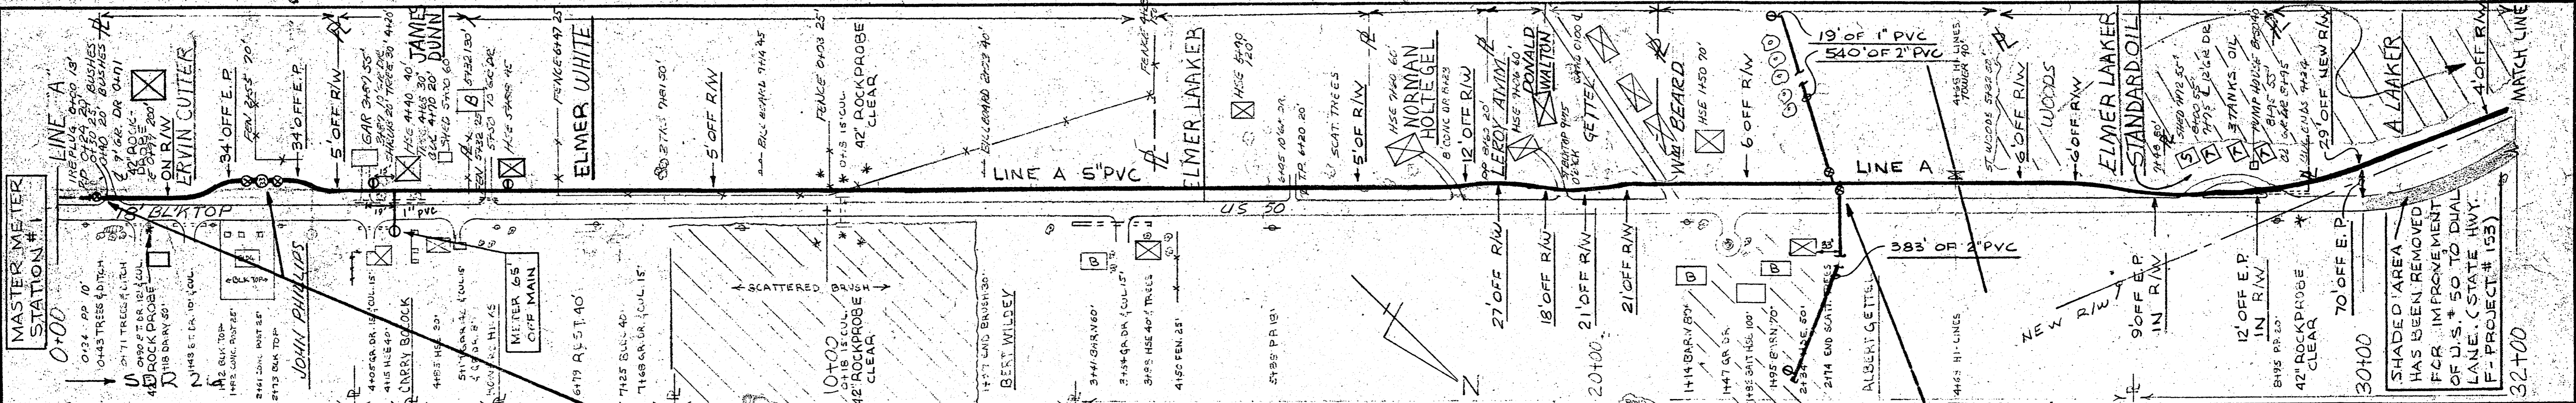

REV. NO.	DATE	DESCRIPTION	BY

ARCHITECT: SIEDCO ENGINEERS INC. COLUMBUS INDIANA

ELROD WATER CO., INC. RIPLEY COUNTY, INDIANA

PLAN & PROFILE LINE 'A'

DRAWN	SCH	9-8-65	SCALE	JOB	64M22
CHECKED				SHEET NO.	3 of 30
APPROVED				DATE	
CERTIFIED					