


PLAN	DATE	BY
SURVEYED		
NOTED		
ALIGNED		
CHECKED		
NO.		

PROFILE	DATE	BY
SURVEYED		
NOTED		
ALIGNED		
CHECKED		
NO.		

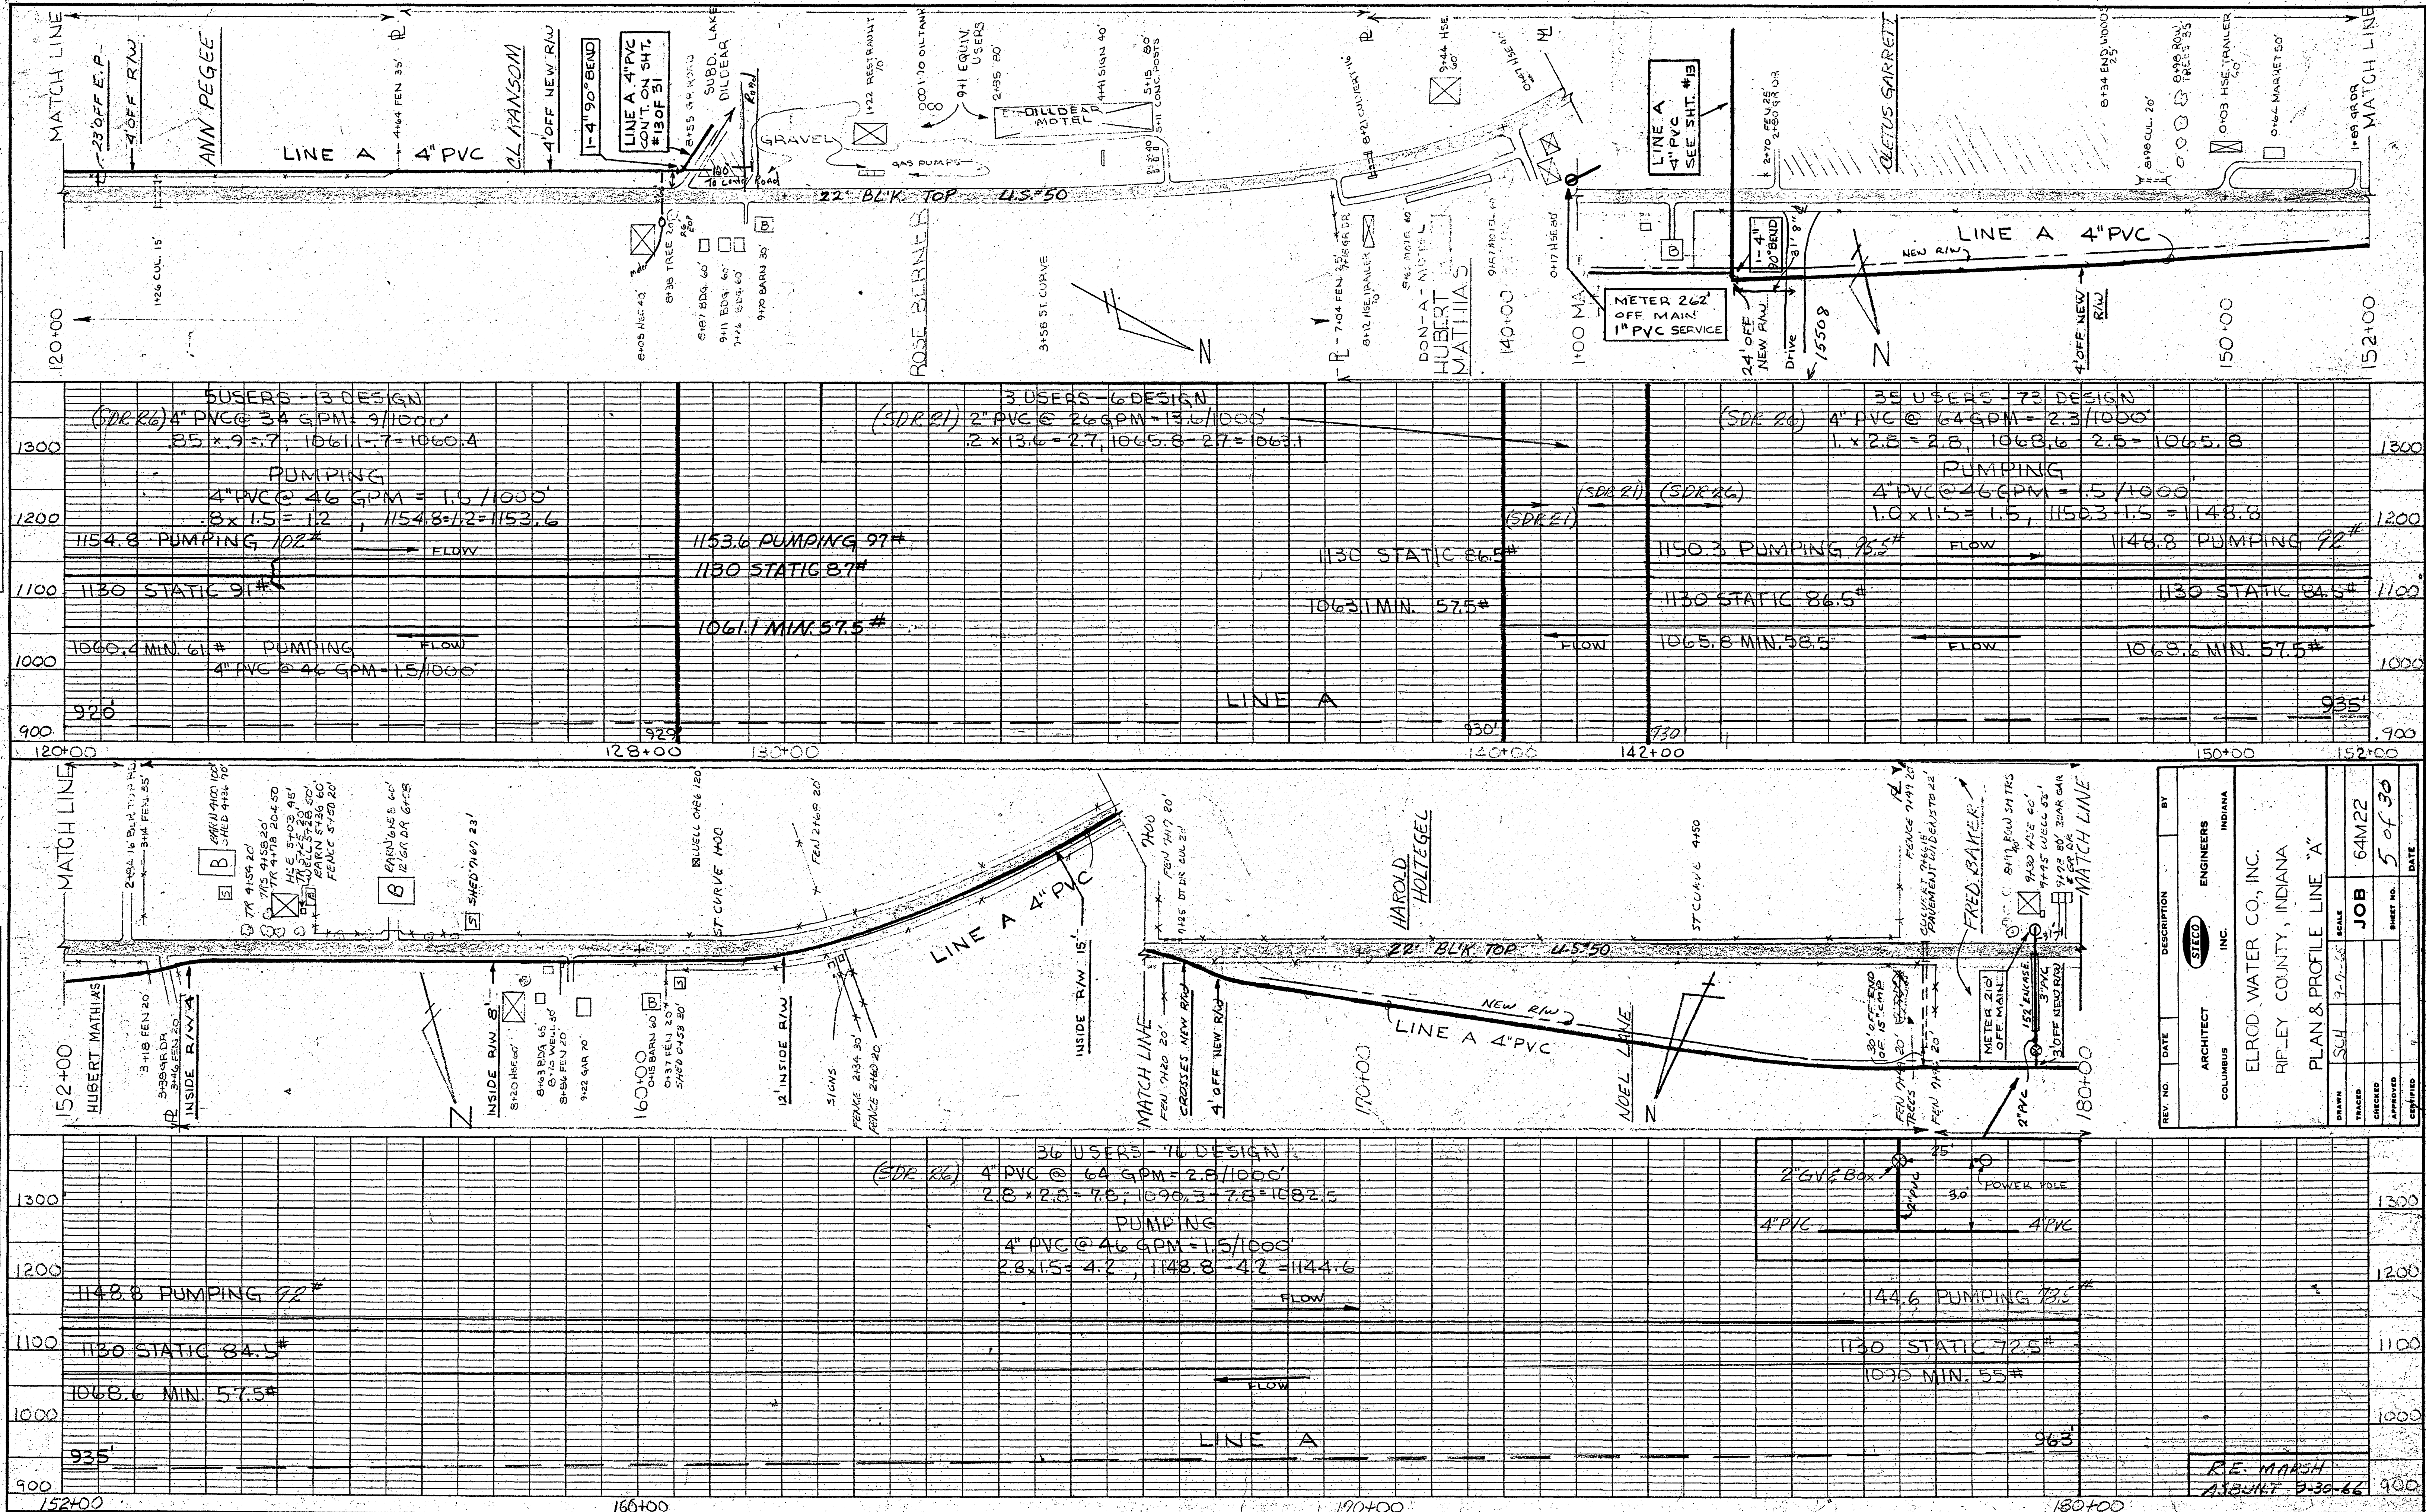

REV. NO.	DATE	DESCRIPTION	BY
1			
2			
36			