


| PLAN     | DATE | BY | DATE | BY |
|----------|------|----|------|----|
| SURVEYED |      |    |      |    |
| NOTED    |      |    |      |    |
| NO.      |      |    |      |    |

| PROFILE  | DATE | BY | DATE | BY |
|----------|------|----|------|----|
| SURVEYED |      |    |      |    |
| NOTED    |      |    |      |    |
| NO.      |      |    |      |    |

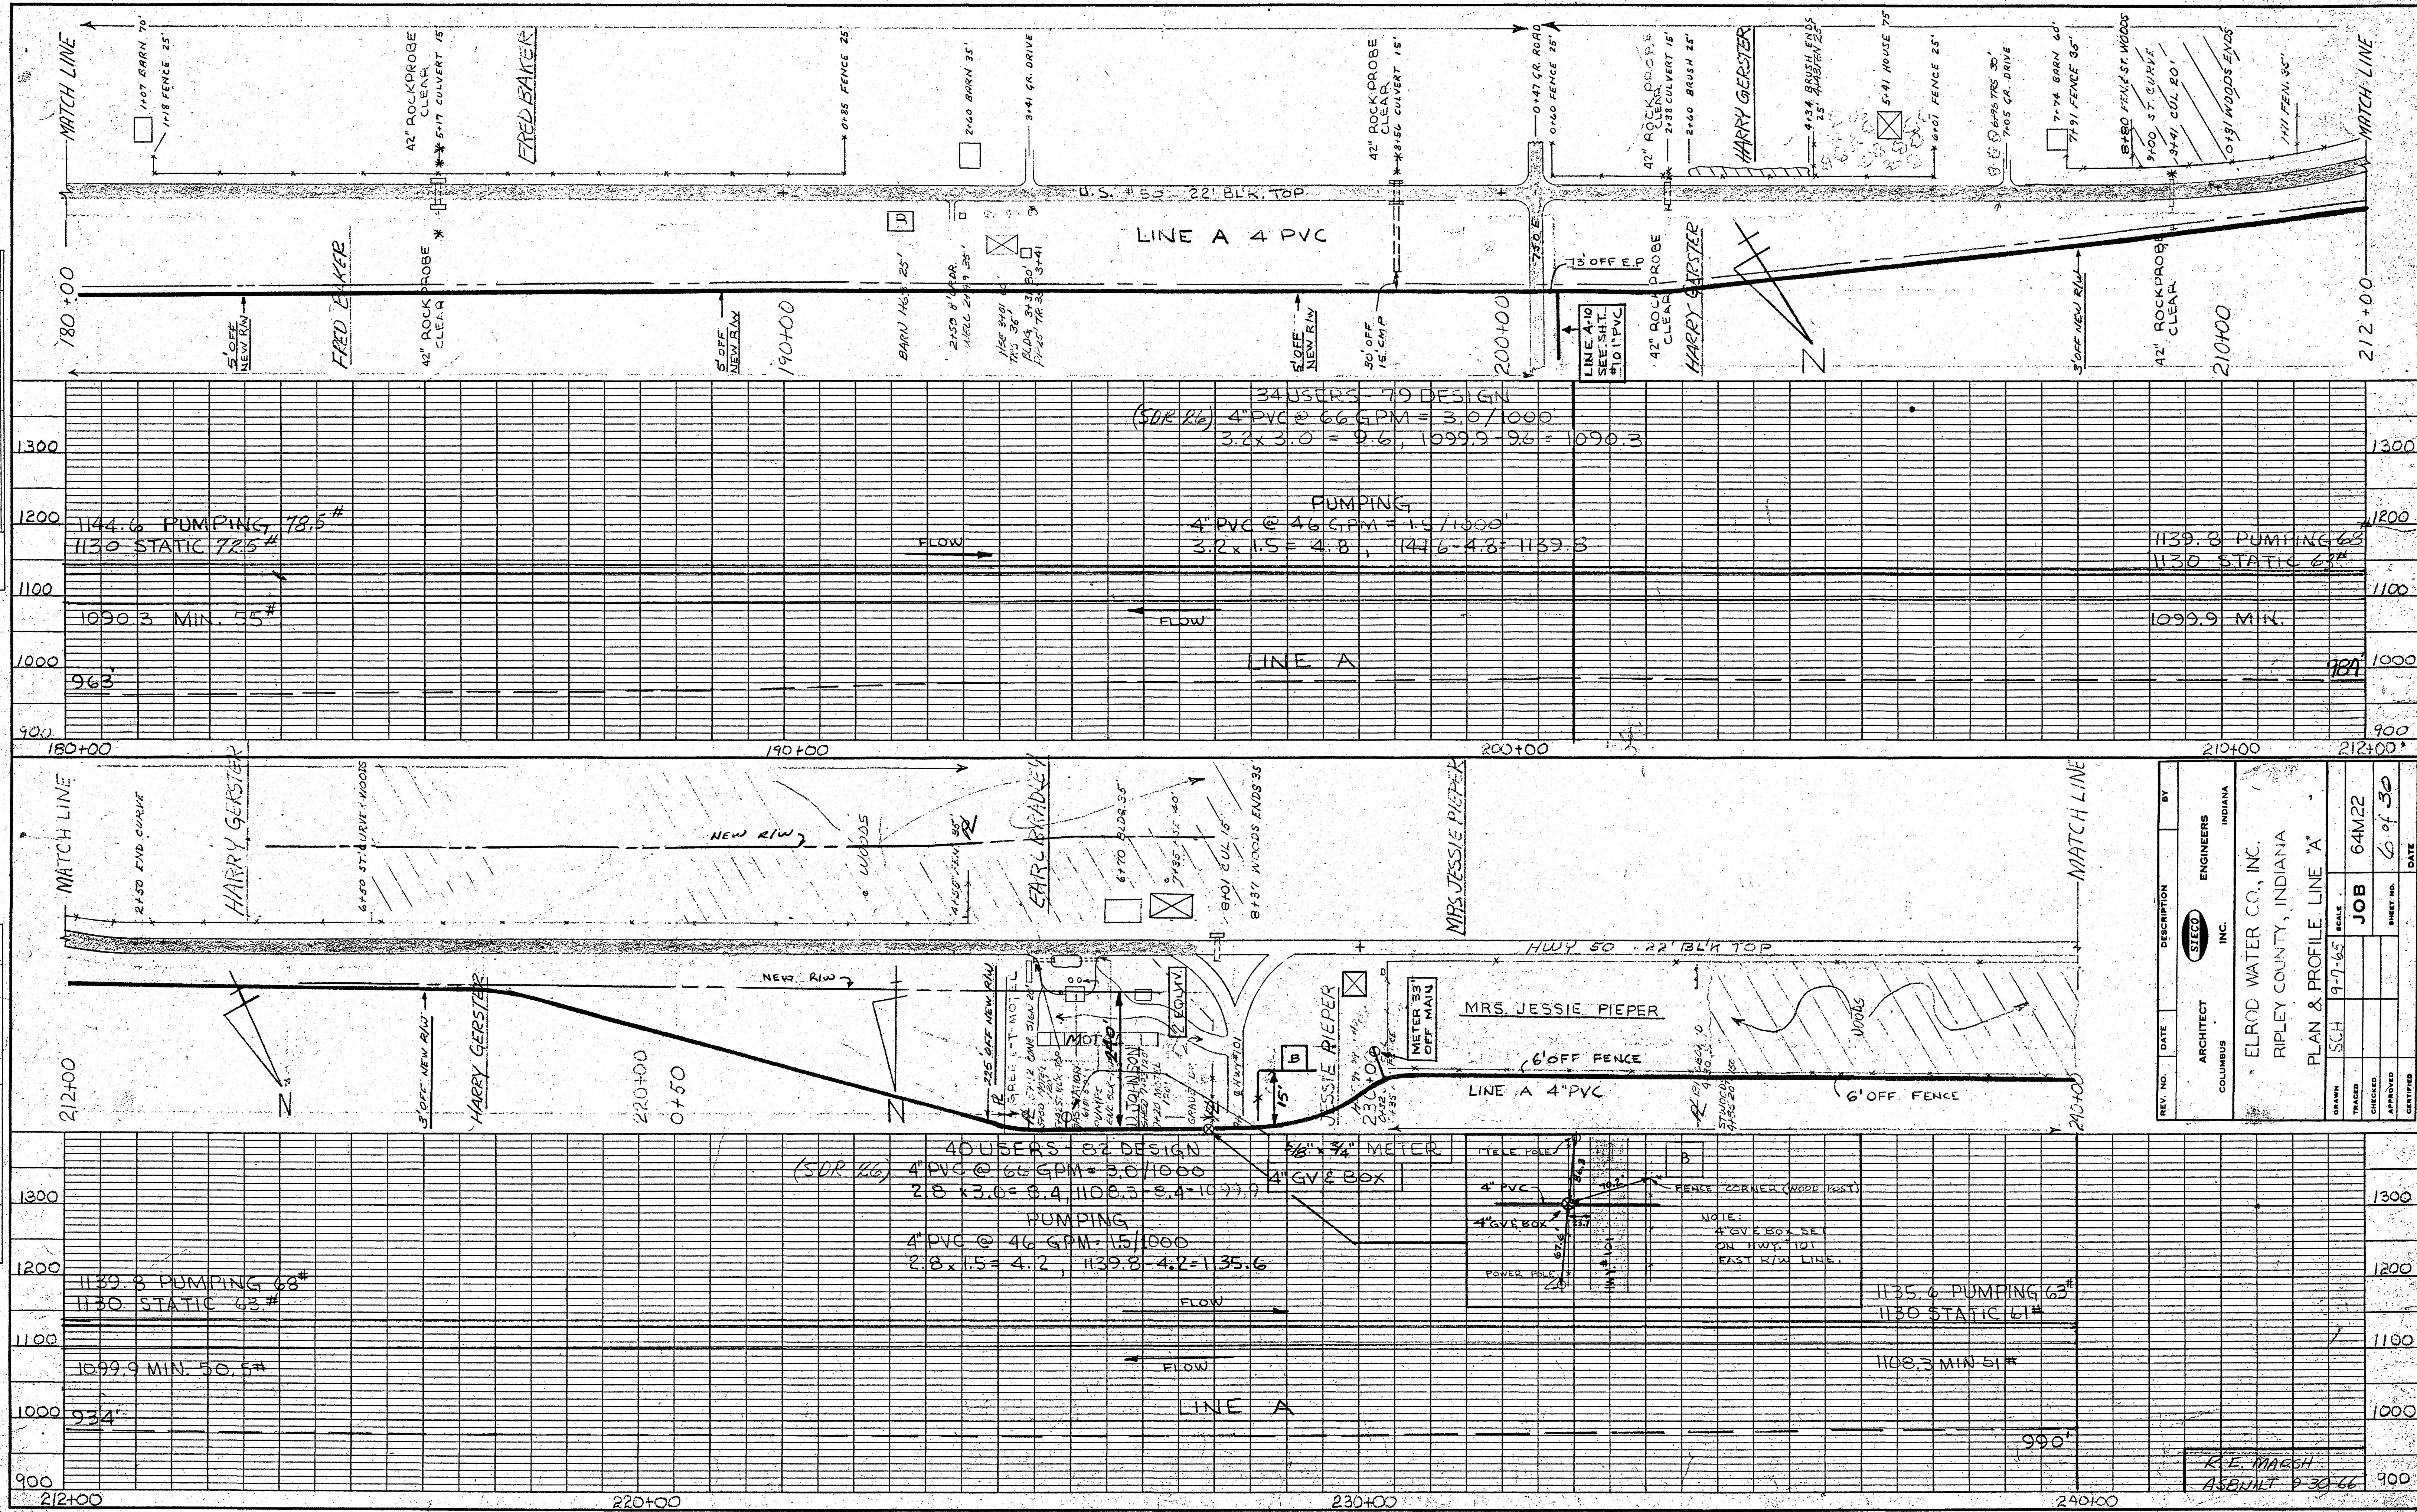

| REV. NO. | DATE | DESCRIPTION | BY |
|----------|------|-------------|----|

ARCHITECT  
COLUMBUS

ENGINEERS  
INDIANA

ELROD WATER CO., INC.  
RIPLEY COUNTY, INDIANA

| PLAN & PROFILE LINE "A" | DATE  | BY      |
|-------------------------|-------|---------|
| SCH 9-7-65              | 64M22 | 6 of 30 |
| JOB                     |       |         |
| SHEET NO.               |       |         |
| DATE                    |       |         |