


PLAN	DATE	BY
SURVEYED		
PLOTTED		
GRADES CHECKED		
STRUCTURE NOTATIONS OK'D		
NOTE BOOK		
RT. OF WAY CHECKED		
NO.		

PROFILE	DATE	BY
SURVEYED		
PLOTTED		
GRADES CHECKED		
STRUCTURE NOTATIONS OK'D		
NOTE BOOK		
RT. OF WAY CHECKED		
NO.		

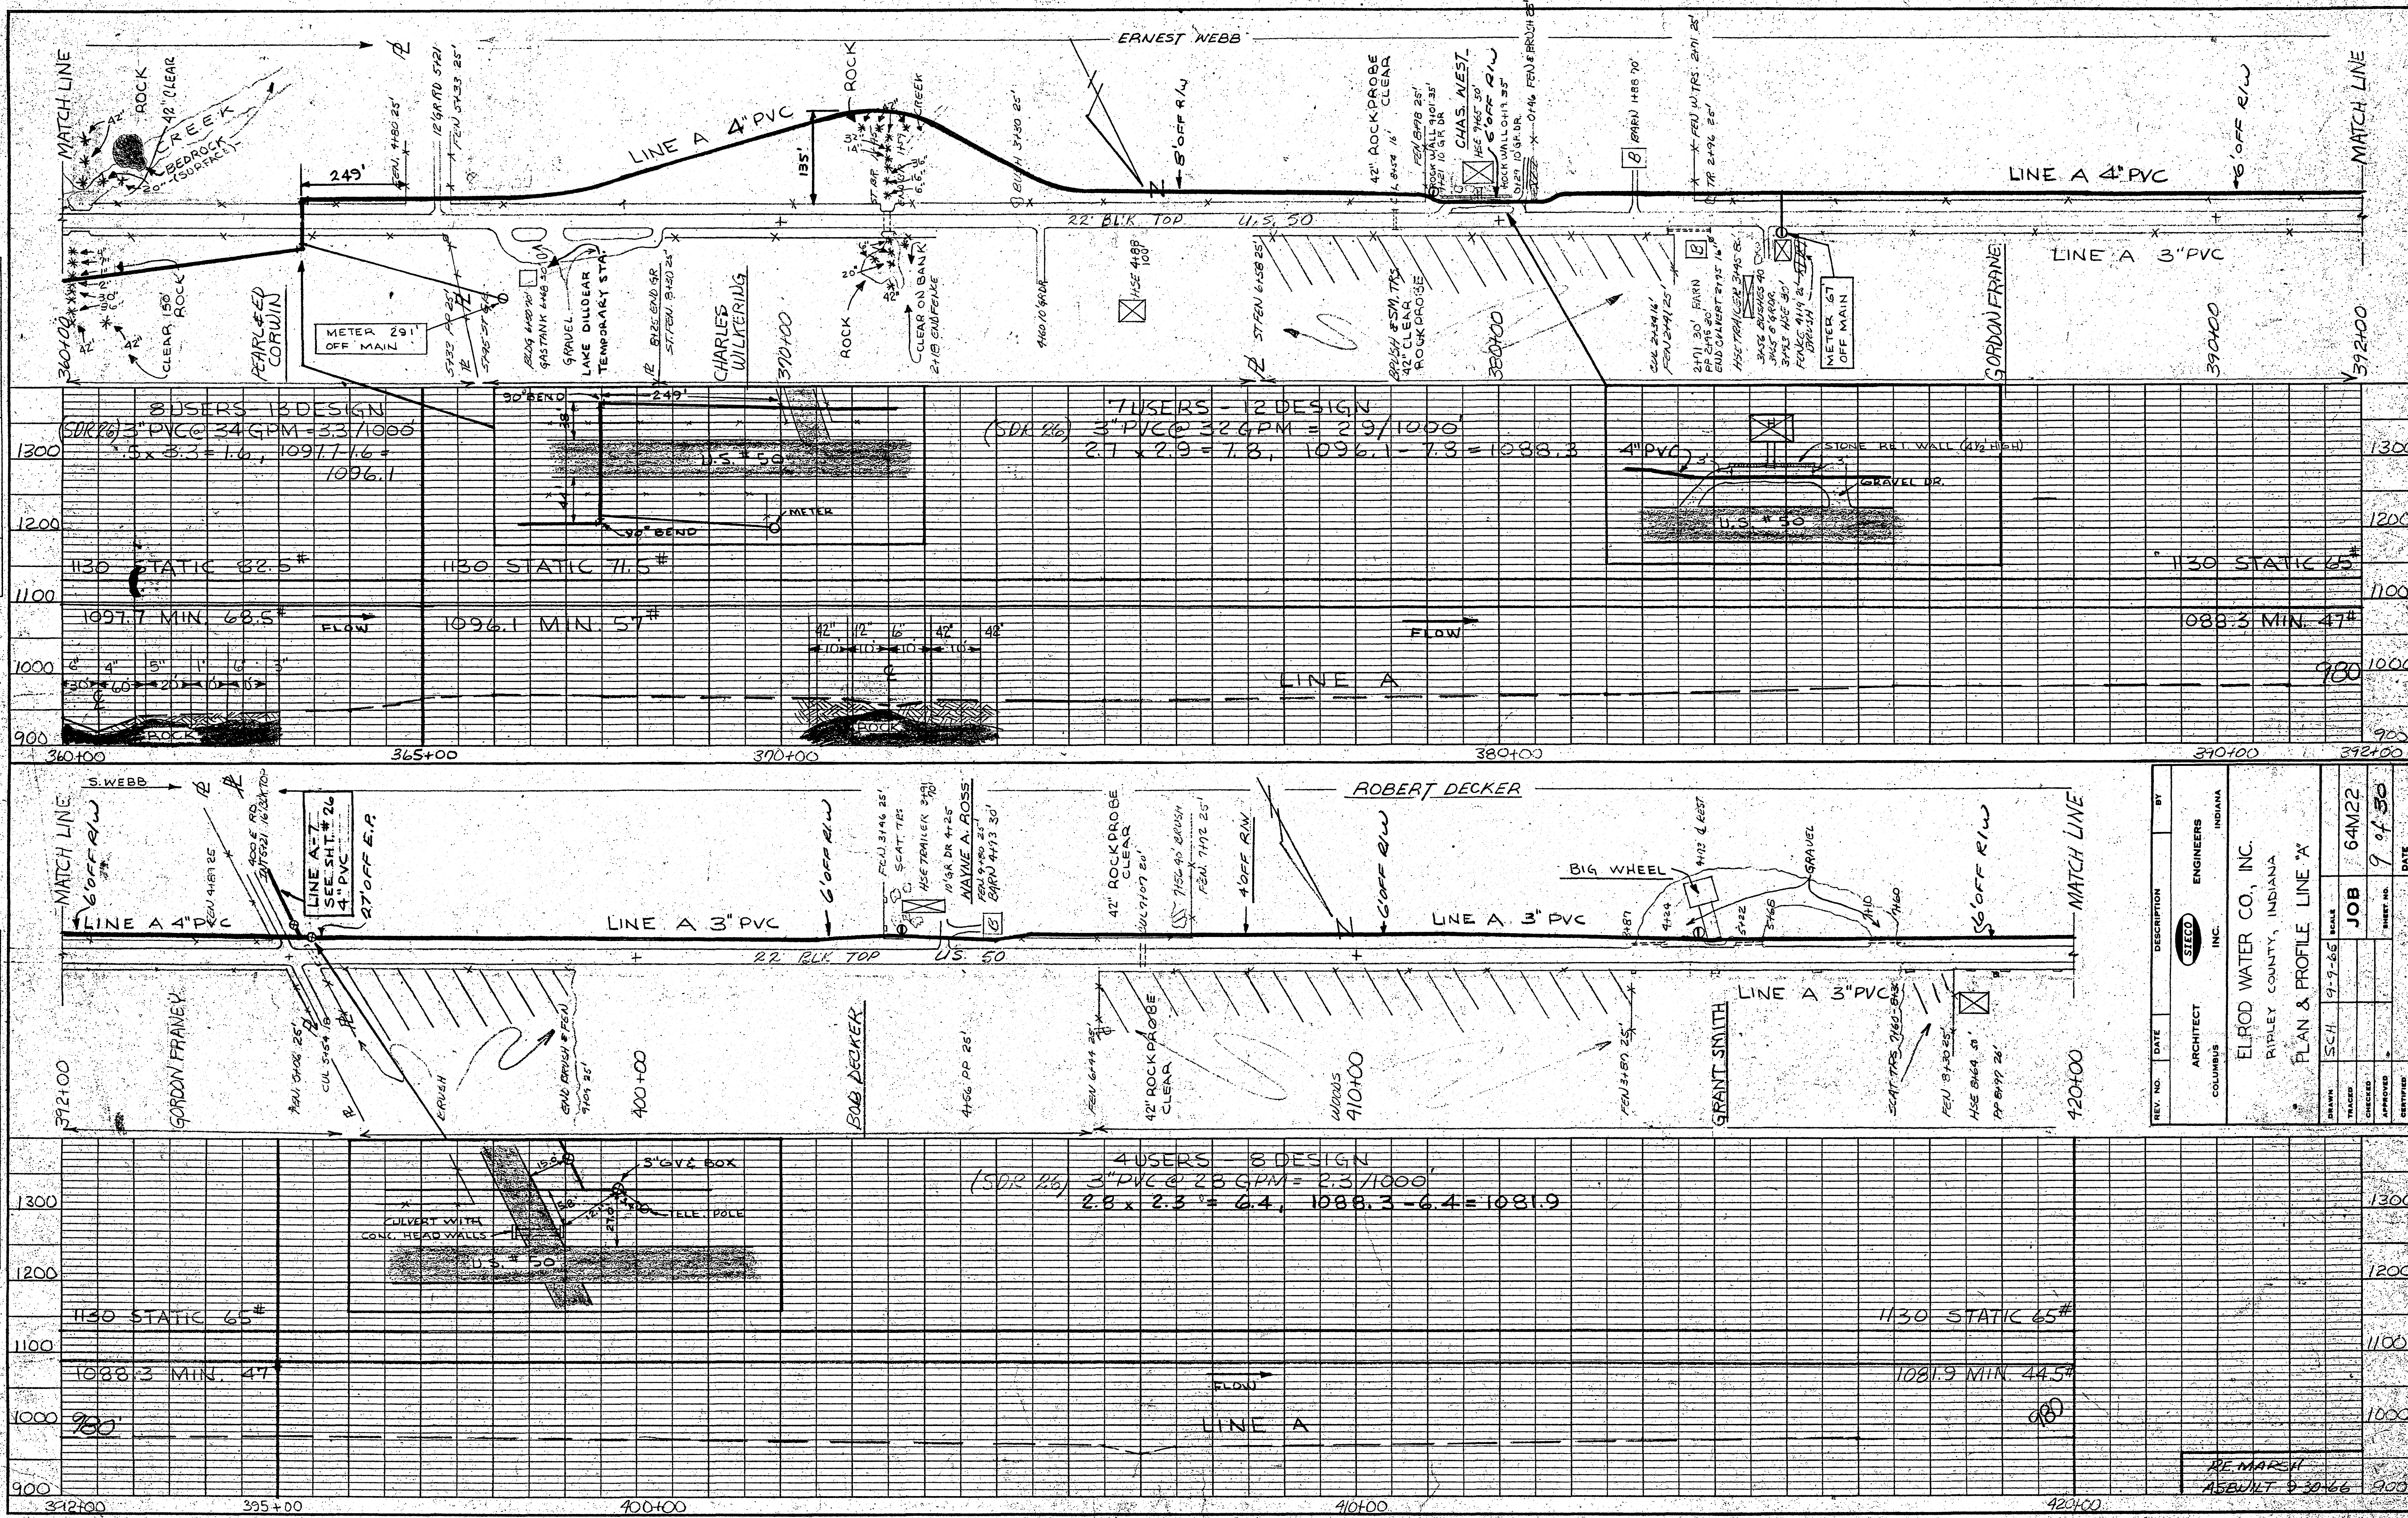

REV. NO.	DATE	DESCRIPTION	BY
1			
2			
