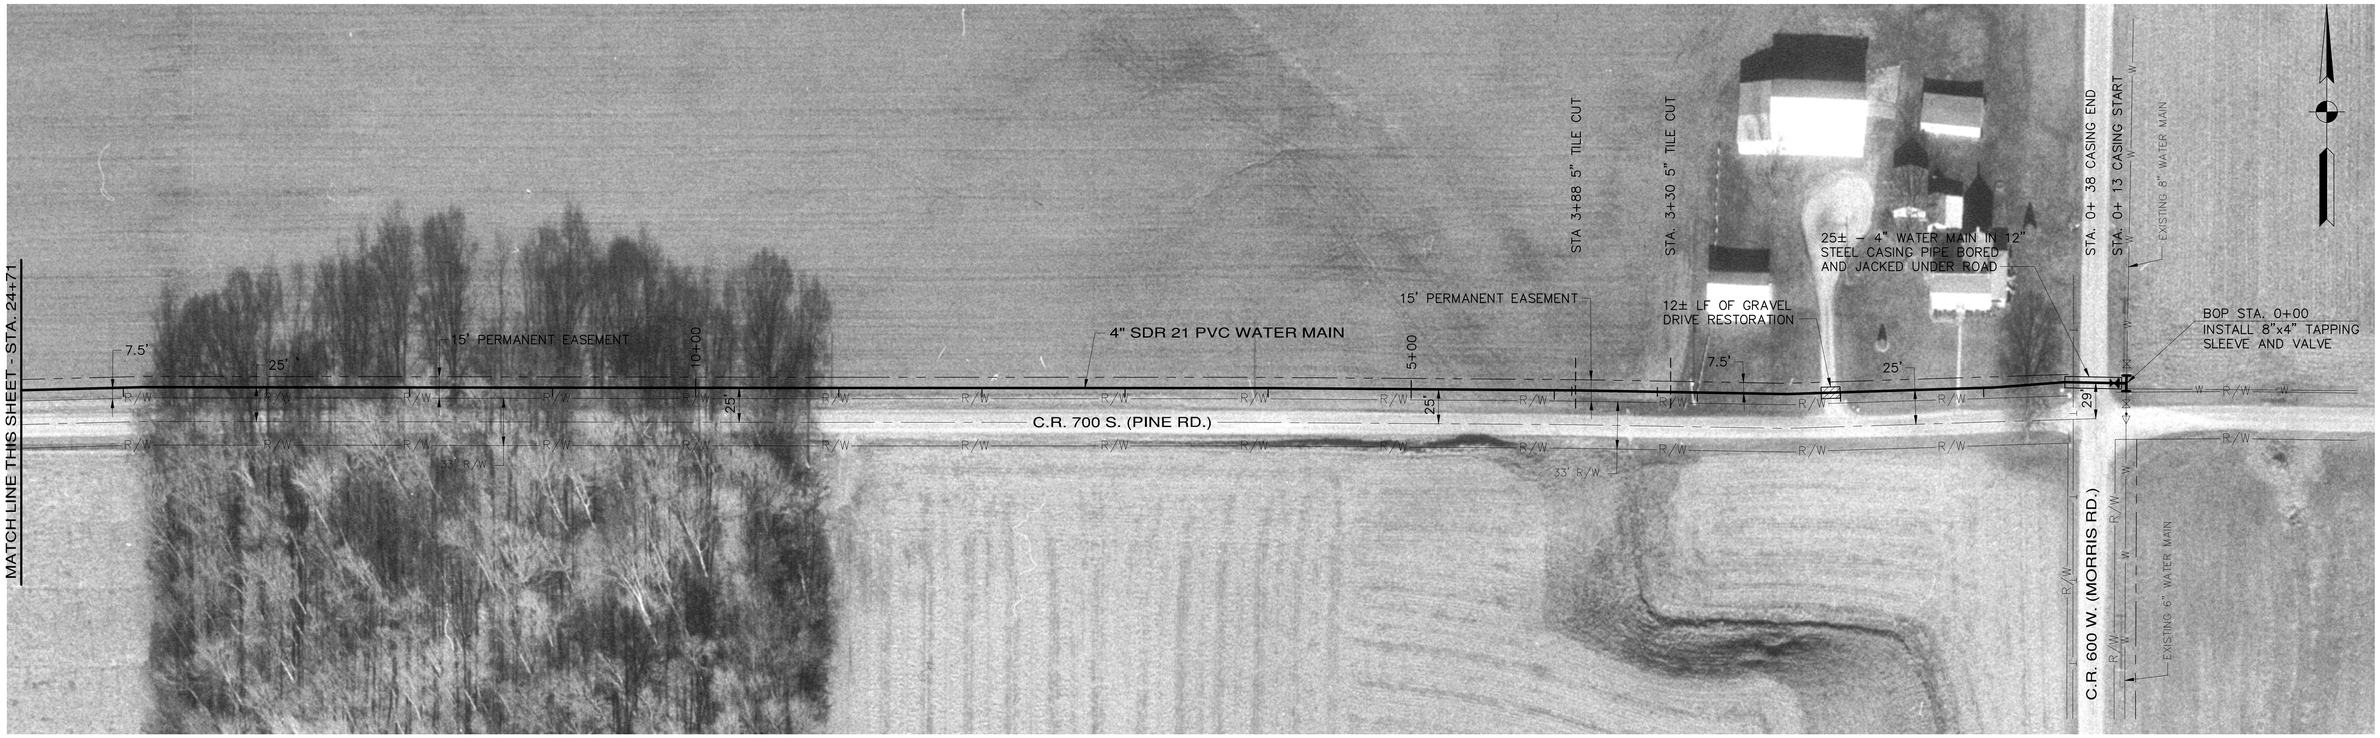

NOTES:

NO.	DESCRIPTION	DATE	BY
2	RENUMBERED	6-03	GCR
1	AS-BUILT	8-01	MAT

REVISIONS

HOOSIER HILLS REGIONAL WATER DISTRICT

PINE ROAD AT MORRIS ROAD WATER MAIN EXTENSION

GRW PROJECT NO. 2543-24

GREGORY A. WRIGHT REGISTERED No. 19300607 STATE OF INDIANA PROFESSIONAL ENGINEER

GRW Engineers, Inc.
Engineers, Architects, Planners
INDIANAPOLIS, INDIANA
LOUISVILLE & LEXINGTON, KENTUCKY
CINCINNATI, OHIO
NASHVILLE, TENNESSEE
ARLINGTON, TEXAS

DRAWN: KAY	DATE: MARCH 2000
FILE NAME: SHT641.dwg	SCALE: 1" = 50'
CHECKED:	SHEET NO. 641
APPROVED:	