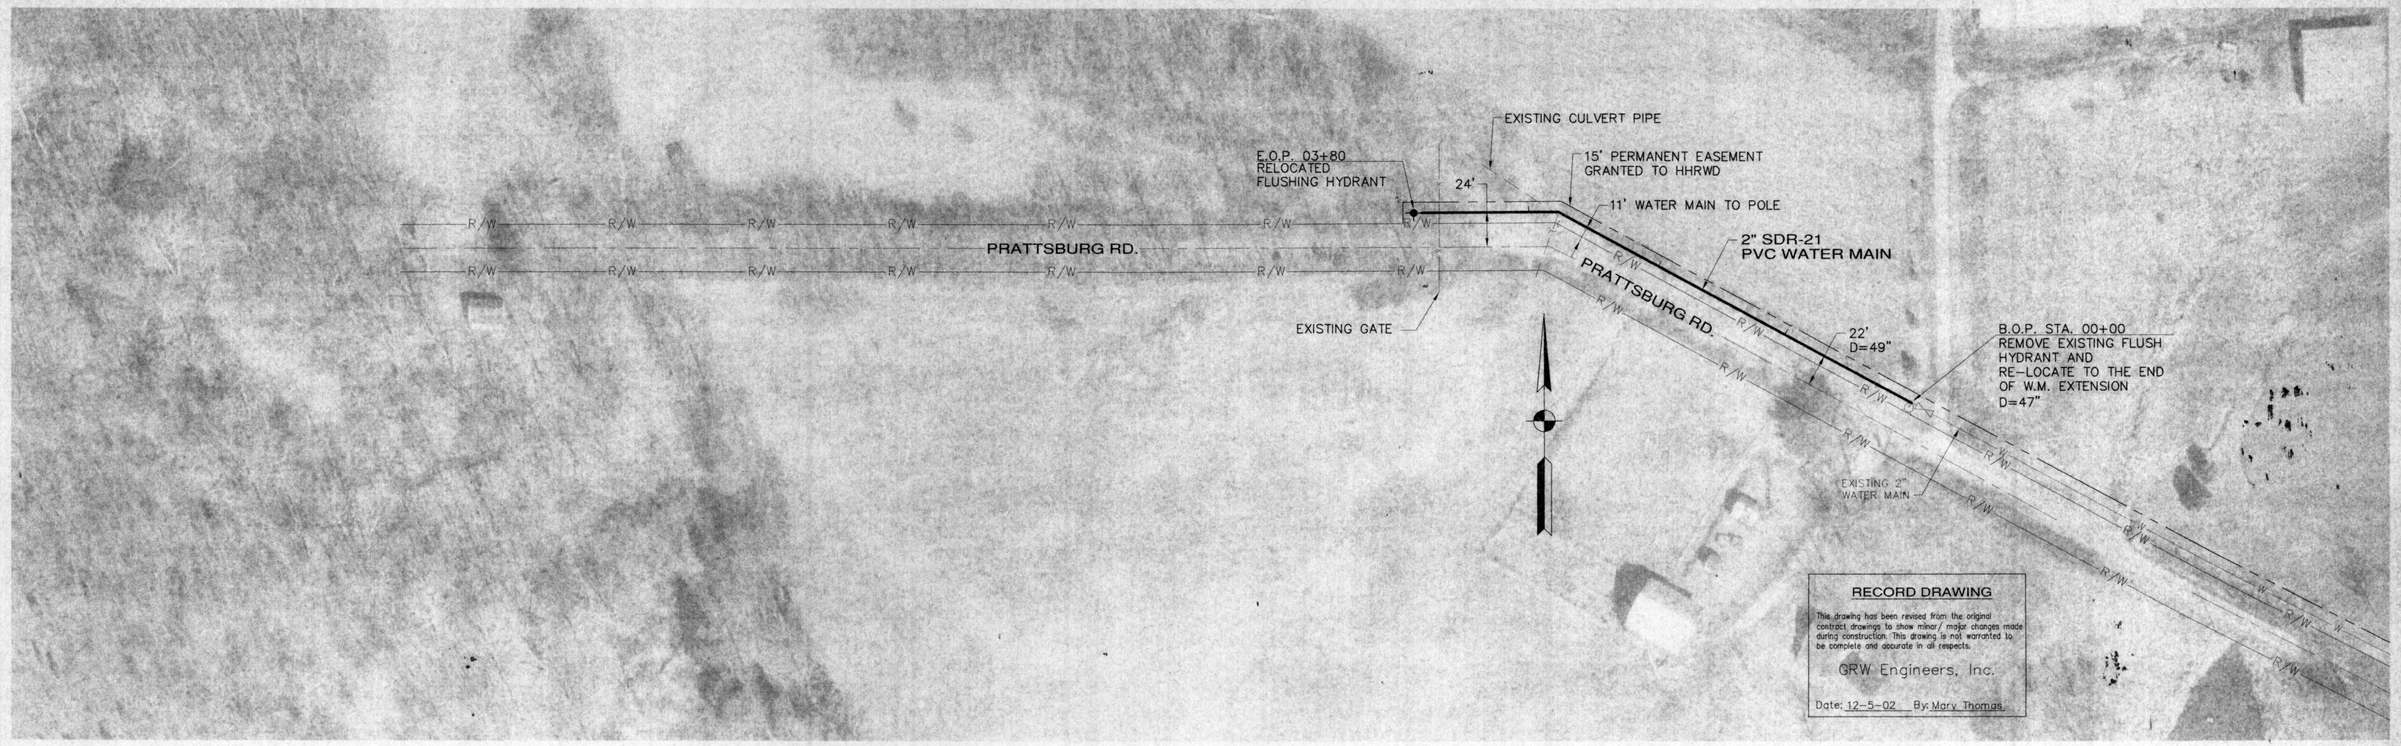


NOTES:

| NO. | DESCRIPTION | DATE | BY |
|---|---|---|---|
| 1 | REVISED PER ASBUILT DRAWINGS | 10-30-02 | MAT |

REVISIONS

HOOSIER HILLS REGIONAL
WATER DISTICT

PRATTSBURG ROAD EXTENSION

GRW PROJECT NO. 2543-50

GREGORY A. WRIGHT
REGISTERED
No.
19300607
STATE OF
INDIANA
PROFESSIONAL ENGINEER

GRW Engineers, Inc.
Engineers, Architects, Planners
INDIANAPOLIS, INDIANA
LOUISVILLE & LEXINGTON, KENTUCKY
CINCINNATI, OHIO
NASHVILLE, TENNESSEE
ARLINGTON, TEXAS

| | |
|---|---|
| DRAWN: SW | DATE: JUNE 2001 |
| FILE NAME: SHEET1.DWG | SCALE: 1" = 50' |
| CHECKED: | SHEET NO. 1 |
| APPROVED: GW | |