


PROPERTY OWNERS

- | | |
|---------------------|------------------------|
| 1. DAVID STOLL | 25. CHARLES HUDDLESTON |
| 2. RON SCHUTTE | 26. JIM UTTER |
| 3. PAUL BRUNS | 27. ED GEBHART |
| 4. LARRY SCHAUFERT | 28. PAUL PEARL |
| 5. JACK REDDINGTON | 29. MIKE WOODRY |
| 6. DENNIS ROSS | 30. JIM BENZ |
| 7. DAVID RAY | 31. JOHN MEYERS |
| 8-17. JAS RUPEL | 32-33. KAIL KETTEREB |
| 18. WM. RUEHL | 34. RICH SCHOENBERGER |
| 19. RICK WILLIAMS | 35. RAY KATHMAN |
| 20. WIL HUBBARD | 36. GERRY PFEFFINGER |
| 21. ROGER ANDERSON | 37. STEVE UTTER |
| 22. JOHN KOOISTRA | 38. HAROLD BAXTER |
| 23. DAWSON NEAL | 39. JOHN GREEN |
| 24. DONNA SCHREIBER | |

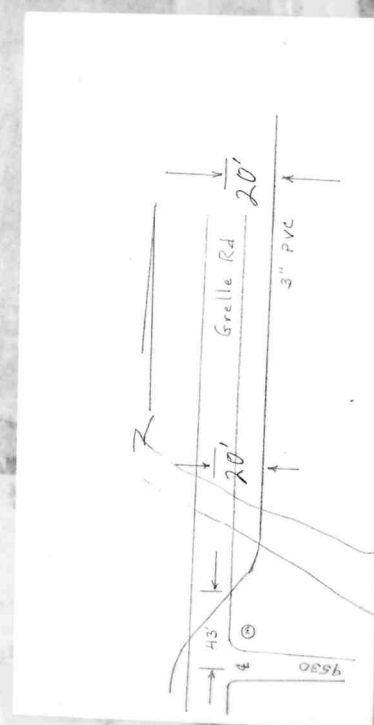

Note: Marker
Tape buried
with main

SCALE 1" = 400'

Robert E. Curry & Associates, Inc.
Engineers and Architects
3346 Avon Road, Plainfield, IN 46168
(317)-272-3050

ELROD WATER COMPANY, INC.

PRELIMINARY DRAWINGS
NOT FOR CONSTRUCTION

DATE 11/22/89

DISTRIBUTION SYSTEM ADDITION

WATER LINE EXTENSION &
PROPERTY OWNERS

SANGAMAW Rd.

DRAWN BY D. ELMORE

REVISION

DRAWING NUMBER

1 OF 3