


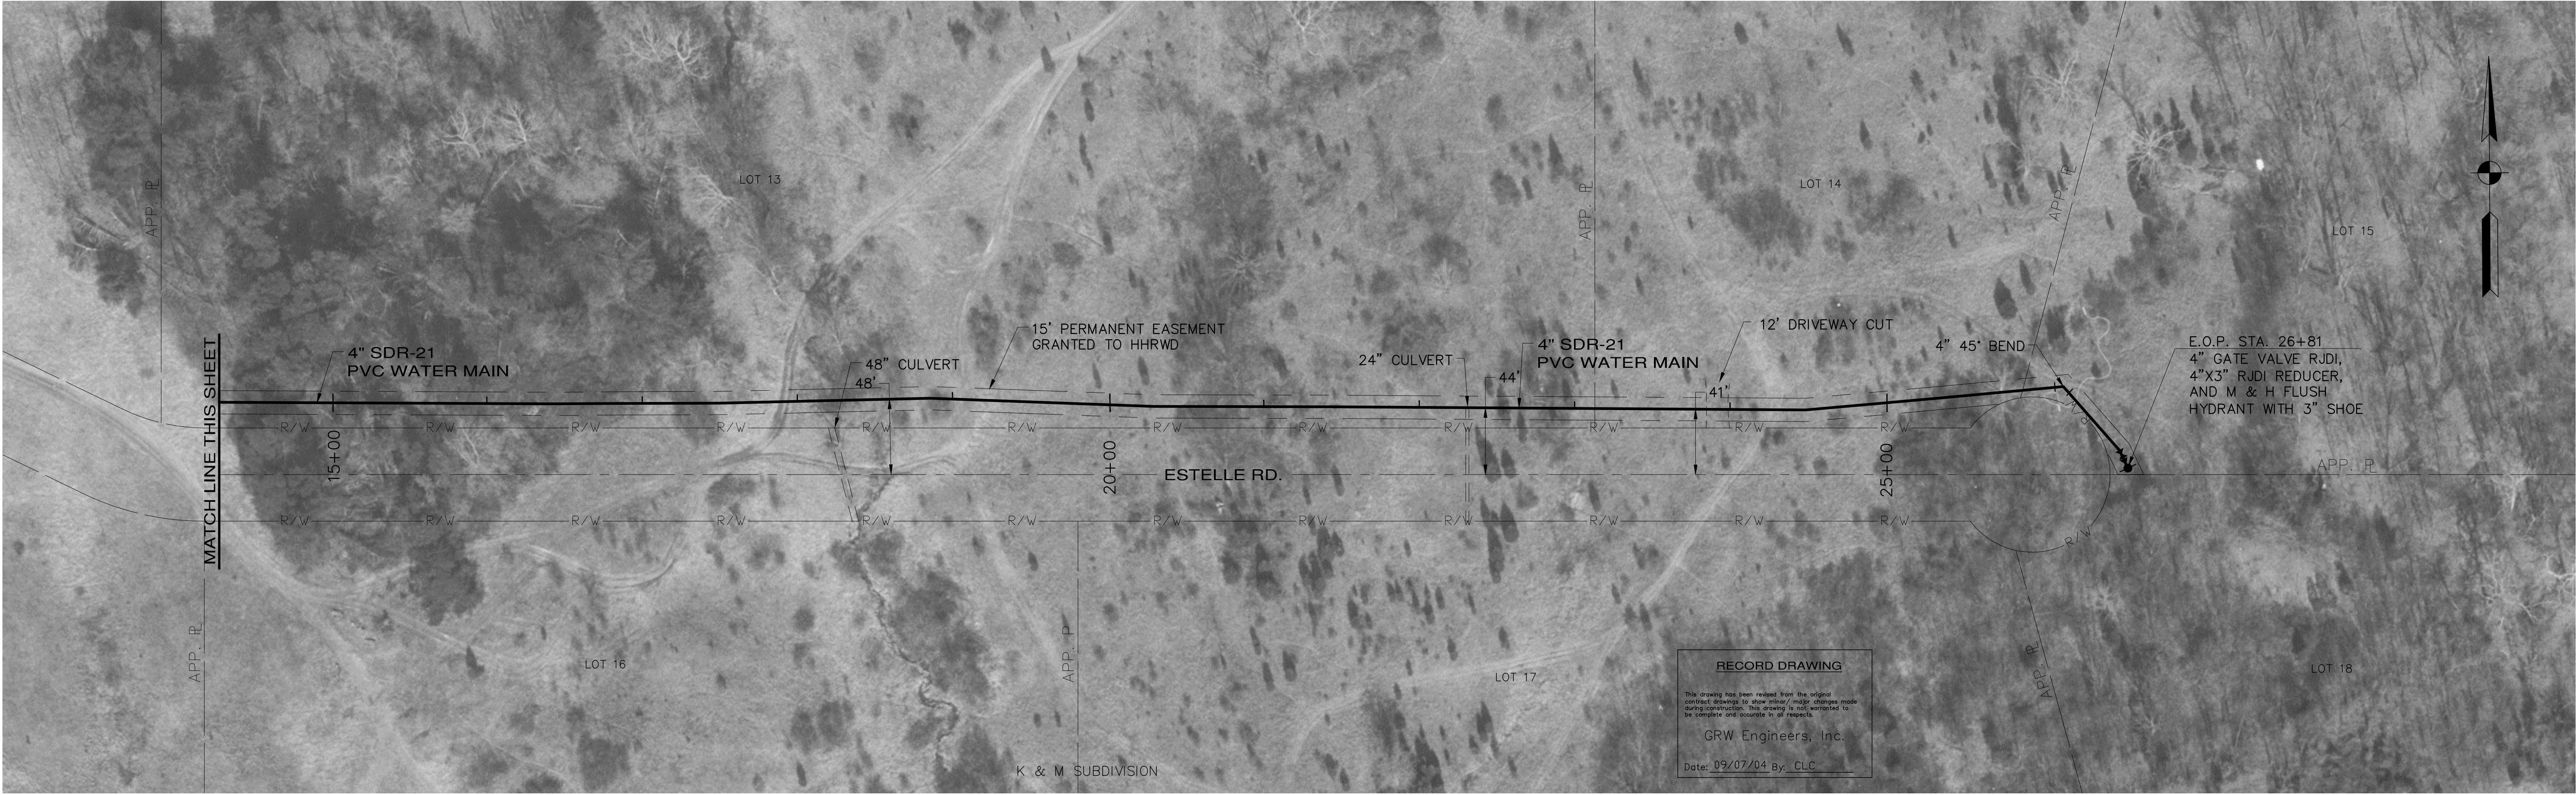


NOTES:

NO.	DESCRIPTION	DATE	BY
3	AS-BUILT	9-04	CLC
2	RENUMBERED	6-03	GCR
1	ORIGINAL PLANS JUNE 2001; RE-BID FEBRUARY 2003		

HOOSIER HILLS REGIONAL
WATER DISTRICT

STATE ROAD 129
WATER MAIN EXTENSION

GRW PROJECT NO. 2543-37

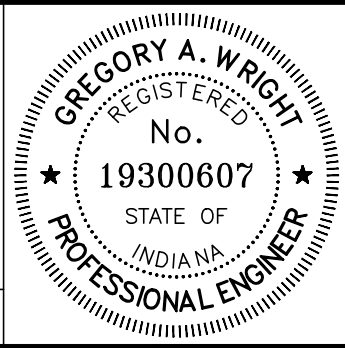


GRW Engineers, Inc.
Engineers, Architects, Planners
INDIANAPOLIS, INDIANA
LOUISVILLE & LEXINGTON, KENTUCKY
CINCINNATI, OHIO
NASHVILLE, TENNESSEE
ARLINGTON, TEXAS

DRAWN: SW	DATE: FEBRUARY 2003
FILE NAME: SHT.655.DWG	SCALE: 1" = 50'
CHECKED:	SHEET NO.
APPROVED:	655