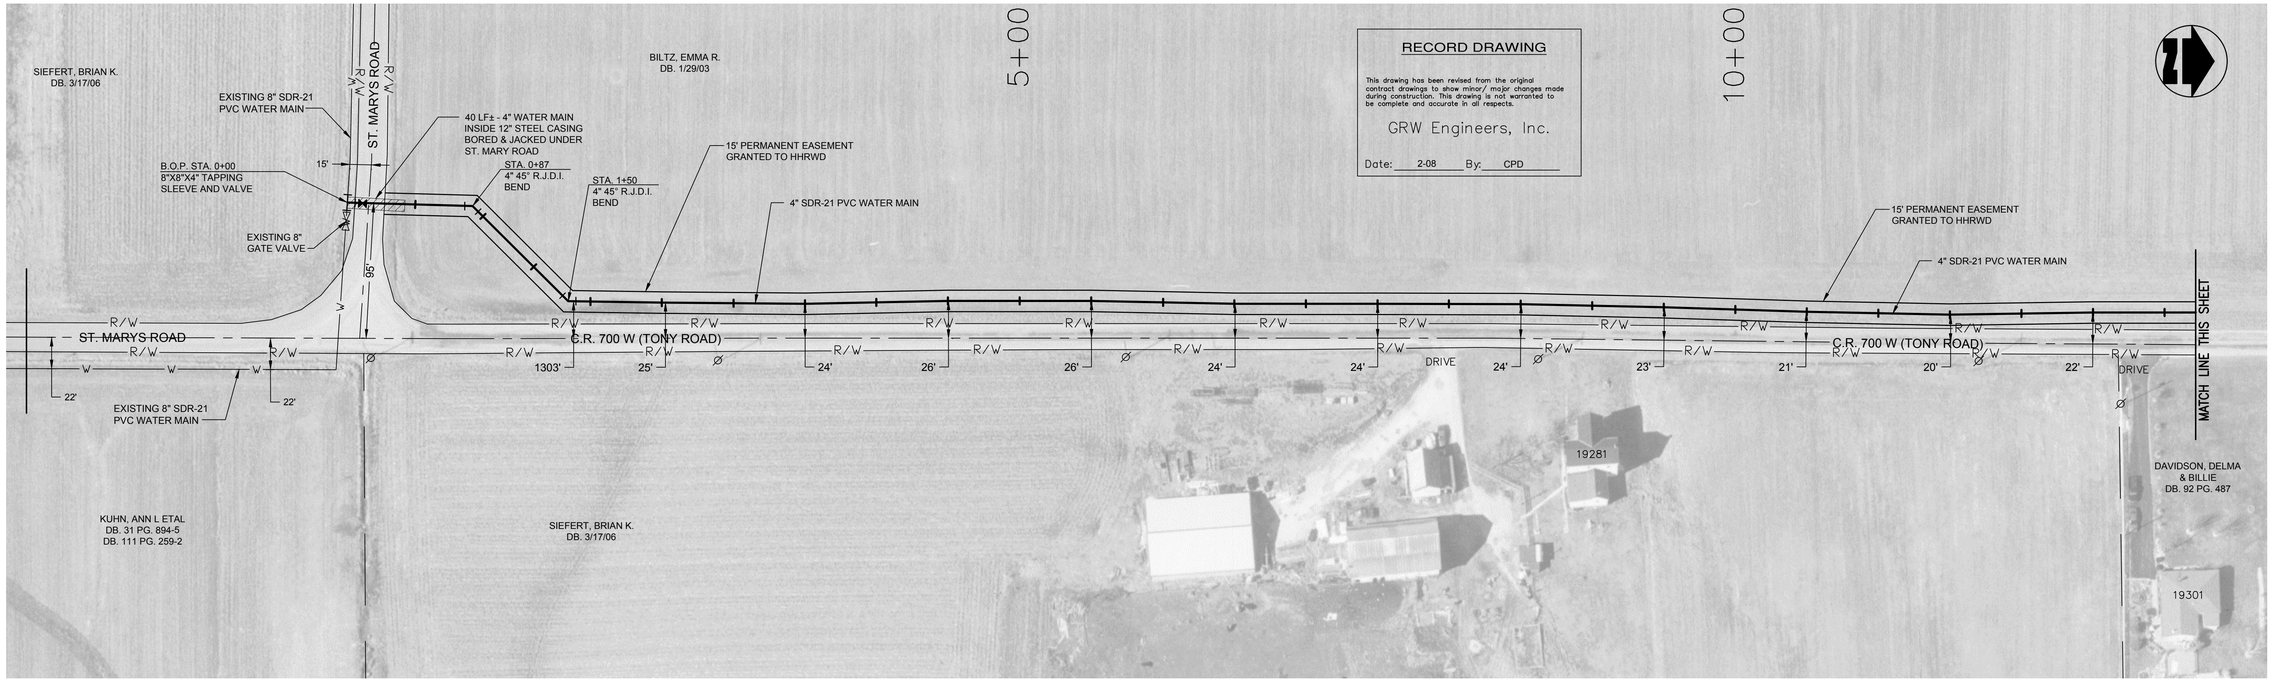

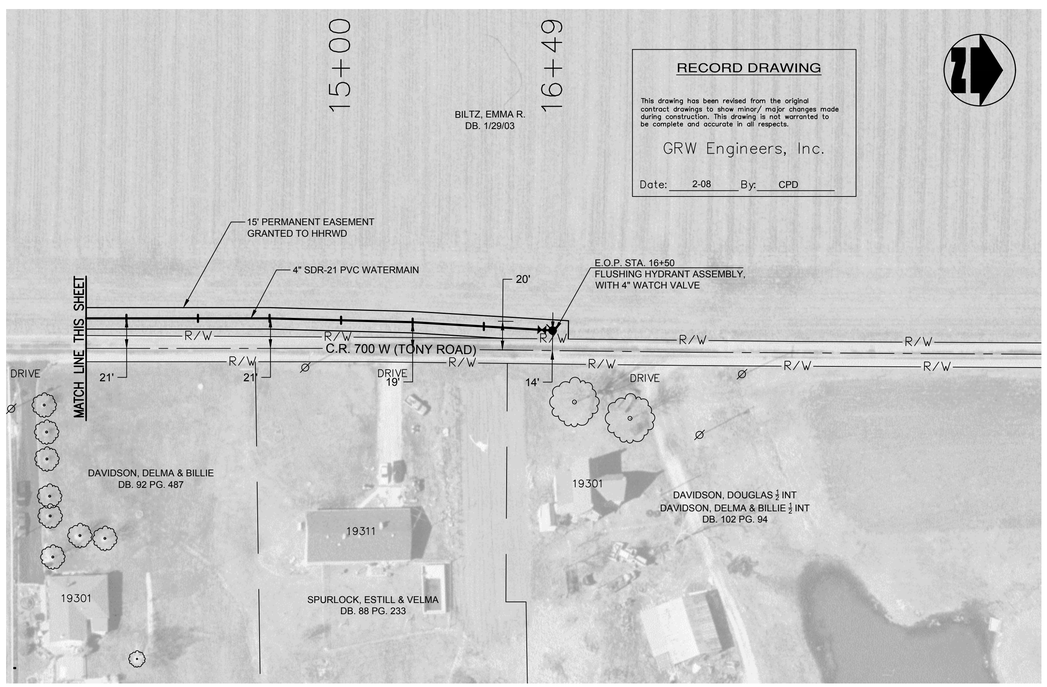

PRINTED: 3/10/2016 @ 11:10AM

FILE NAME: G:\3421-HHRWD Ann Retain\Sub-18 Tony Rd\Dwg\Design\AS-BUILT\3421-18-SHEET-724-ASBUILT.dwg

GREGORY A. WRIGHT
REGISTERED
No. 19300607
STATE OF INDIANA
PROFESSIONAL ENGINEER

GRW PROJECT NO. 3421-20

CLIENT PROJECT NO. N/A

ALL RIGHTS RESERVED
THIS DRAWING IS THE PROPERTY OF GRW ENGINEERS, INC. AND SHALL NOT BE REPRODUCED, PUBLISHED, ALTERED OR USED FOR CONSTRUCTION OF OTHER PROJECTS EXCEPT WITHOUT WRITTEN PERMISSION

ENGINEERS - ARCHITECTS - PLANNERS
www.grwinc.com

HOOSIER HILLS REGIONAL WATER DISTRICT

WEST COUNTY LINE ROAD WATER MAIN EXTENSION

DESIGNED: DRC
DRAWN: MOY
REVIEWED: DRC
APPROVED: GAW

REVISIONS

NO.	DESCRIPTION	DATE	BY
1	AS-BUILT REVISION	2-08	CPD

SCALE CHECK: THIS MARK SHOULD MEASURE EXACTLY 1" WHEN PLOTTED

DATE: JULY, 2008

SCALE: 1" = 50'

SHEET NO. 724