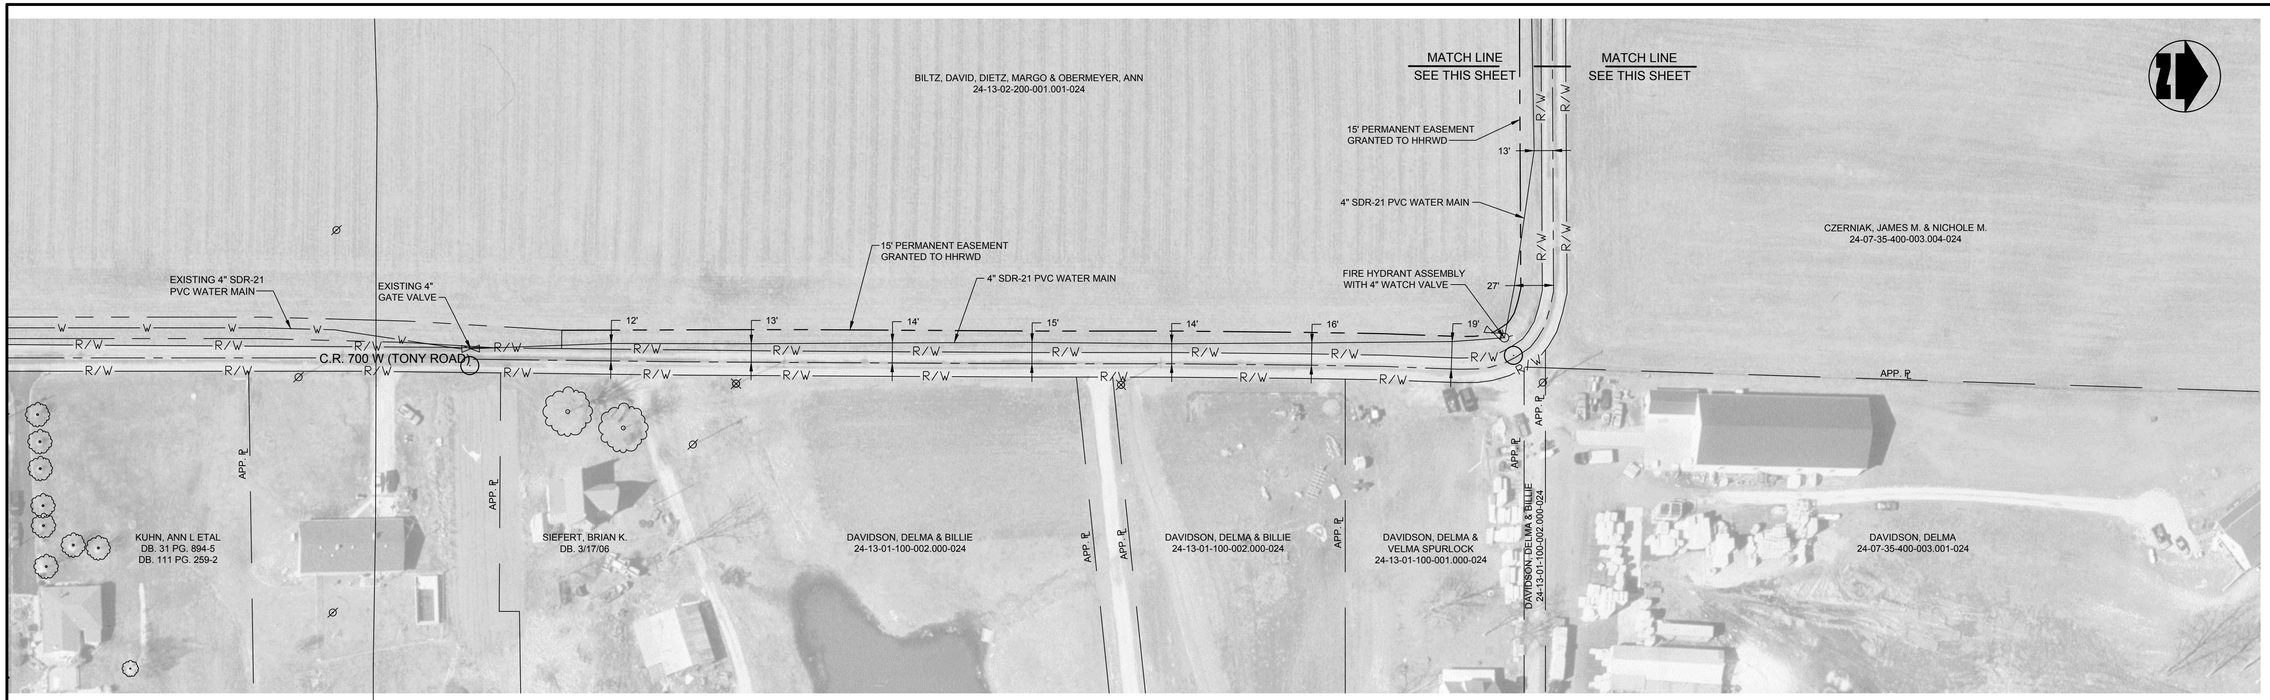

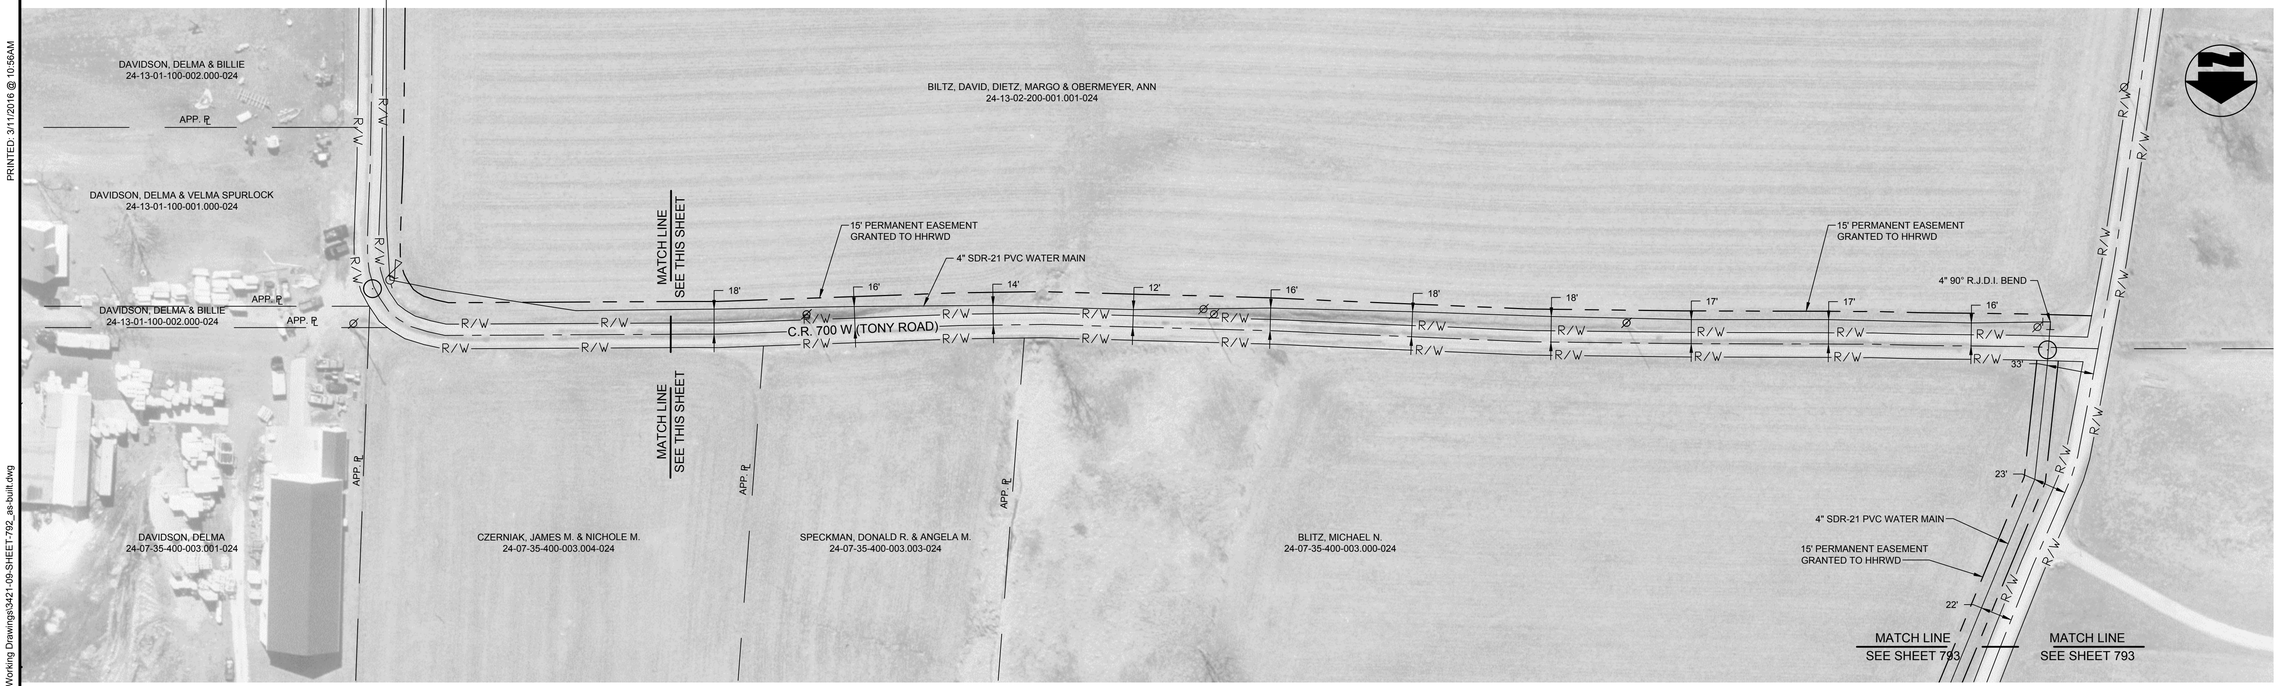

PRINTED: 3/11/2016 @ 10:56AM

FILE NAME: G:\3421-HHRWD Ann Retain\Sub.09 Tony Rd\Working Drawings\3421-09-SHEET-792_as-built.dwg

DANIEL R. CUTSHAW
REGISTERED
No. 11200431
STATE OF INDIANA
PROFESSIONAL ENGINEER

BID SET

GRW PROJECT NO. 3421-09

CLIENT PROJECT NO.

ALL RIGHTS RESERVED
THIS DOCUMENT IS THE PROPERTY OF GRW ENGINEERS, INC. AND SHALL NOT BE REPRODUCED IN WHOLE OR IN PART OR PROVIDED TO ANY PERSON OR OTHER THAN THIS SPECIFIC PROJECT WITHOUT WRITTEN PERMISSION

ENGINEERS - ARCHITECTS - PLANNERS
www.grwinc.com

TONY ROAD WATER MAIN EXTENSION

HOOSIER HILLS REGIONAL WATER DISTRICT

DESIGNED: DRC
DRAWN: GCR
REVIEWED: RAM
APPROVED: DRC

REVISIONS

NO.	DESCRIPTION	DATE	BY

SCALE CHECK: THIS MARK SHOULD MEASURE EXACTLY 1" WHEN PLOTTED

DATE: NOVEMBER 2012

SCALE: 1" = 50'

SHEET NO. 792