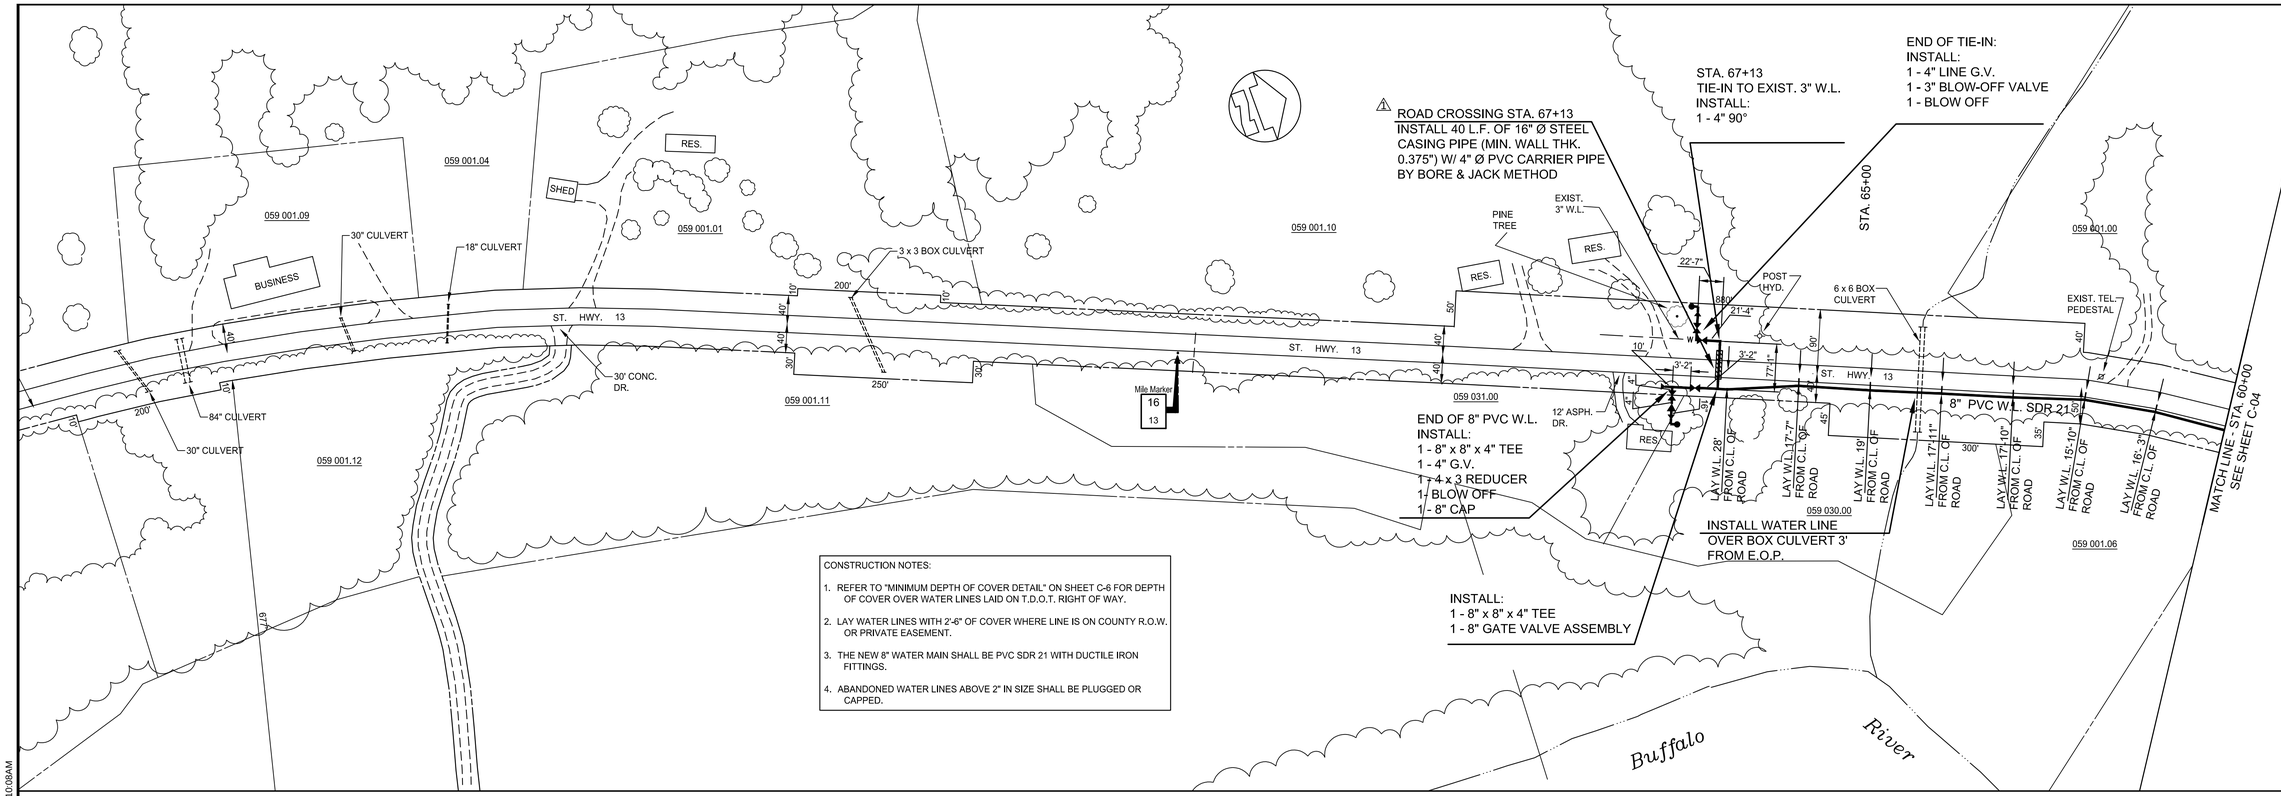

CONSTRUCTION NOTES:

1. REFER TO "MINIMUM DEPTH OF COVER DETAIL" ON SHEET C-6 FOR DEPTH OF COVER OVER WATER LINES LAID ON T.D.O.T. RIGHT OF WAY.
2. LAY WATER LINES WITH 2'-6" OF COVER WHERE LINE IS ON COUNTY R.O.W. OR PRIVATE EASEMENT.
3. THE NEW 8" WATER MAIN SHALL BE PVC SDR 21 WITH DUCTILE IRON FITTINGS.
4. ABANDONED WATER LINES ABOVE 2" IN SIZE SHALL BE PLUGGED OR CAPPED.

0 50' 100' 200' 300'

1" = 100'-0"

THIS RECORD DOCUMENT HAS BEEN PREPARED BASED ON INFORMATION PROVIDED BY THE CONSTRUCTION CONTRACTOR. GRW ENGINEERS, INC. HAS ATTEMPTED TO VERIFY THE ACCURACY AND/OR COMPLETENESS OF THIS INFORMATION BUT SHALL NOT BE RESPONSIBLE FOR ANY ERRORS OR OMISSIONS WHICH MAY BE INCORPORATED HEREIN AS A RESULT.

GRW Engineers, Inc.
Engineers, Architects, Planners
DESIGNED DRAWN CHECKED APPROVED
JWH SG JWH JWH

ENGINEER'S REPRESENTATIVE: Cody Maine
CONSTRUCTION COMPANY: GRAVES AND GRAVES CONST.
DATE: 04/08/2013

CALL BEFORE YOU DIG

IT IS THE CONTRACTORS RESPONSIBILITY TO CONTACT UTILITY COMPANIES PRIOR TO ANY CONSTRUCTION. THE LOCATION OF UTILITIES SHOWN ON THESE PLANS ARE APPROXIMATE AND POSSIBLY INCOMPLETE, THEREFORE CERTIFICATION TO THE LOCATION OF ALL UNDERGROUND UTILITIES IS WITHHELD.

IN TENNESSEE DIAL 811
OR 1-800-351-1111
THREE WORKING DAYS BEFORE YOU DIG

This document, originally issued, sealed, and signed by JAMES W. HILBORN, Tennessee Professional Engineer, No. 16514, on 4-08-2013, shall not be used in lieu of a certified document.

STATE SUBMITTAL

GRW PROJECT NO. 3827-03

CLIENT PROJECT NO. ____

ALL RIGHTS RESERVED:
THIS DOCUMENT IS THE PROPERTY OF GRW ENGINEERS, INC. AND SHALL NOT BE REPRODUCED IN WHOLE OR IN PART OR USED FOR ANY PURPOSE OR PROJECT OTHER THAN THIS SPECIFIC PROJECT WITHOUT WRITTEN PERMISSION

GRW

ENGINEERS - ARCHITECTS - PLANNERS
www.grwinc.com

ST. HWY. 13 - 8" PVC WATER LINE
STA. 60+00 TO STA. 67+20 E.O.L.
WATER LINE INTERCONNECTION
CITY OF LOBELVILLE, TENNESSEE

REVISIONS

NO	DESCRIPTION	DATE	BY
1	CHANGED 10" CASING TO 16" & INCREASED MIN. WALL THICKNESS TO 0.375"	1/4/12	DM

SCALE CHECK: THIS MARK SHOULD MEASURE EXACTLY 1" WHEN PLOTTED

DESIGNED: JWH
DRAWN: SG
REVIEWED: JWH
APPROVED: JWH

DATE: OCTOBER 2010

SCALE: AS NOTED

SHEET NO. C-04

PRINTED: 4/8/2013 @ 10:08AM

FILE NAME: I:\3827-Lobelville\03-Emer Gennt\Working Drawings\Record Drawings\3827-03-C-04 Hwy 13 WL.dwg