


CONTRACTOR NOTE:
UNLESS OTHERWISE INDICATED ON THE PLANS THE 12" WATER LINE SHALL BE PLACED 3 FEET INSIDE HIGHWAY RIGHT-OF-WAY

GRAPHIC SCALE
0 50 100 200
1 inch = 100 feet

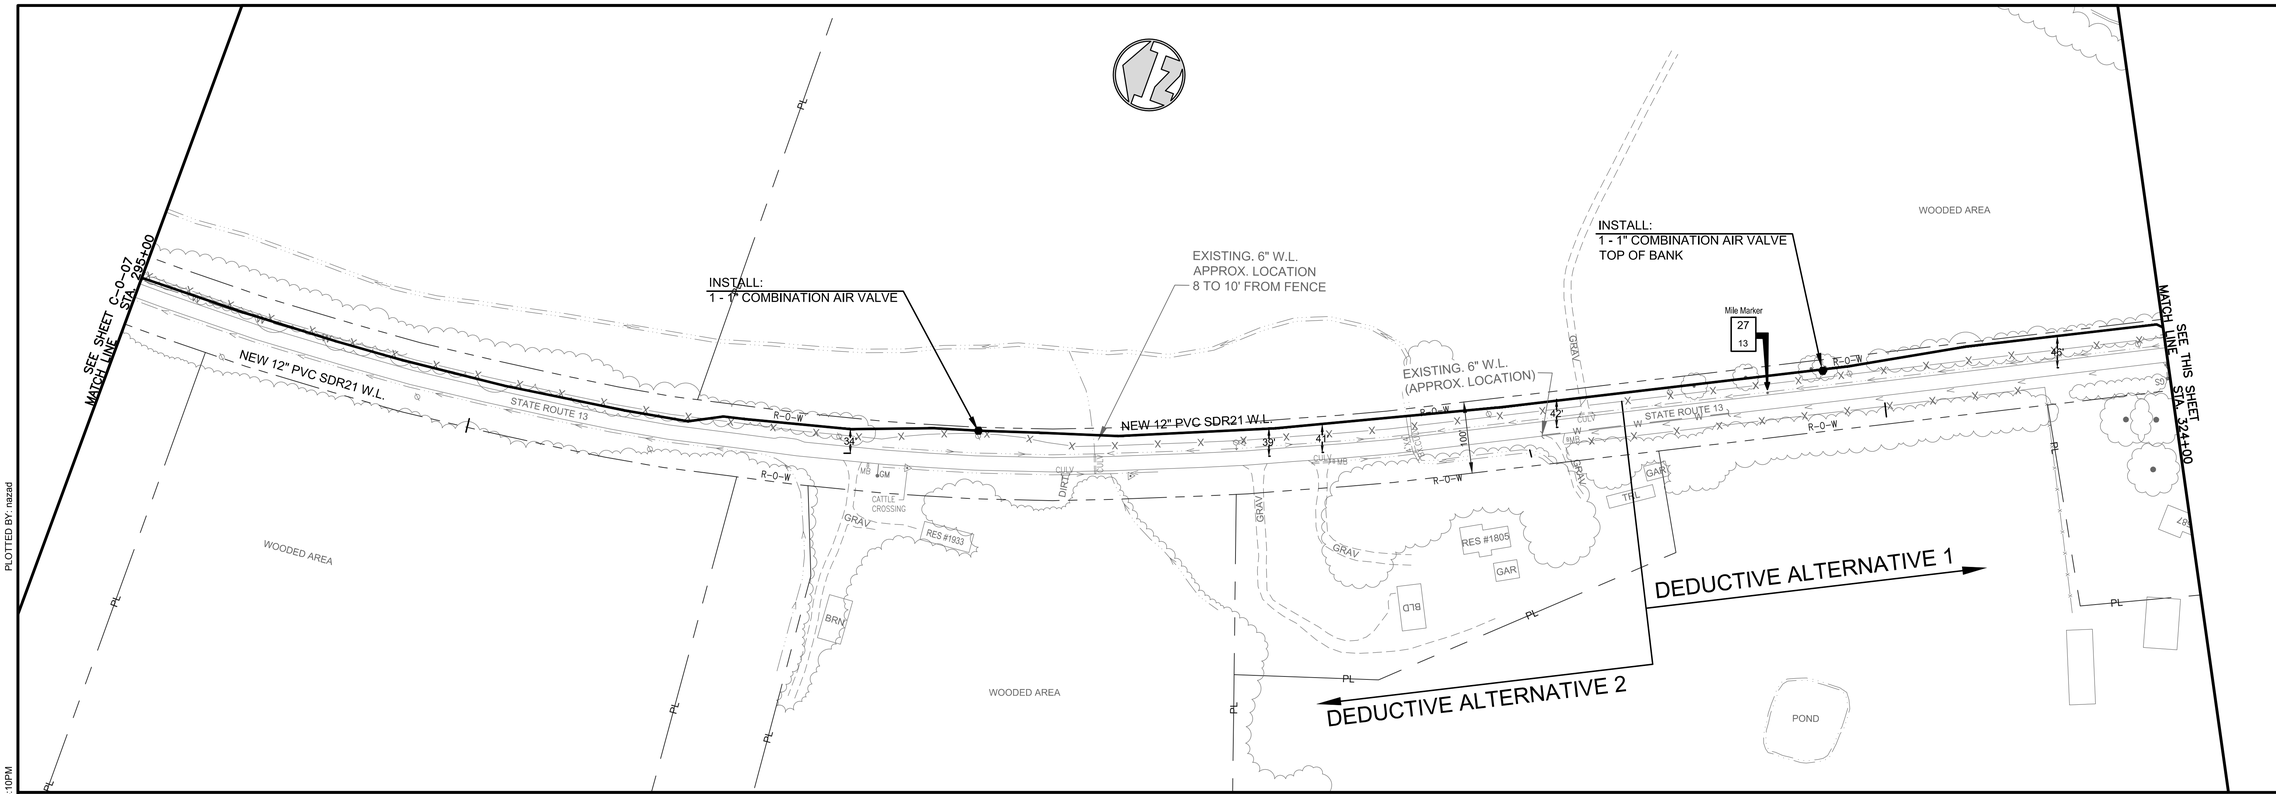


**CALL BEFORE YOU DIG**

IT IS THE CONTRACTORS RESPONSIBILITY TO CONTACT UTILITY COMPANIES PRIOR TO ANY CONSTRUCTION. THE LOCATION OF UTILITIES SHOWN ON THESE PLANS ARE APPROXIMATE AND POSSIBLY INCOMPLETE. THEREFORE CERTIFICATION TO THE LOCATION OF ALL UNDERGROUND UTILITIES IS WITHHELD.

IN TENNESSEE DIAL 811
OR 1-800-351-1111
THREE WORKING DAYS BEFORE YOU DIG

GAS TRANSMISSION MAINS CROSSING

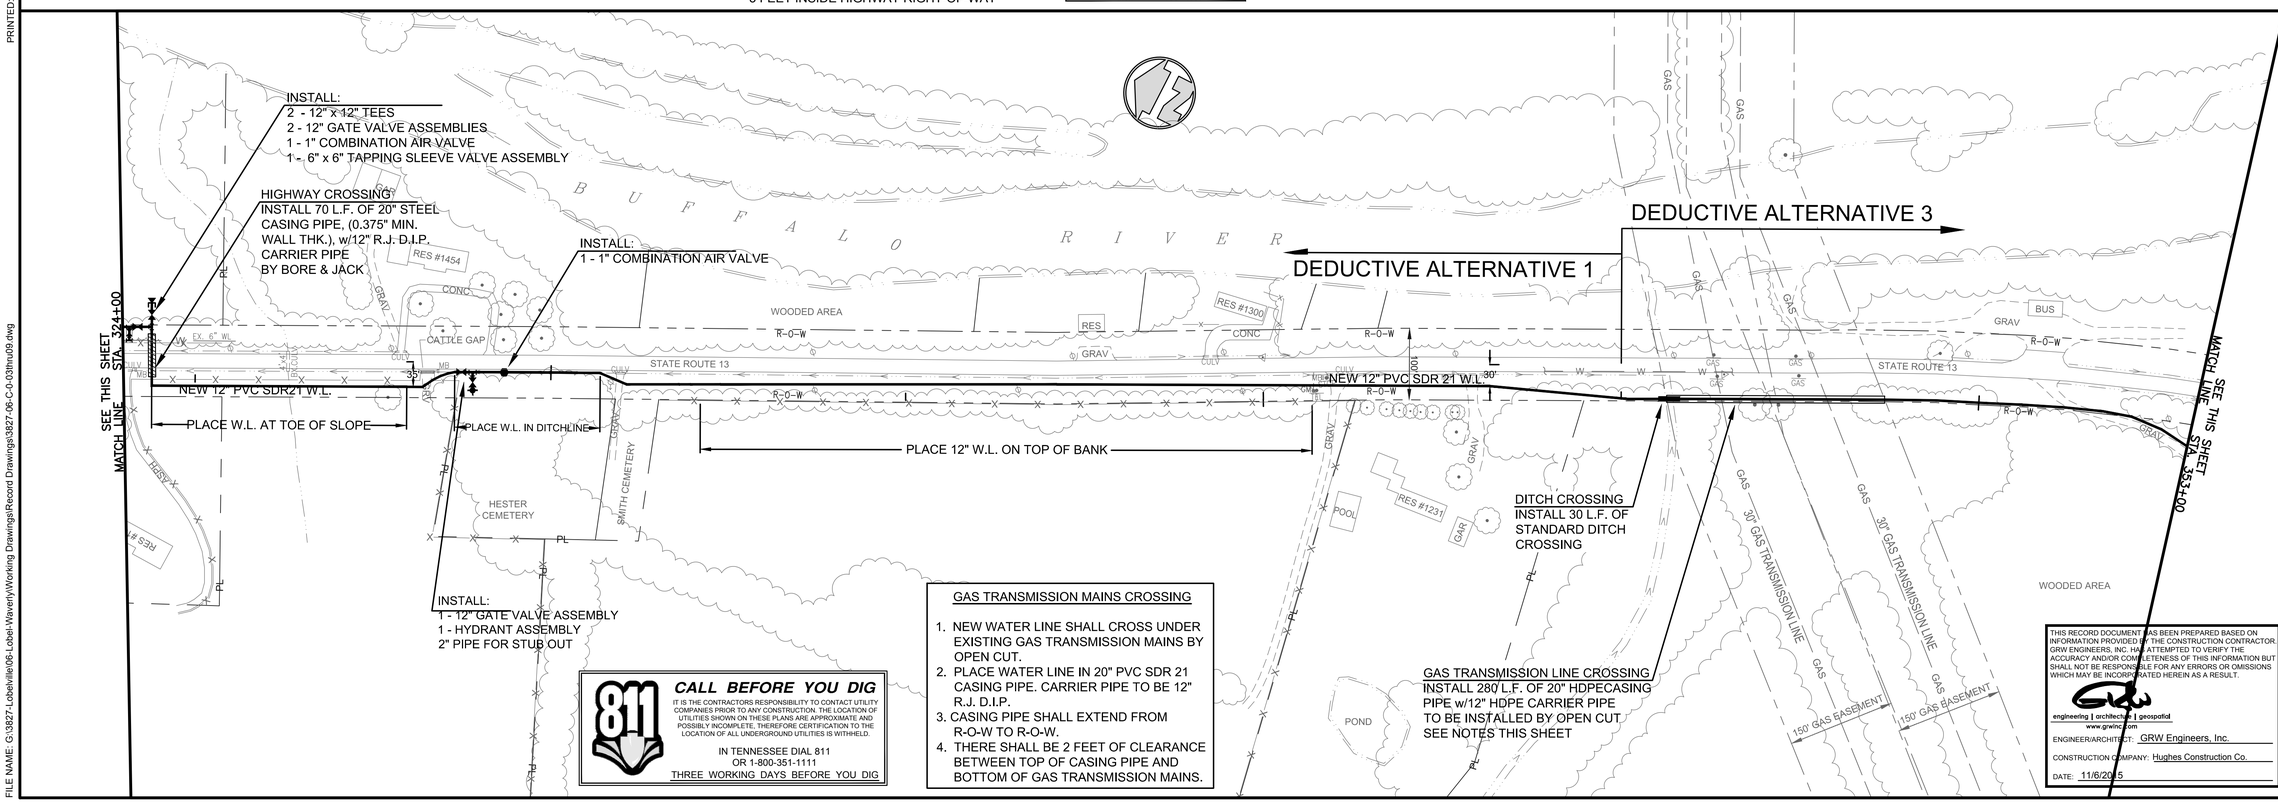1. NEW WATER LINE SHALL CROSS UNDER EXISTING GAS TRANSMISSION MAINS BY OPEN CUT.
2. PLACE WATER LINE IN 20" PVC SDR 21 CASING PIPE. CARRIER PIPE TO BE 12" R.J. D.I.P.
3. CASING PIPE SHALL EXTEND FROM R-O-W TO R-O-W.
4. THERE SHALL BE 2 FEET OF CLEARANCE BETWEEN TOP OF CASING PIPE AND BOTTOM OF GAS TRANSMISSION MAINS.

THIS RECORD DOCUMENT HAS BEEN PREPARED BASED ON INFORMATION PROVIDED BY THE CONSTRUCTION CONTRACTOR. GRW ENGINEERS, INC. HAS ATTEMPTED TO VERIFY THE ACCURACY AND/OR COMPLETENESS OF THIS INFORMATION BUT SHALL NOT BE RESPONSIBLE FOR ANY ERRORS OR OMISSIONS WHICH MAY BE INCORPORATED HEREIN AS A RESULT.

engineering | architecture | geospatial
www.grwinc.com

ENGINEER/ARCHITECT: GRW Engineers, Inc.
CONSTRUCTION COMPANY: Hughes Construction Co.
DATE: 11/6/2015

This document, originally issued, sealed, and signed by Barry L. Cloyd, Tennessee Professional Engineer, No. 100893, on JULY 2013, shall not be used in lieu of a certified document.

GRW PROJECT NO. 3827-06

ALL RIGHTS RESERVED
THIS DOCUMENT IS THE PROPERTY OF GRW ENGINEERS, INC. AND MAY NOT BE REPRODUCED IN WHOLE OR IN PART OR REPRESENTED TO ANY PERSON OR OTHER THAN THIS SPECIFIC PROJECT WITHOUT WRITTEN PERMISSION

ENGINEERS - ARCHITECTS - PLANNERS
www.grwinc.com

DESIGN DRAWINGS

# 12" WATER LINE - STA. 295+00 TO STA. 353+00

2012-D DISASTER RECOVERY EMERGENCY WATER CONNECTION IMPROVEMENTS - CONTRACT 34821
CITY OF LOBELVILLE, TENNESSEE

| DESIGNED: | DRAWN: | REVIEWED: | APPROVED: |
|---|---|---|---|
| BLC | DM | BLC | BLC |

REVISIONS

| NO. | DESCRIPTION | DATE | BY |
|---|---|---|---|
| | | | |

THIS MARK SHOULD MEASURE EXACTLY 1" WHEN PLOTTED
SCALE CHECK

DATE: JULY 2013
SCALE: 1" = 100'
SHEET NO. C-0-08

PLOTTED BY: razzd
PRINTED: 8/8/2017 @ 3:10PM
FILE NAME: G:\3827-Lobelville\06-Lobel-Waverly\Working Drawings\Record Drawings\3827-06-C-0-03thru09.dwg