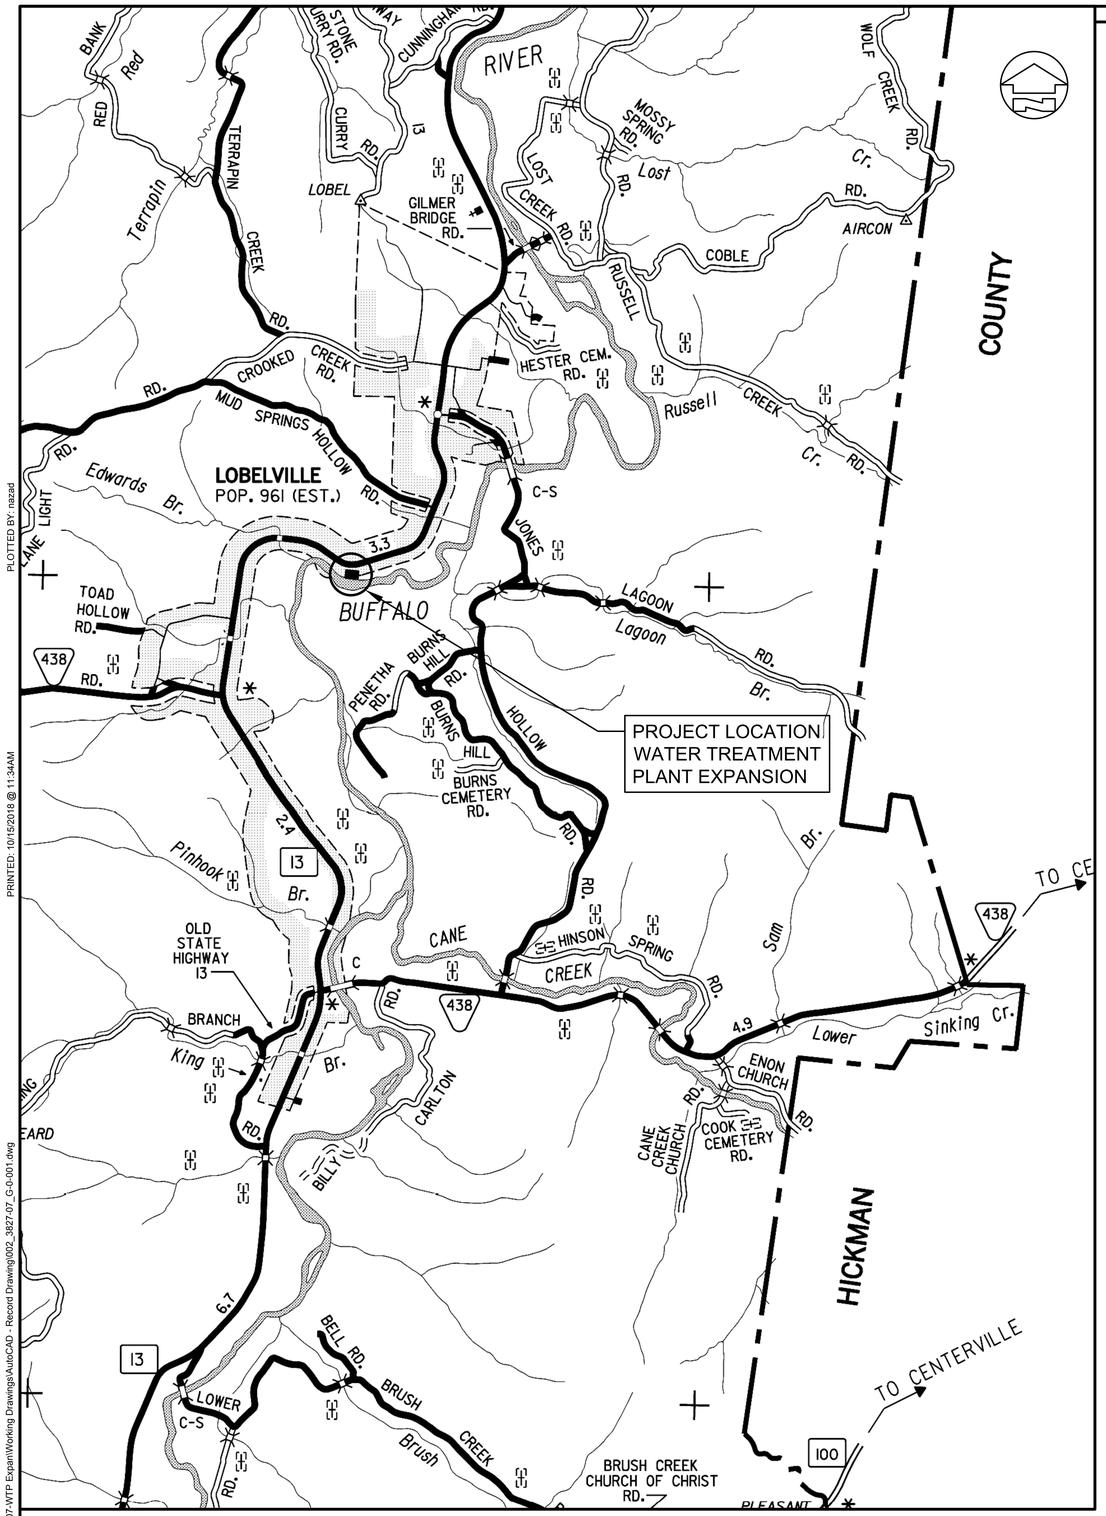

PROJECT LOCATION MAP

1 0 1 2

SCALE : 1" = 1 MILE

DWG. NO. INDEX OF DRAWINGS

DWG. NO.	INDEX OF DRAWINGS
	COVER SHEET
G-0-001	PROJECT LOCATION MAP, INDEX OF DRAWINGS
G-0-002	GENERAL NOTES, EROSION & SEDIMENT CONTROL NOTES AND LEGEND
G-0-003	STANDARD CONSTRUCTION DETAILS
G-0-004	STANDARD CONSTRUCTION DETAILS
G-0-005	STANDARD EROSION CONTROL DETAILS
C-0-101	SITE PLAN - DEMOLITION LAYOUT SITE PLAN - NEW OR MODIFIED LAYOUT
C-0-102	NEW FLASH MIX AND FLOCCULATION / SEDIMENTATION BASIN PLAN
C-1-101	EXISTING RAW WATER INTAKE STRUCTURE DEMOLITION AND MODIFICATION
C-1-102	EXISTING RAW WATER INTAKE STRUCTURE MODIFICATION - PLAN AND PROFILE
C-2-101	NEW FLASH MIX STRUCTURE - PLAN, SECTION AND DETAILS
C-3-101	EXISTING FLOCCULATION / SEDIMENTATION BASIN - DEMOLITION
C-4-301	EXISTING SEDIMENTATION FLOCCULATION BASIN - MODIFICATION, SECTION AND DETAILS
C-5-101	NEW FLOCCULATION / SEDIMENTATION BASIN - PLAN, PROFILE AND DETAILS
C-5-301	NEW FLOCCULATION / SEDIMENTATION BASIN - SECTION AND DETAILS
C-6-101	EXISTING FILTER BUILDING DEMOLITION PLAN
C-6-102	EXISTING FILTER BUILDING DEMOLITION PLAN AND DETAILS
C-6-103	CLEARWELL PLAN AND DETAILS
C-6-104	FIRST FLOOR PLAN
C-6-105	SECOND FLOOR PLAN
C-6-106	ROOF PLAN
C-6-201	FILTER BUILDING EXTERIOR ELEVATIONS
C-6-301	FILTER BUILDING SECTIONS AND DETAILS
C-6-302	FILTER BUILDING SECTIONS AND DETAILS
C-6-501	FILTER BUILDING WINDOW, DOOR AND WALL DETAILS
C-6-502	FILTER BUILDING MISCELLANEOUS DETAILS FLASH MIX MISCELLANEOUS DETAILS
C-6-601	ROOM FINISH - DOOR & FRAME - WINDOW - FILTER CONTROL VALVES SCHEDULE
S-0-001	STRUCTURAL GENERAL NOTES
S-0-002	STRUCTURAL TYPICAL SECTIONS & DETAILS
S-2-101	NEW FLASH MIX / SPLITTER BOX FOUNDATION PLANS
S-2-301	NEW FLASH MIX / SPLITTER BOX STRUCTURAL SECTIONS
S-5-101	NEW FLOCULATION / SEDIMENTATION BASIN FOUNDATION PLANS
S-5-301	NEW FLOCULATION / SEDIMENTATION BASIN STRUCTURAL SECTION
S-5-302	NEW FLOCULATION / SEDIMENTATION BASIN STRUCTURAL SECTIONS
S-6-101	FILTER BUILDING ADDITION FOUNDATION PLANS
S-6-301	FILTER BUILDING ADDITION STRUCTURAL SECTIONS
S-6-302	FILTER BUILDING ADDITION STRUCTURAL SECTIONS

DWG. NO.	INDEX OF DRAWINGS
E-0-101	SITE PLAN - ELECTRICAL MODIFICATIONS
E-0-102	NEW FLASH MIX AND FLOCCULATION / SEDIMENTATION BASINS ELECTRICAL MODIFICATIONS
E-1-101	EXISTING RAW WATER INTAKE STRUCTURE ELECTRICAL DEMOLITION AND MODIFICATIONS PLANS
E-6-101	EXISTING FILTER BUILDING ELECTRICAL DEMOLITION PLANS
E-6-102	FILTER BUILDING FIRST FLOOR ELECTRICAL MODIFICATIONS PLAN
E-6-103	FILTER BUILDING SECOND FLOOR ELECTRICAL MODIFICATIONS PLAN
E-6-601	ELECTRICAL PANEL SCHEDULES AND RISER DIAGRAM
E-6-602	MOTOR CONTROL CENTER "MCC" ONE-LINE DIAGRAM & LAYOUT
E-6-603	ELECTRICAL SCHEMATICS
E-6-604	ELECTRICAL DETAILS, SCHEDULES AND LEGEND

THIS RECORD DOCUMENT HAS BEEN PREPARED BASED ON INFORMATION PROVIDED BY THE CONSTRUCTION CONTRACTOR. GRW ENGINEERS, INC. HAS ATTEMPTED TO VERIFY THE ACCURACY AND/OR COMPLETENESS OF THIS INFORMATION BUT SHALL NOT BE RESPONSIBLE FOR ANY ERRORS OR OMISSIONS WHICH MAY BE INCORPORATED HEREIN AS A RESULT.

engineering | architecture | geospatial
www.grwinc.com

ENGINEER/ARCHITECT: BARRY L. CLOYD

CONSTRUCTION COMPANY: QUINN CONS CORP.

DATE: 09/27/2018

SAMPLE SHEET NUMBER	DISCIPLINE LETTER		SHEET TYPE	
DISCIPLINE LETTER STRUCTURE NUMBER SHEET TYPE SHEET NUMBER A-1-101	G	GENERAL	0	GENERAL
	C	CIVIL	1	PLANS
	S	STRUCTURAL	2	ELEVATIONS
	A	ARCHITECTURAL	3	SECTIONS
	P	PLUMBING	4	ENLARGED PLANS
	M	MECHANICAL	5	DETAILS
	E	ELECTRICAL	6	SCHEDULES & DIAGRAMS
	I	INTRUMENTATION & CONTOLS	7	PLAN & PROFILE

This document, originally issued, sealed, and signed by BARRY L. CLOYD, Tennessee Professional Engineer, No. 100893, on JUNE 2015, shall not be used in lieu of a certified document.

RECORD DRAWINGS

GRW PROJECT NO. 3827-07

CLIENT PROJECT NO.

ALL RIGHTS RESERVED
THIS DOCUMENT IS THE PROPERTY OF GRW ENGINEERS, INC. AND MAY NOT BE REPRODUCED IN WHOLE OR IN PART OR REPRODUCED FOR USE ON ANY OTHER THAN THE SPECIFIC PROJECT WITHOUT WRITTEN PERMISSION

engineering | architecture | geospatial
www.grwinc.com

PROJECT LOCATION MAP AND INDEX OF DRAWINGS

WATER TREATMENT PLANT EXPANSION
CITY OF LOBELVILLE, TENNESSEE

DESIGNED: BLC
DRAWN: SH
REVIEWED: JWH
APPROVED: BLC

REVISIONS

NO.	DESCRIPTION	DATE	BY

THIS MARK SHOULD MEASURE EXACTLY 1" WHEN PLOTTED
SCALE CHECK

DATE: JUNE 2015

SCALE: NOTED

SHEET NO. G-0-001

PLOTTED BY: razad

PRINTED: 10/15/2018 @ 11:34AM

FILE NAME: G:\3827-Lobelville\07-WTP Expan\Working Drawings\AutoCAD - Record Drawing\002_3827-07_G-0-001.dwg